


Sect. 3, T23S. R7W. W.M.
for
E. G. Whipple Mill, Drain
Scale: 1" = 400' 1960

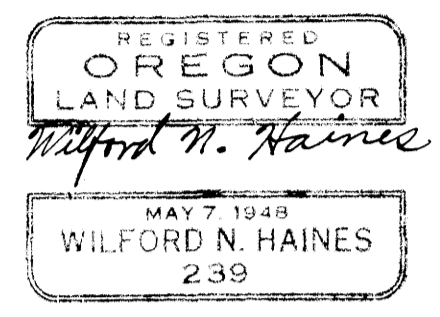

1/6 S. 2
Set 1" x 1" x 36"
T. iron
Fd. 2 B.T.s. Scribed in
survey of Sect. 2.
Cedar S 45° E 10.0 ft.
yew S 87° W 61.3 ft.
old corner was
N 86° 33' W. 38.4 ft.

1/4 S. 2 Set 1" x 1" x 36"
T. iron
Found
1" iron pipe N 86° W 64.9 ft
2 B.T.s. Scribed 1881
30" fir N 11° E. 13-1K5
18 fir S 25° E. 31.7 ft.

Note
This iron pipe was
used as the 45 2 in
subdivision of Sect.
2. (See M 11-25)

FILED RECEIVED
APR 28 1960
COUNTY SURVEYOR
DOUGLAS COUNTY, OREGON

C. Cor 1/11 is S. 4° 25' E, 670.5'

SEE C.S. 56/24

H-197 H-212 F.B. H-178 M 18-33