


# SURVEY TO ESTABLISH PROPERTY CORNERS W.W. WILLIS PROPERTY, J. YOKUM DLC N<sup>o</sup> 43 SECTION 20, T30S, R5W, W.M.

SURVEYED FOR: BECKLEY & THOMAS  
SURVEYED BY: G. R. LECKLIDER-ENG'R.

APRIL, 1960  
SCALE: 1" = 200'

COUNTY SURVEYORS FILE ONLY  
DO NOT REMOVE FROM OFFICE

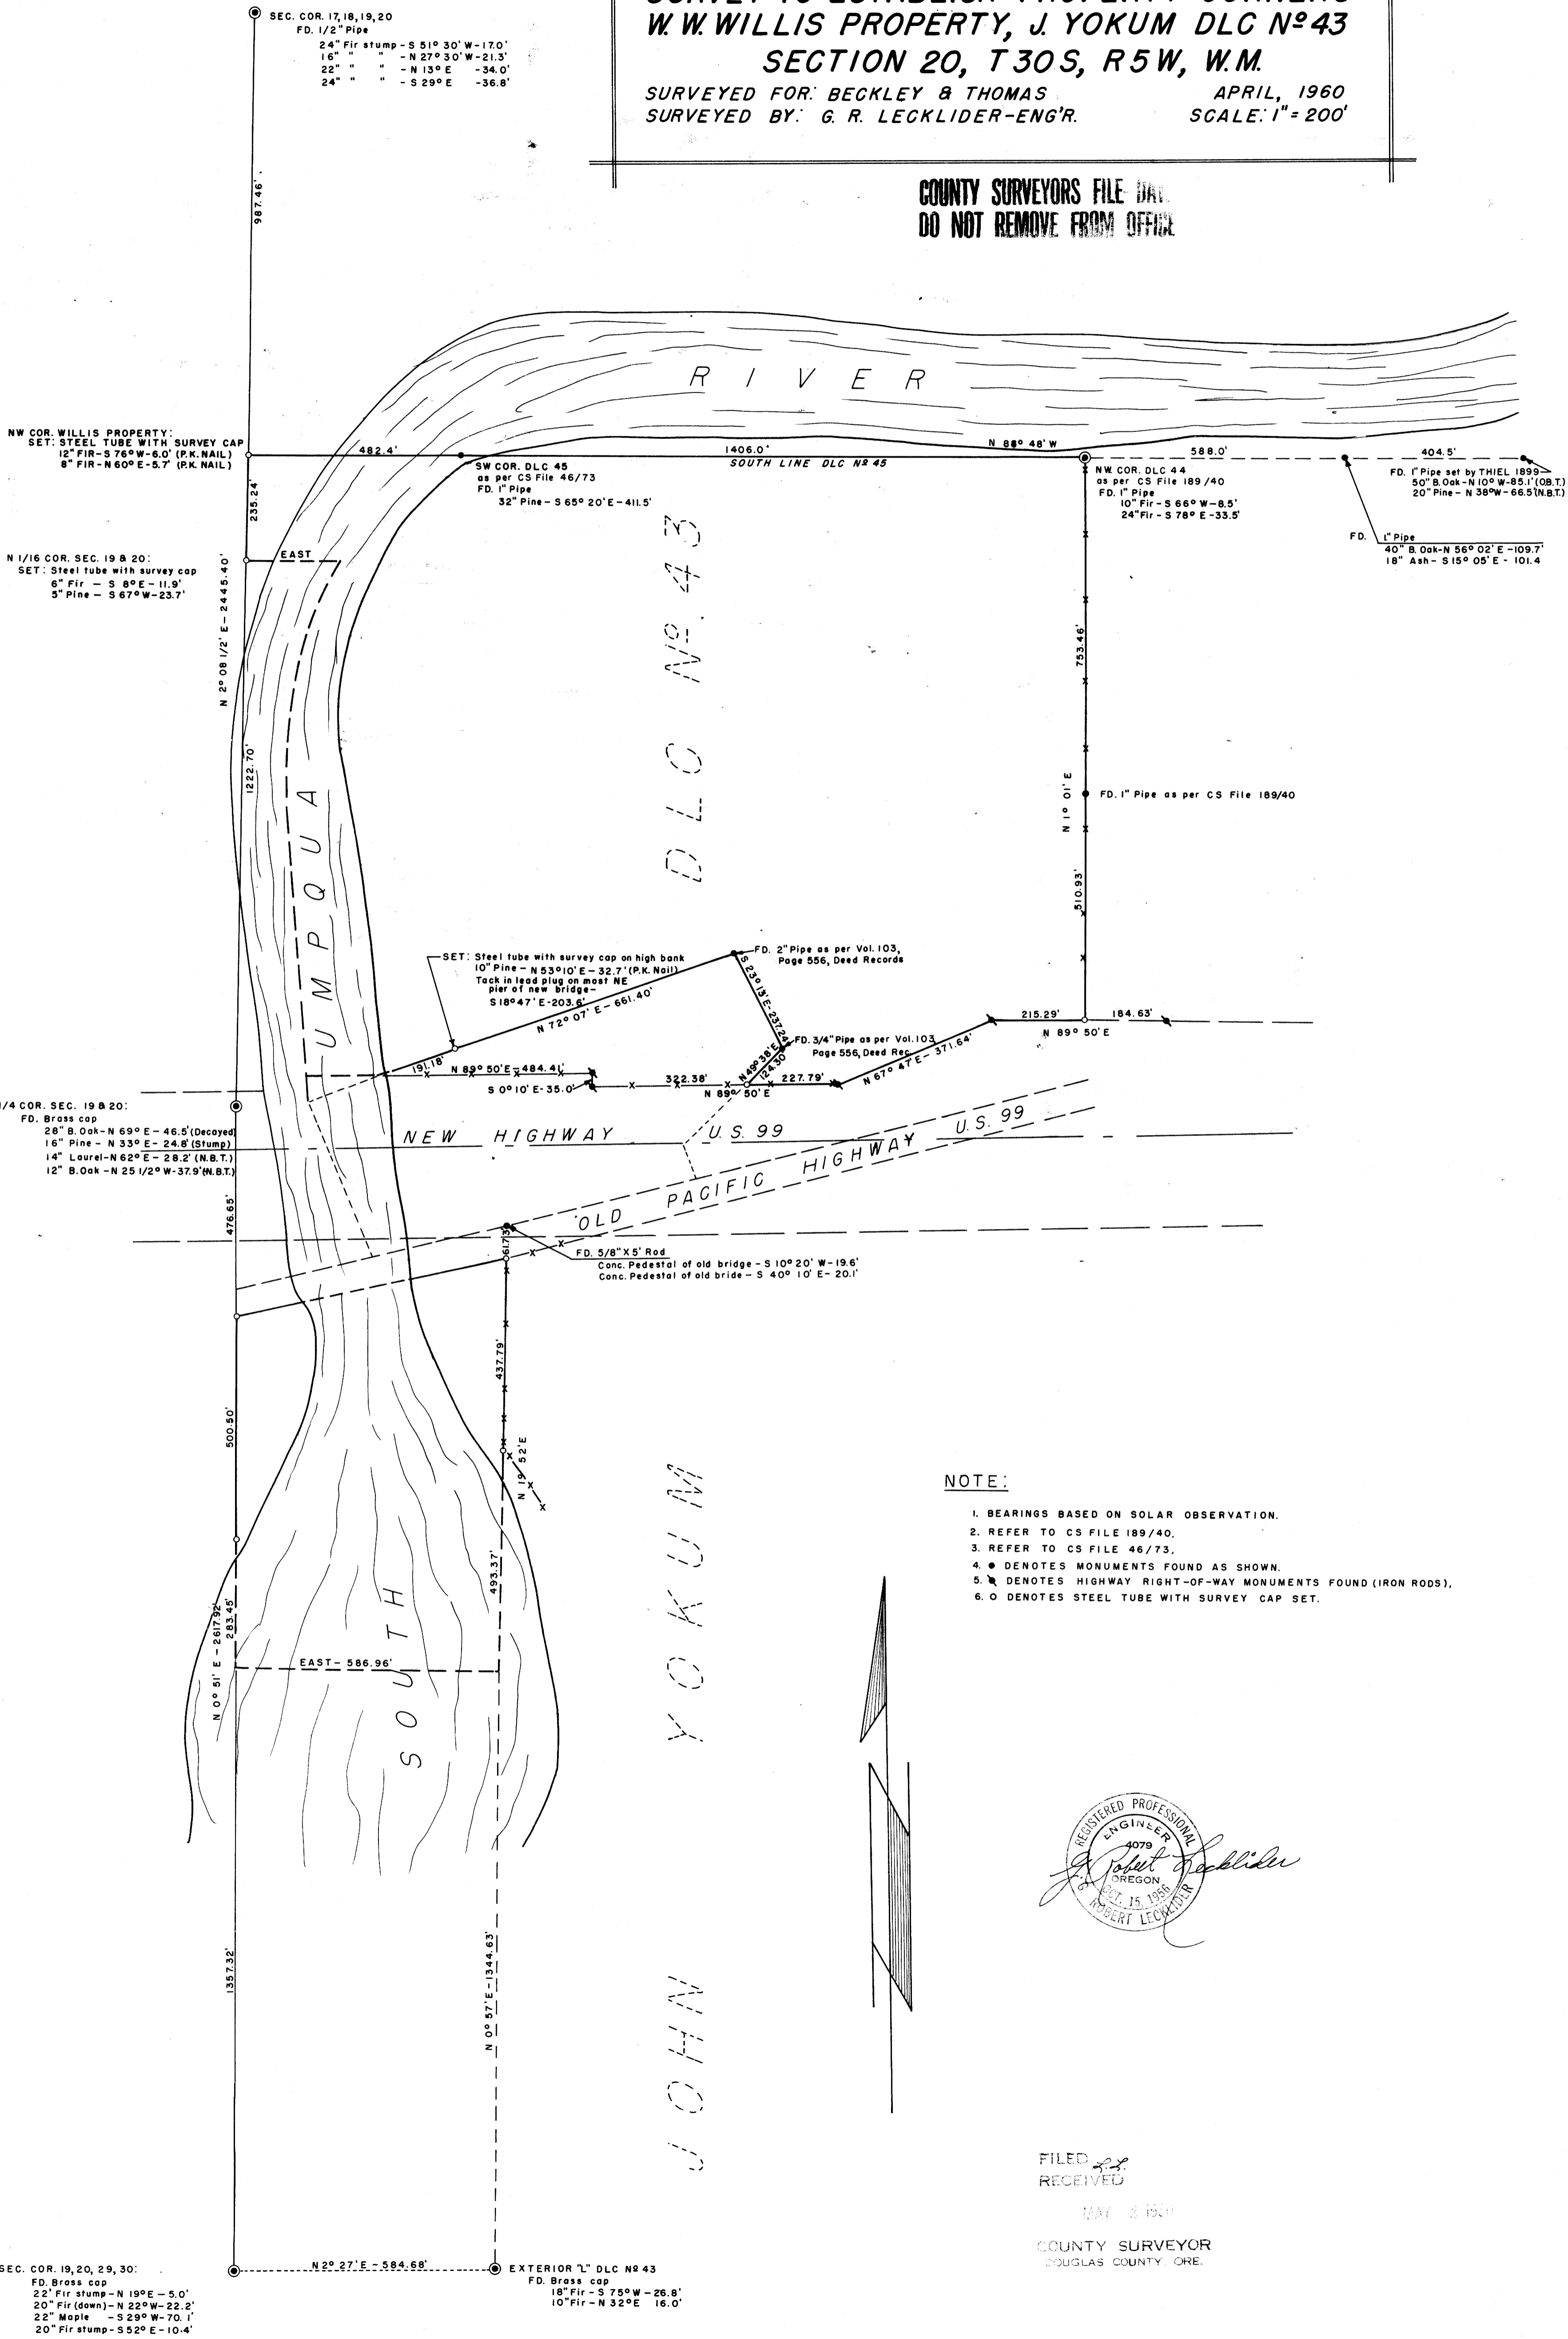

**NOTE:**

1. BEARINGS BASED ON SOLAR OBSERVATION.
2. REFER TO CS FILE 189/40.
3. REFER TO CS FILE 46/73.
4. ● DENOTES MONUMENTS FOUND AS SHOWN.
5. ⚓ DENOTES HIGHWAY RIGHT-OF-WAY MONUMENTS FOUND (IRON RODS).
6. ○ DENOTES STEEL TUBE WITH SURVEY CAP SET.



FILED  
RECEIVED  
MAY 2 1960  
COUNTY SURVEYOR  
DOUGLAS COUNTY, ORE.