


SECTION LINE PLAT


Between Sections 27 & 34 T.24 S. R.7 W. W.M.

Scale 1 in. = 500 ft.

March 1960

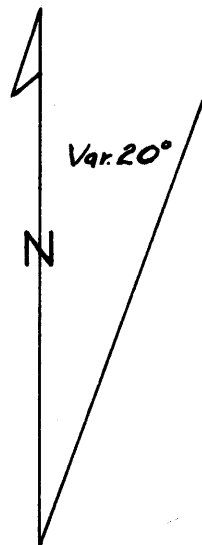

27

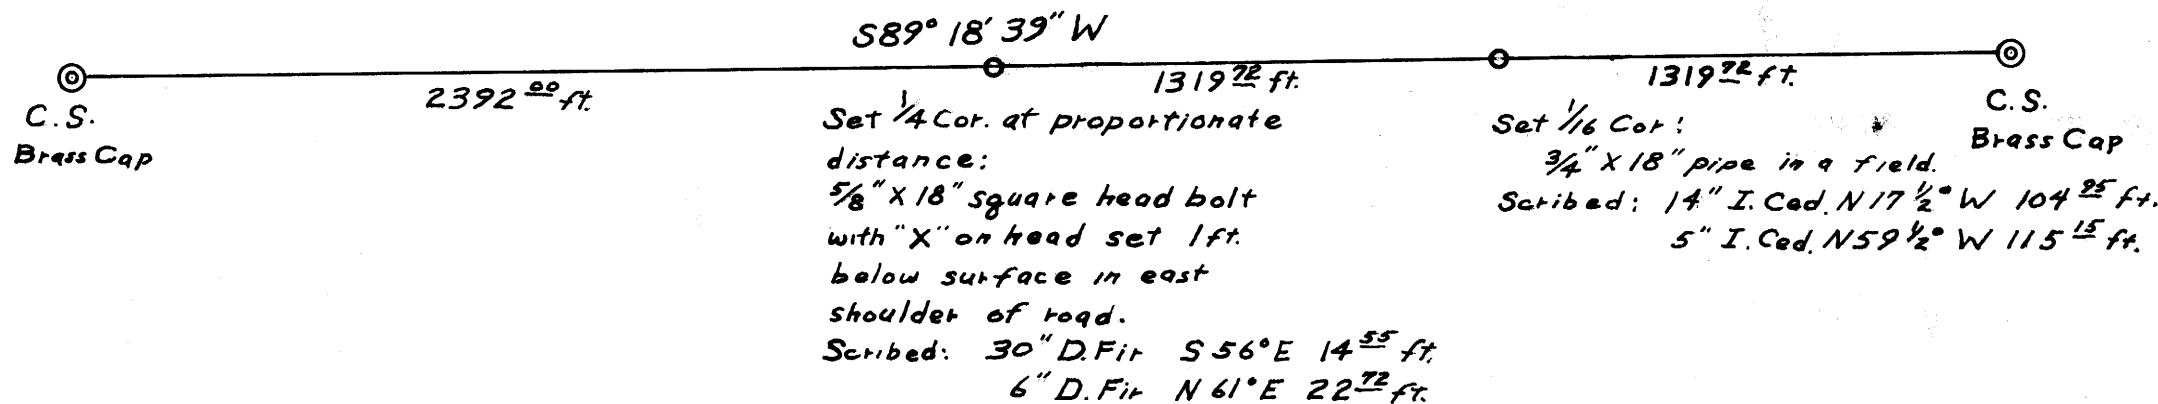

34

CERTIFICATE of SURVEYOR :

I hereby certify that this plat is based upon actual field survey, said survey having been executed by me for Roseburg Lbr. Co., that the corners so designated have been monumented on the ground and that the courses and distances shown are correct.

Dated: April, 1960

Clifford M. Beggs

FILED *by*
RECEIVED

APR 5 1960

COUNTY SURVEYOR
DEWELAS COUNTY, ORE.