



COUNTY SURVEYORS FILE DATA
DO NOT REMOVE FROM OFFICE

SURVEY TO ESTABLISH PROPERTY CORNERS IN LOTS 4, 5, & 21, JUNCTION SUBDIVISION LOCATED IN SECTION 21, T.28 S., R.6 W., W.M.

SURVEYED FOR: FRANCES ALLEN
SURVEYED BY: G. R. LECKLIDER - ENGINEER

JUNE, 1960
SCALE: 1" = 20'

○ DENOTES STEEL TUBE WITH SURVEY CAP SET

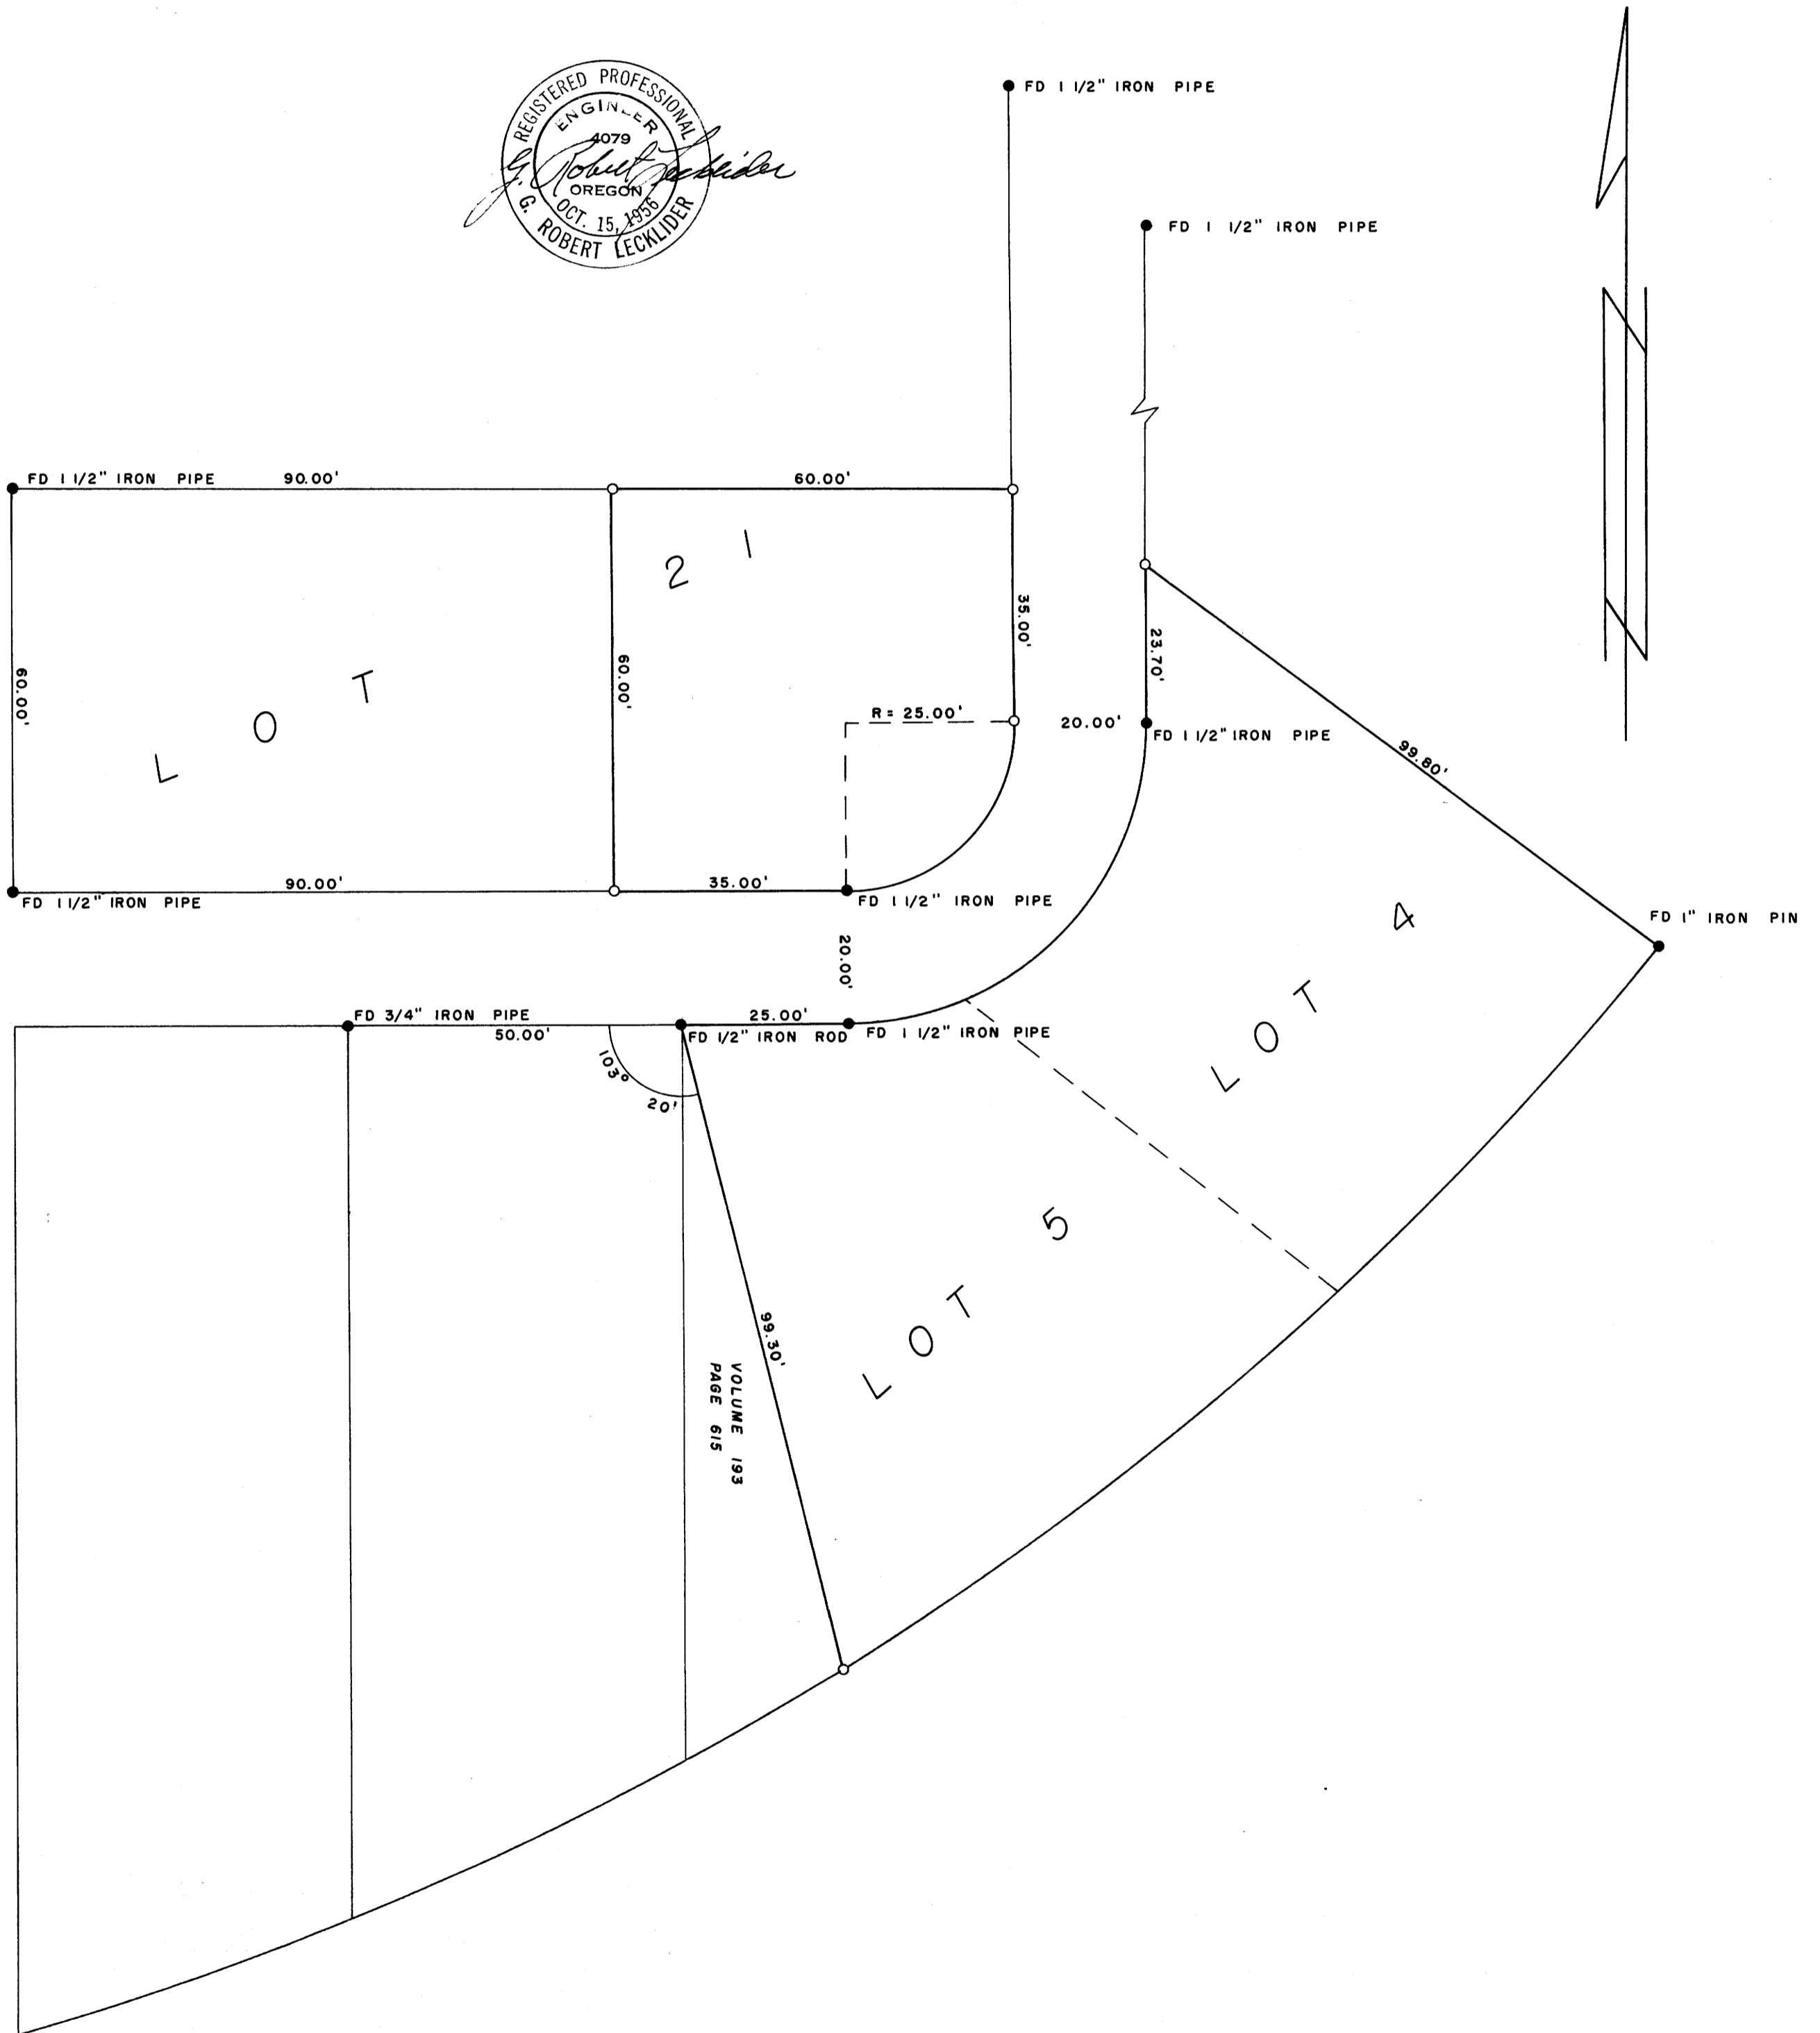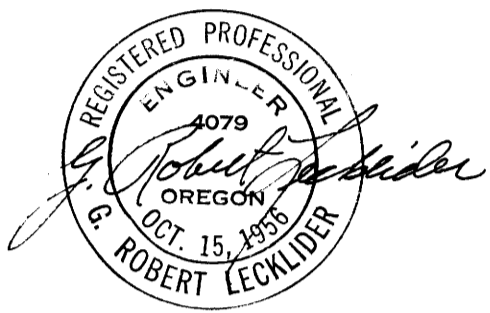

FILED
RECEIVED

JUN 20 1960

COUNTY SURVEYOR
DOUGLAS COUNTY, ORE.

MAP FILE M19T1