

COUNTY SURVEYORS FILE  
DO NOT REMOVE FROM OFFICE



# SURVEY TO ESTABLISH PROPERTY CORNERS IN LOT 1, UMPQUA FRUIT RANCH DOUGLAS COUNTY, OREGON

SURVEYED FOR: V.W. SCHUETZE  
SURVEYED BY: G.R. LECKLIDER-ENG'R.

JULY, 1960  
SCALE: 1"=50'

- DENOTES MONUMENTS FOUND AS SHOWN.
- DENOTES STEEL TUBE WITH SURVEY CAP SET UNLESS OTHERWISE NOTED.

NOTE: BEARINGS BASED ON SURVEY BY JAMES BYRON AS PER C.S. FILE 47/26.

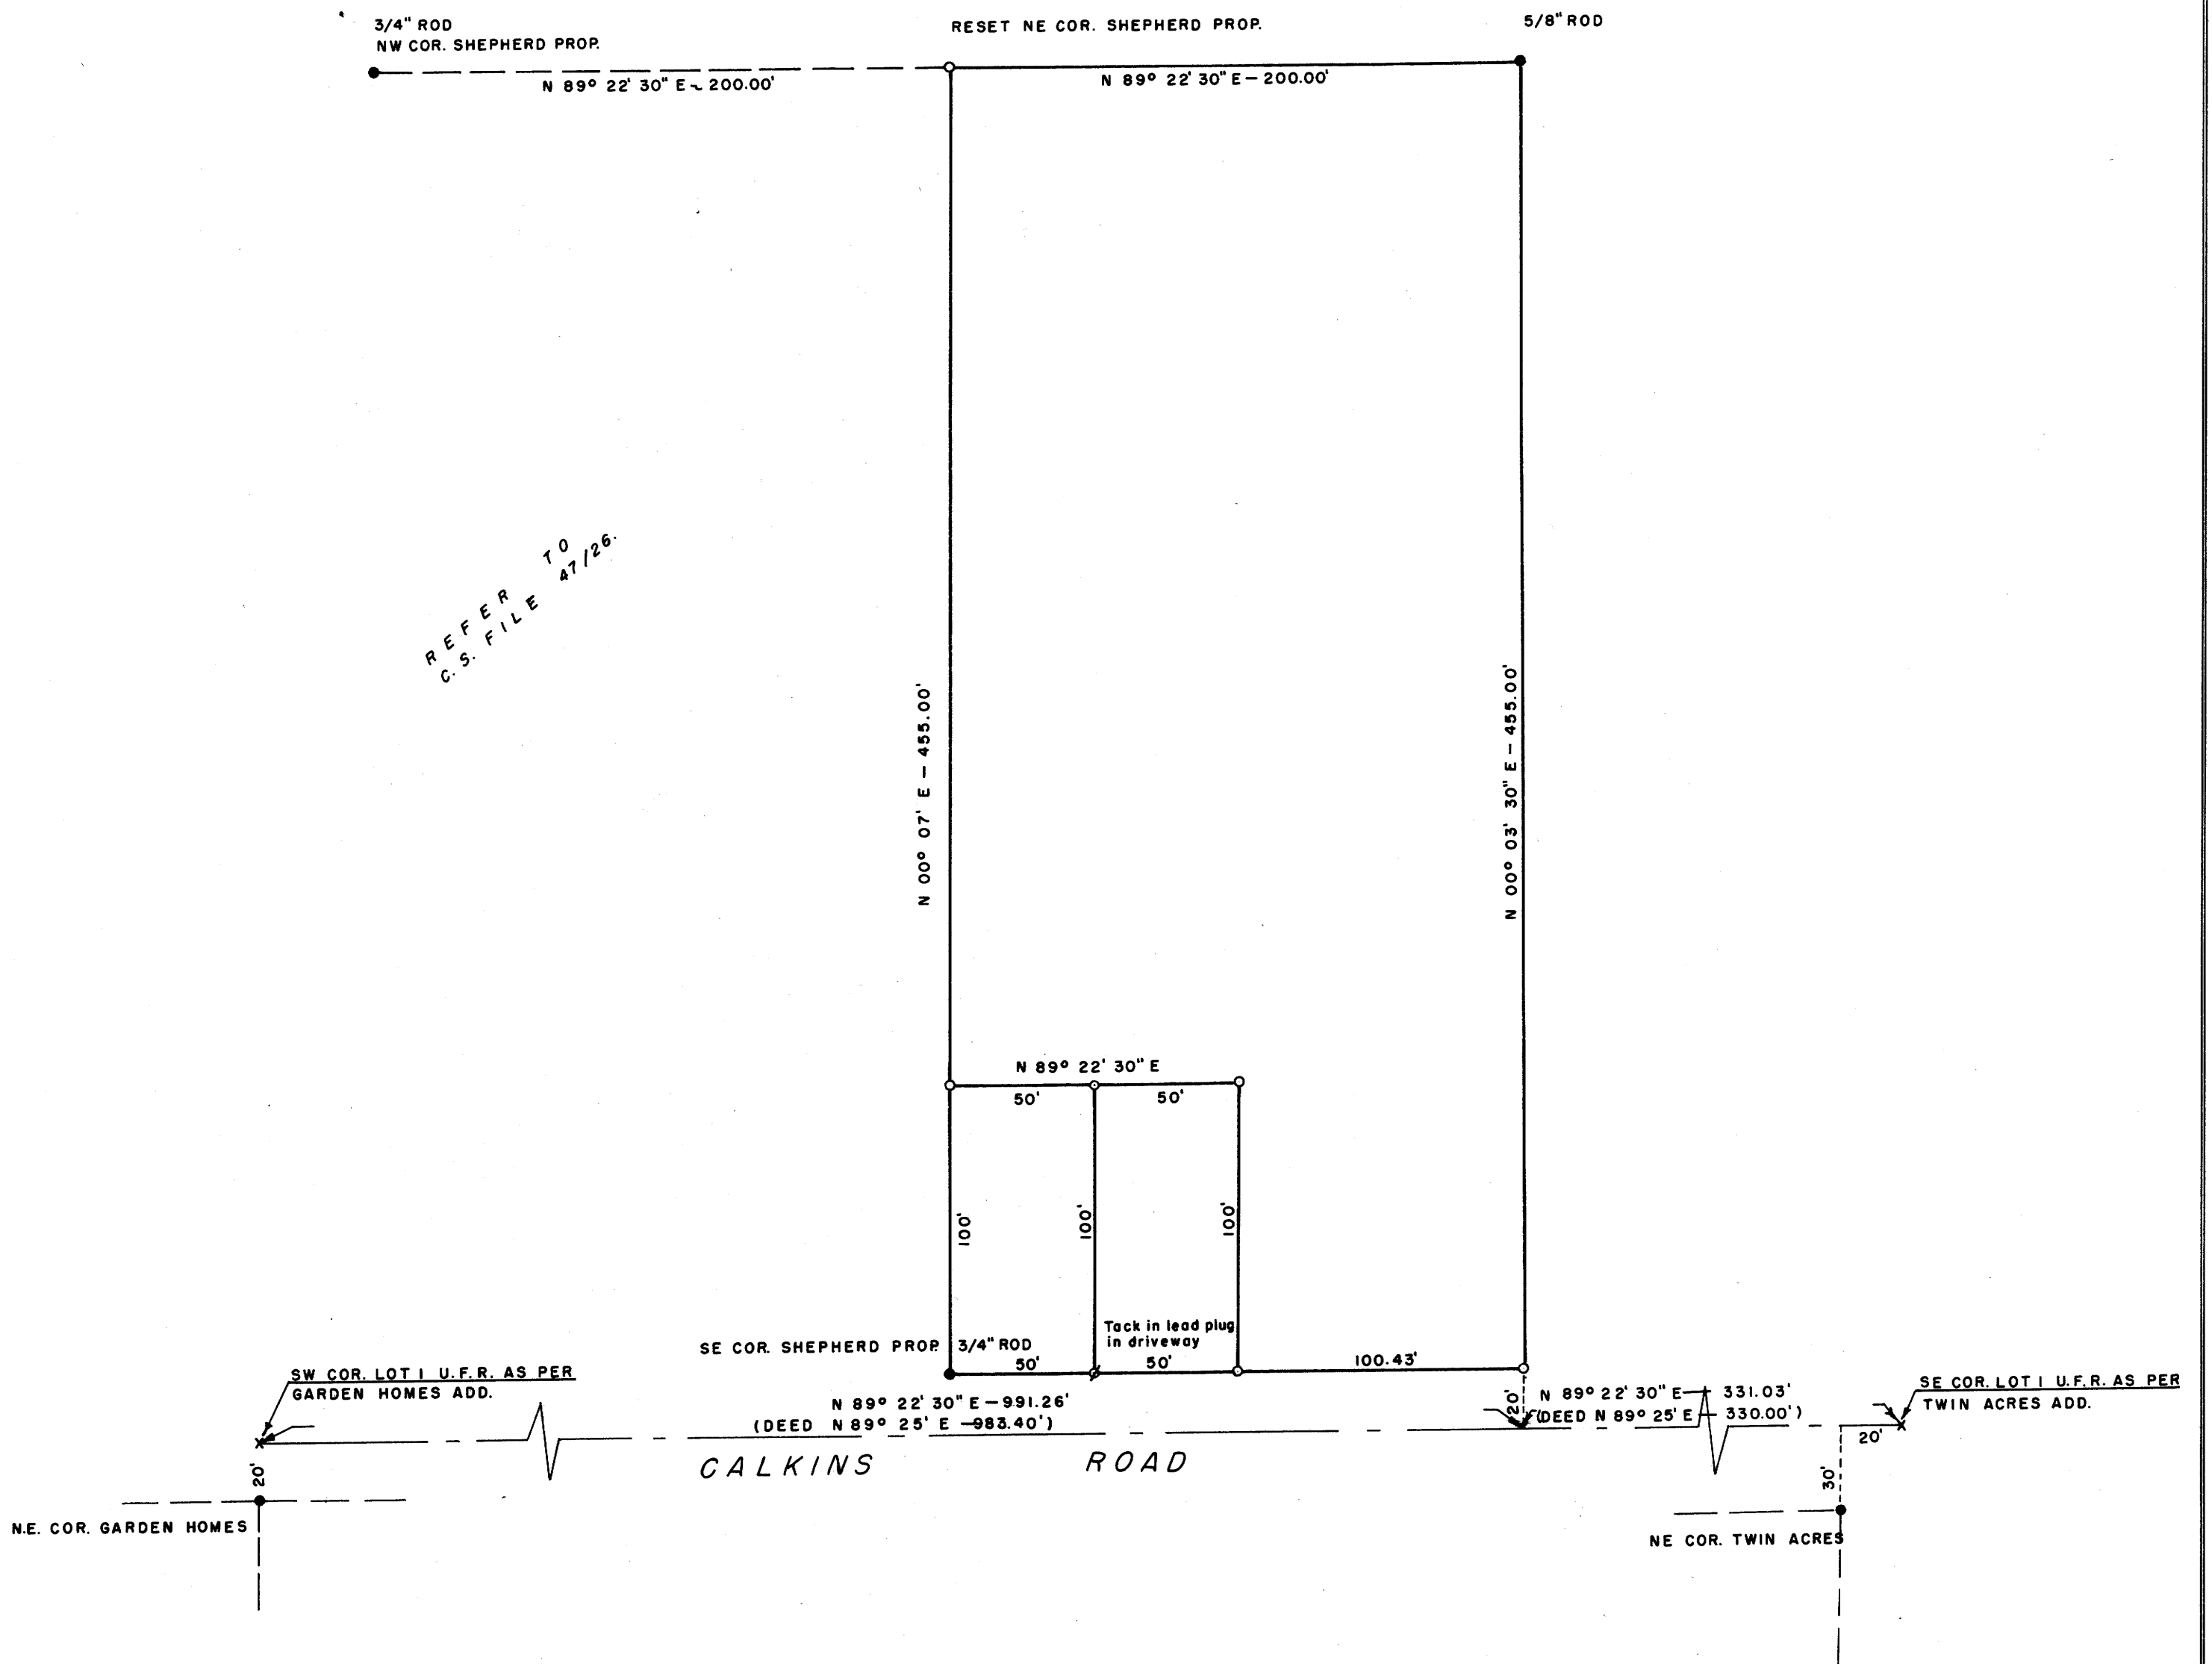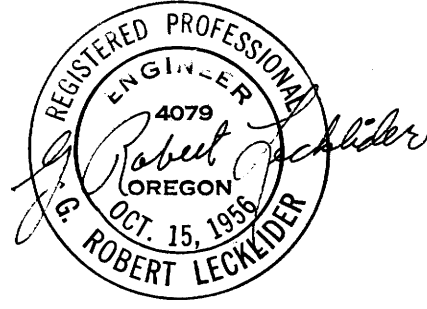

FILED *LL*  
RECEIVED  
JUL 11 1960  
COUNTY SURVEYOR  
DOUGLAS COUNTY, ORE.