


COUNTY SURVEYORS FILE DAY  
DO NOT REMOVE FROM OFFICE

MAP  
SHOWING PORTION  
OF  
JONATHAN WOODRUFF  
D.L.C. No 38.  
TP 26S-RG7W WM.  
SCALE 1"=200'

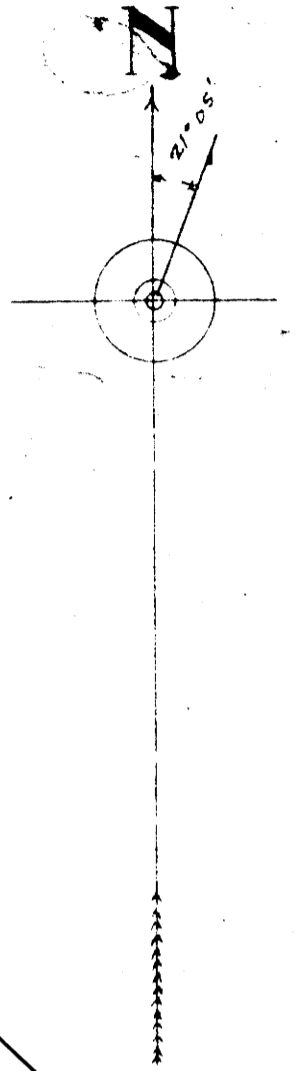


*Edwin J Woodford*

S.W. Cor.  
Jonathan Woodruff  
D.L.C. No 38

S.W. Cor.  
Jonathan Woodruff  
D.L.C. No 38

S.W. Cor.  
Jonathan Woodruff  
D.L.C. No 38

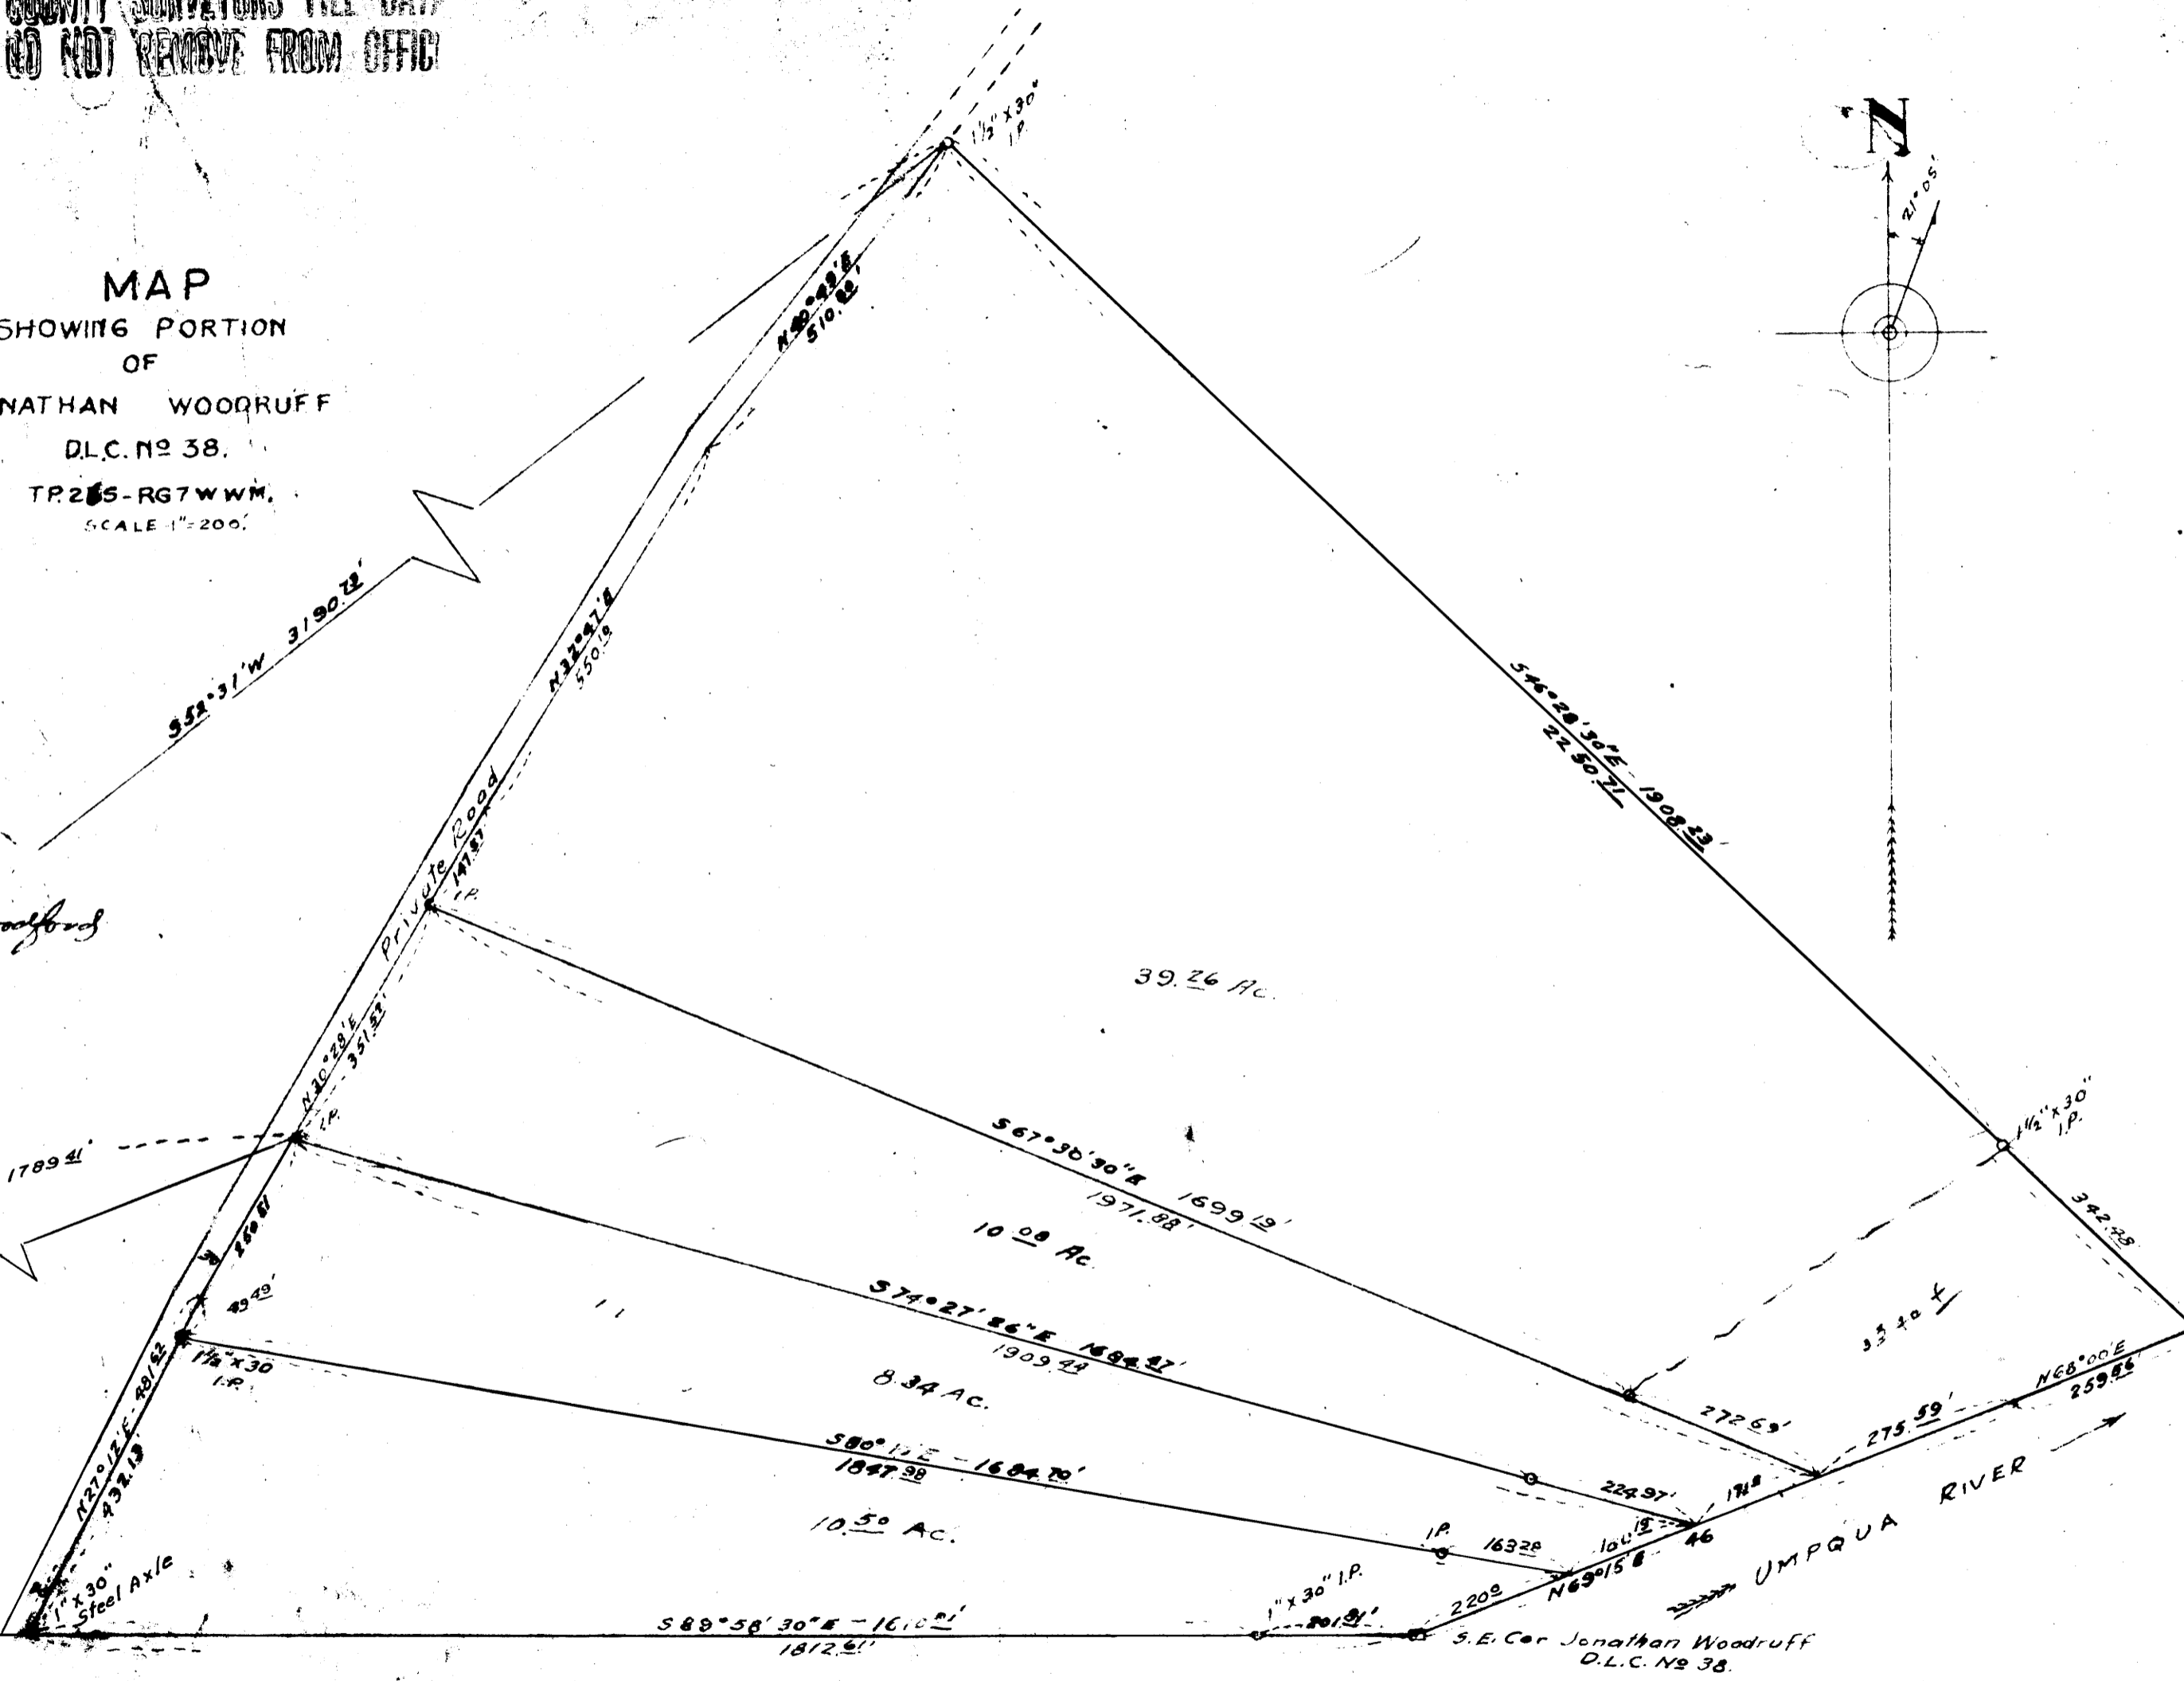

275.39  
259.56  
535.18

FOR JAY YOUNG - FILED 6-28-59

C.S. MAP FILE - M 19/4