


NOTE: BEARINGS BASED ON
S 89° 59' 30" W ALONG
THE SOUTH LINE OF BROADMORE.

COUNTY SURVEYOR'S OFFICE
DOUGLAS COUNTY, OREGON

SURVEY FOR DEED DESCRIPTION,
EDENBOWER ORCHARD TRACTS.

FRED M. DARBY COUNTY SURVEYOR
SURVEYED AUG. 22, 1960 BY
JAMES W. BYRON - DEPUTY SCALE 1" = 100'
SURVEYED FOR DON HOUSLEY

COUNTY SURVEYORS FILE BOOK
DO NOT REMOVE FROM OFFICE

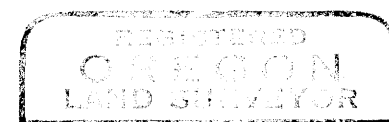

James W. Byron
REG. PRO. SURV.
JAMES W. BYRON
303