

COUNTY SURVEYORS FILE DATA
DO NOT REMOVE FROM OFFICE

SURVEY FOR DEED DESCRIPTION SECTION 33, T 30 S, R 2 W, W.M.

SURVEYED FOR: S. J. COOPER



AUGUST, 1960

SURVEYED BY: G. R. LECKLIDER-ENGR.

SCALE: 1" = 50'

○ STEEL TUBE WITH SURVEY CAP SET.
□ T BAR WITH SURVEY CAP SET.

NOTE: BEARINGS BASED ON SOLAR OBSERVATION.

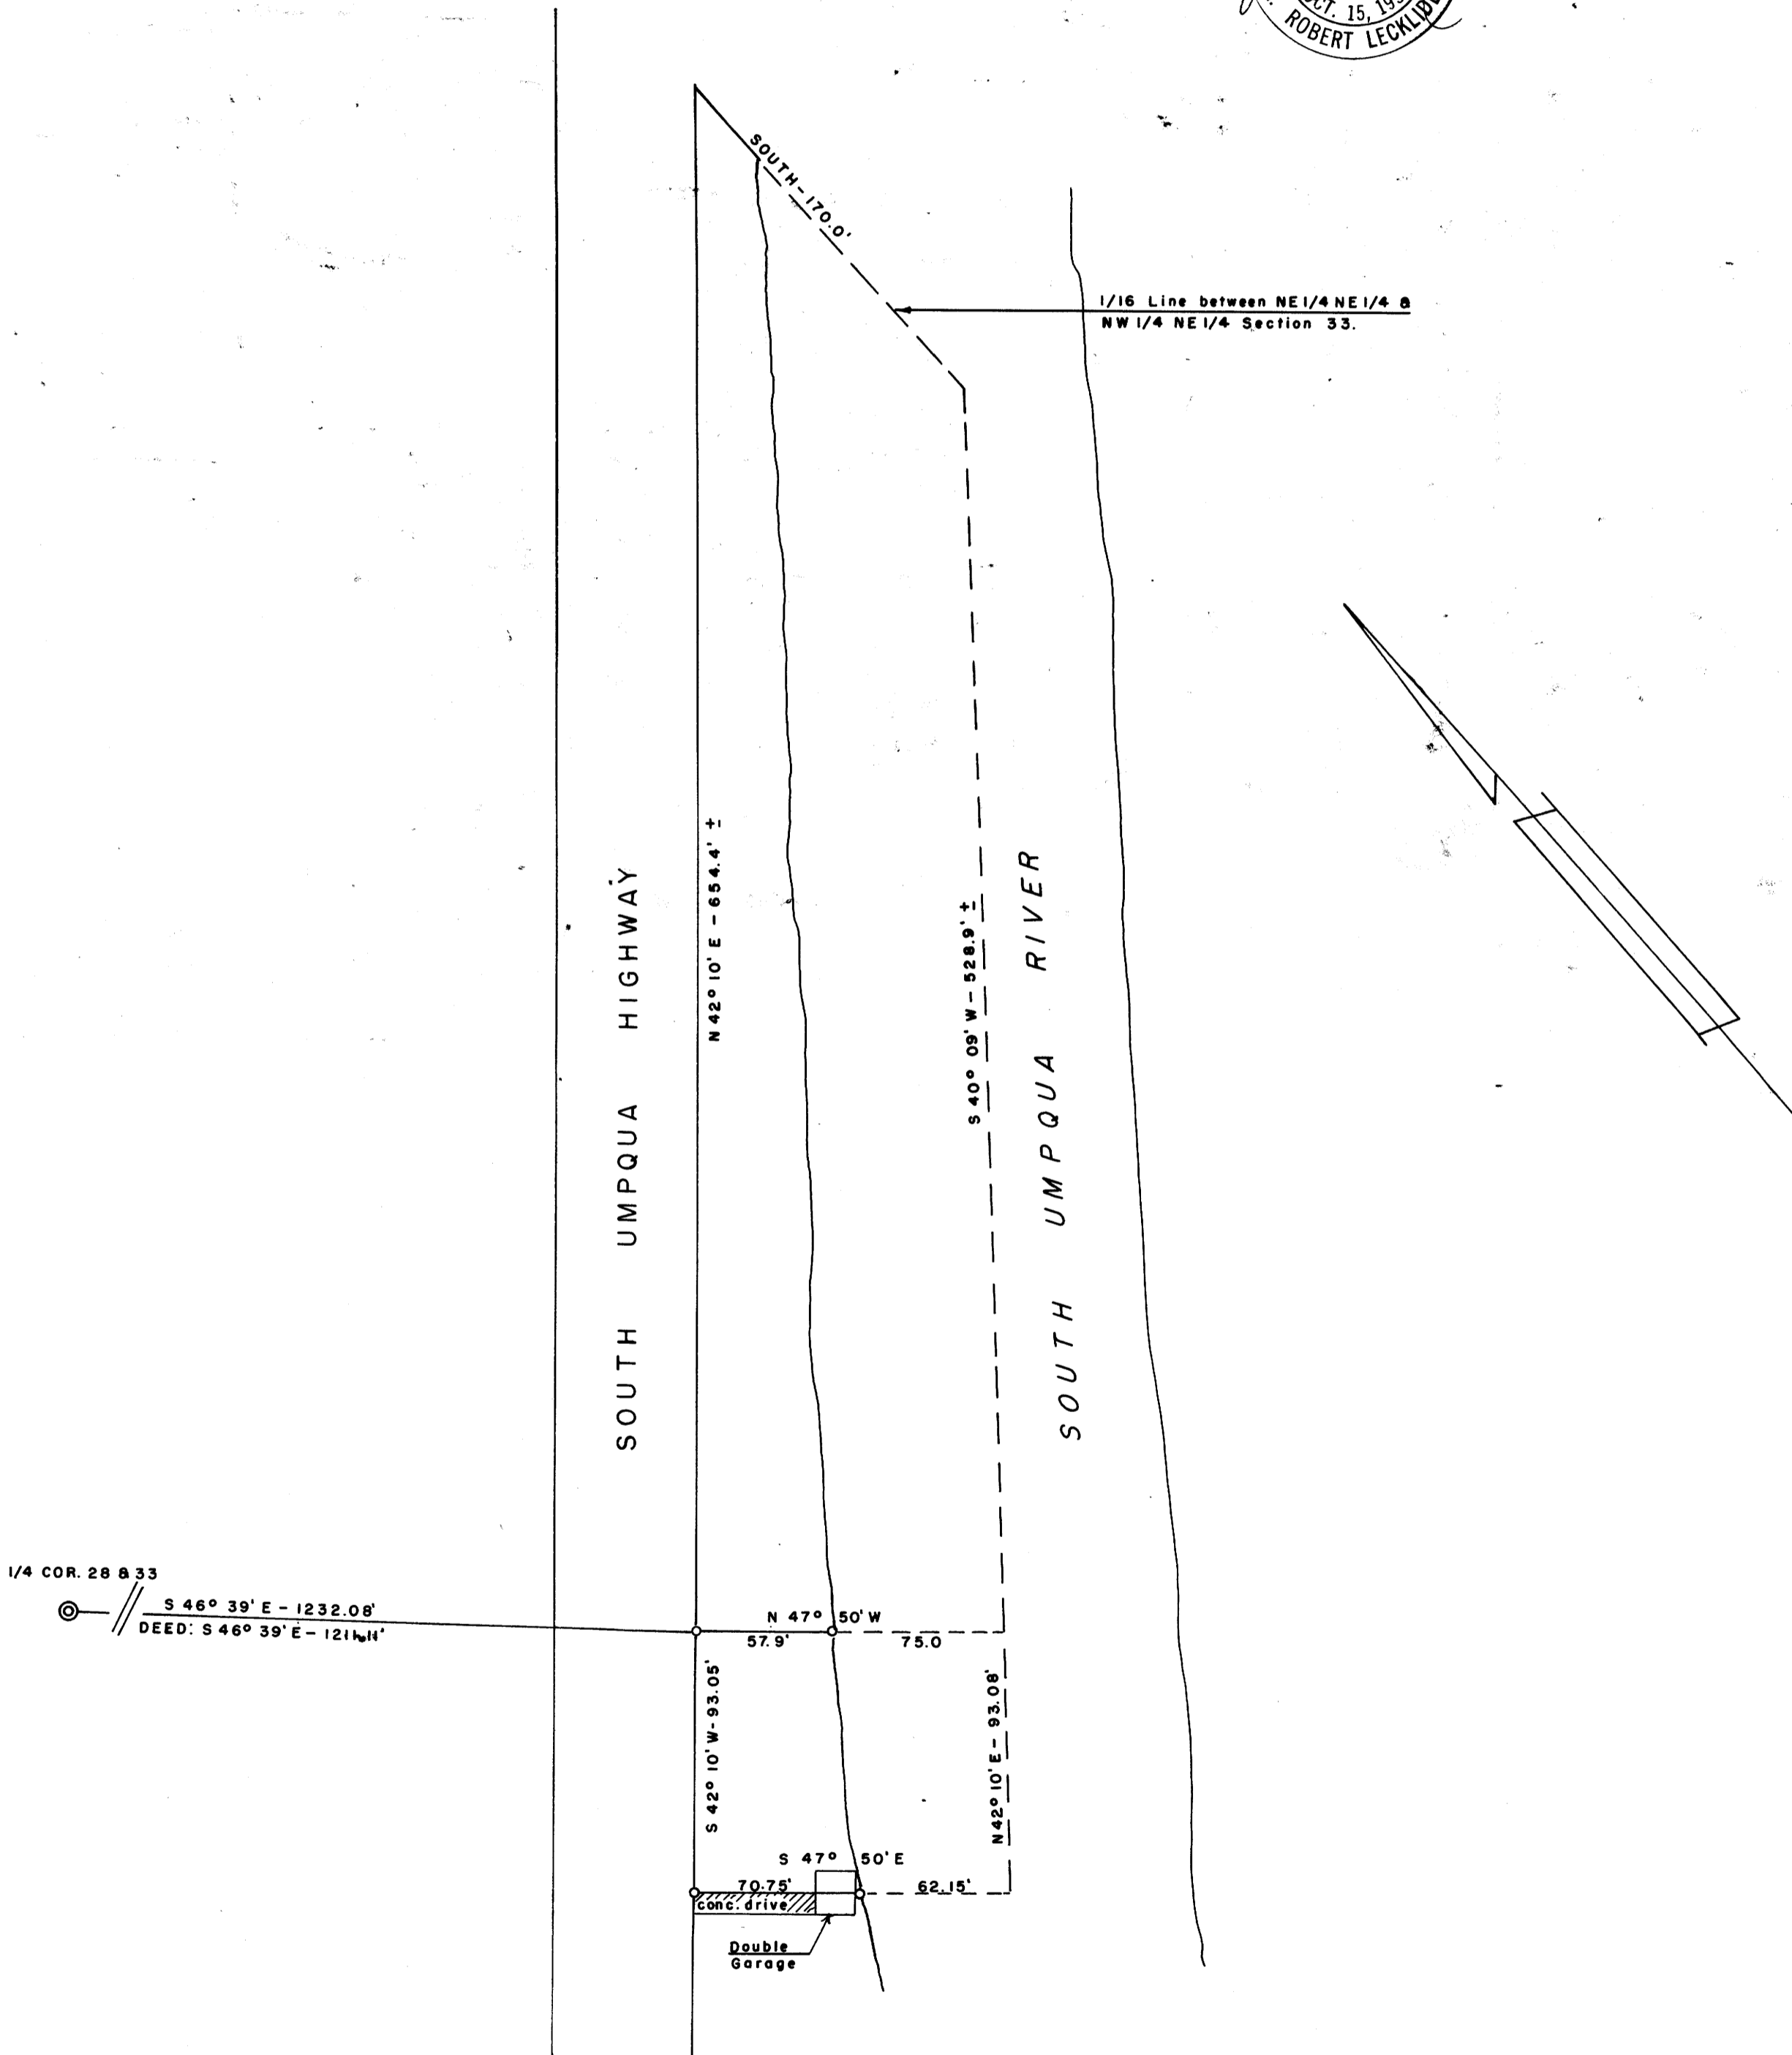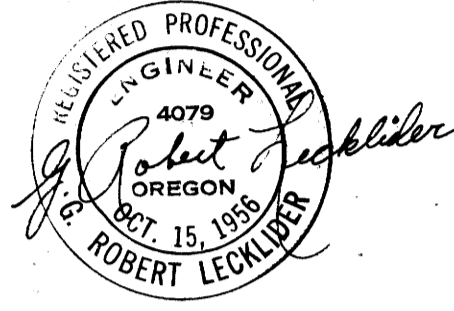

FILED *L.L.*
RECEIVED

AUG 30 1960

COUNTY SURVEYOR
DOUGLAS COUNTY, ORE.