

SURVEY TO SET PROPERTY CORNERS IN LOT 1, SEC. 35, T. 27 S., R. 6 W., W.M.



SURVEYED FOR: H. NORMAN BERNA

MAY, 1960

SURVEYED BY: G. R. LECKLIDER - ENGINEER

SCALE: 1" = 30'

○ DENOTES STEEL TUBE WITH SURVEY CAP SET
FOR CORNER

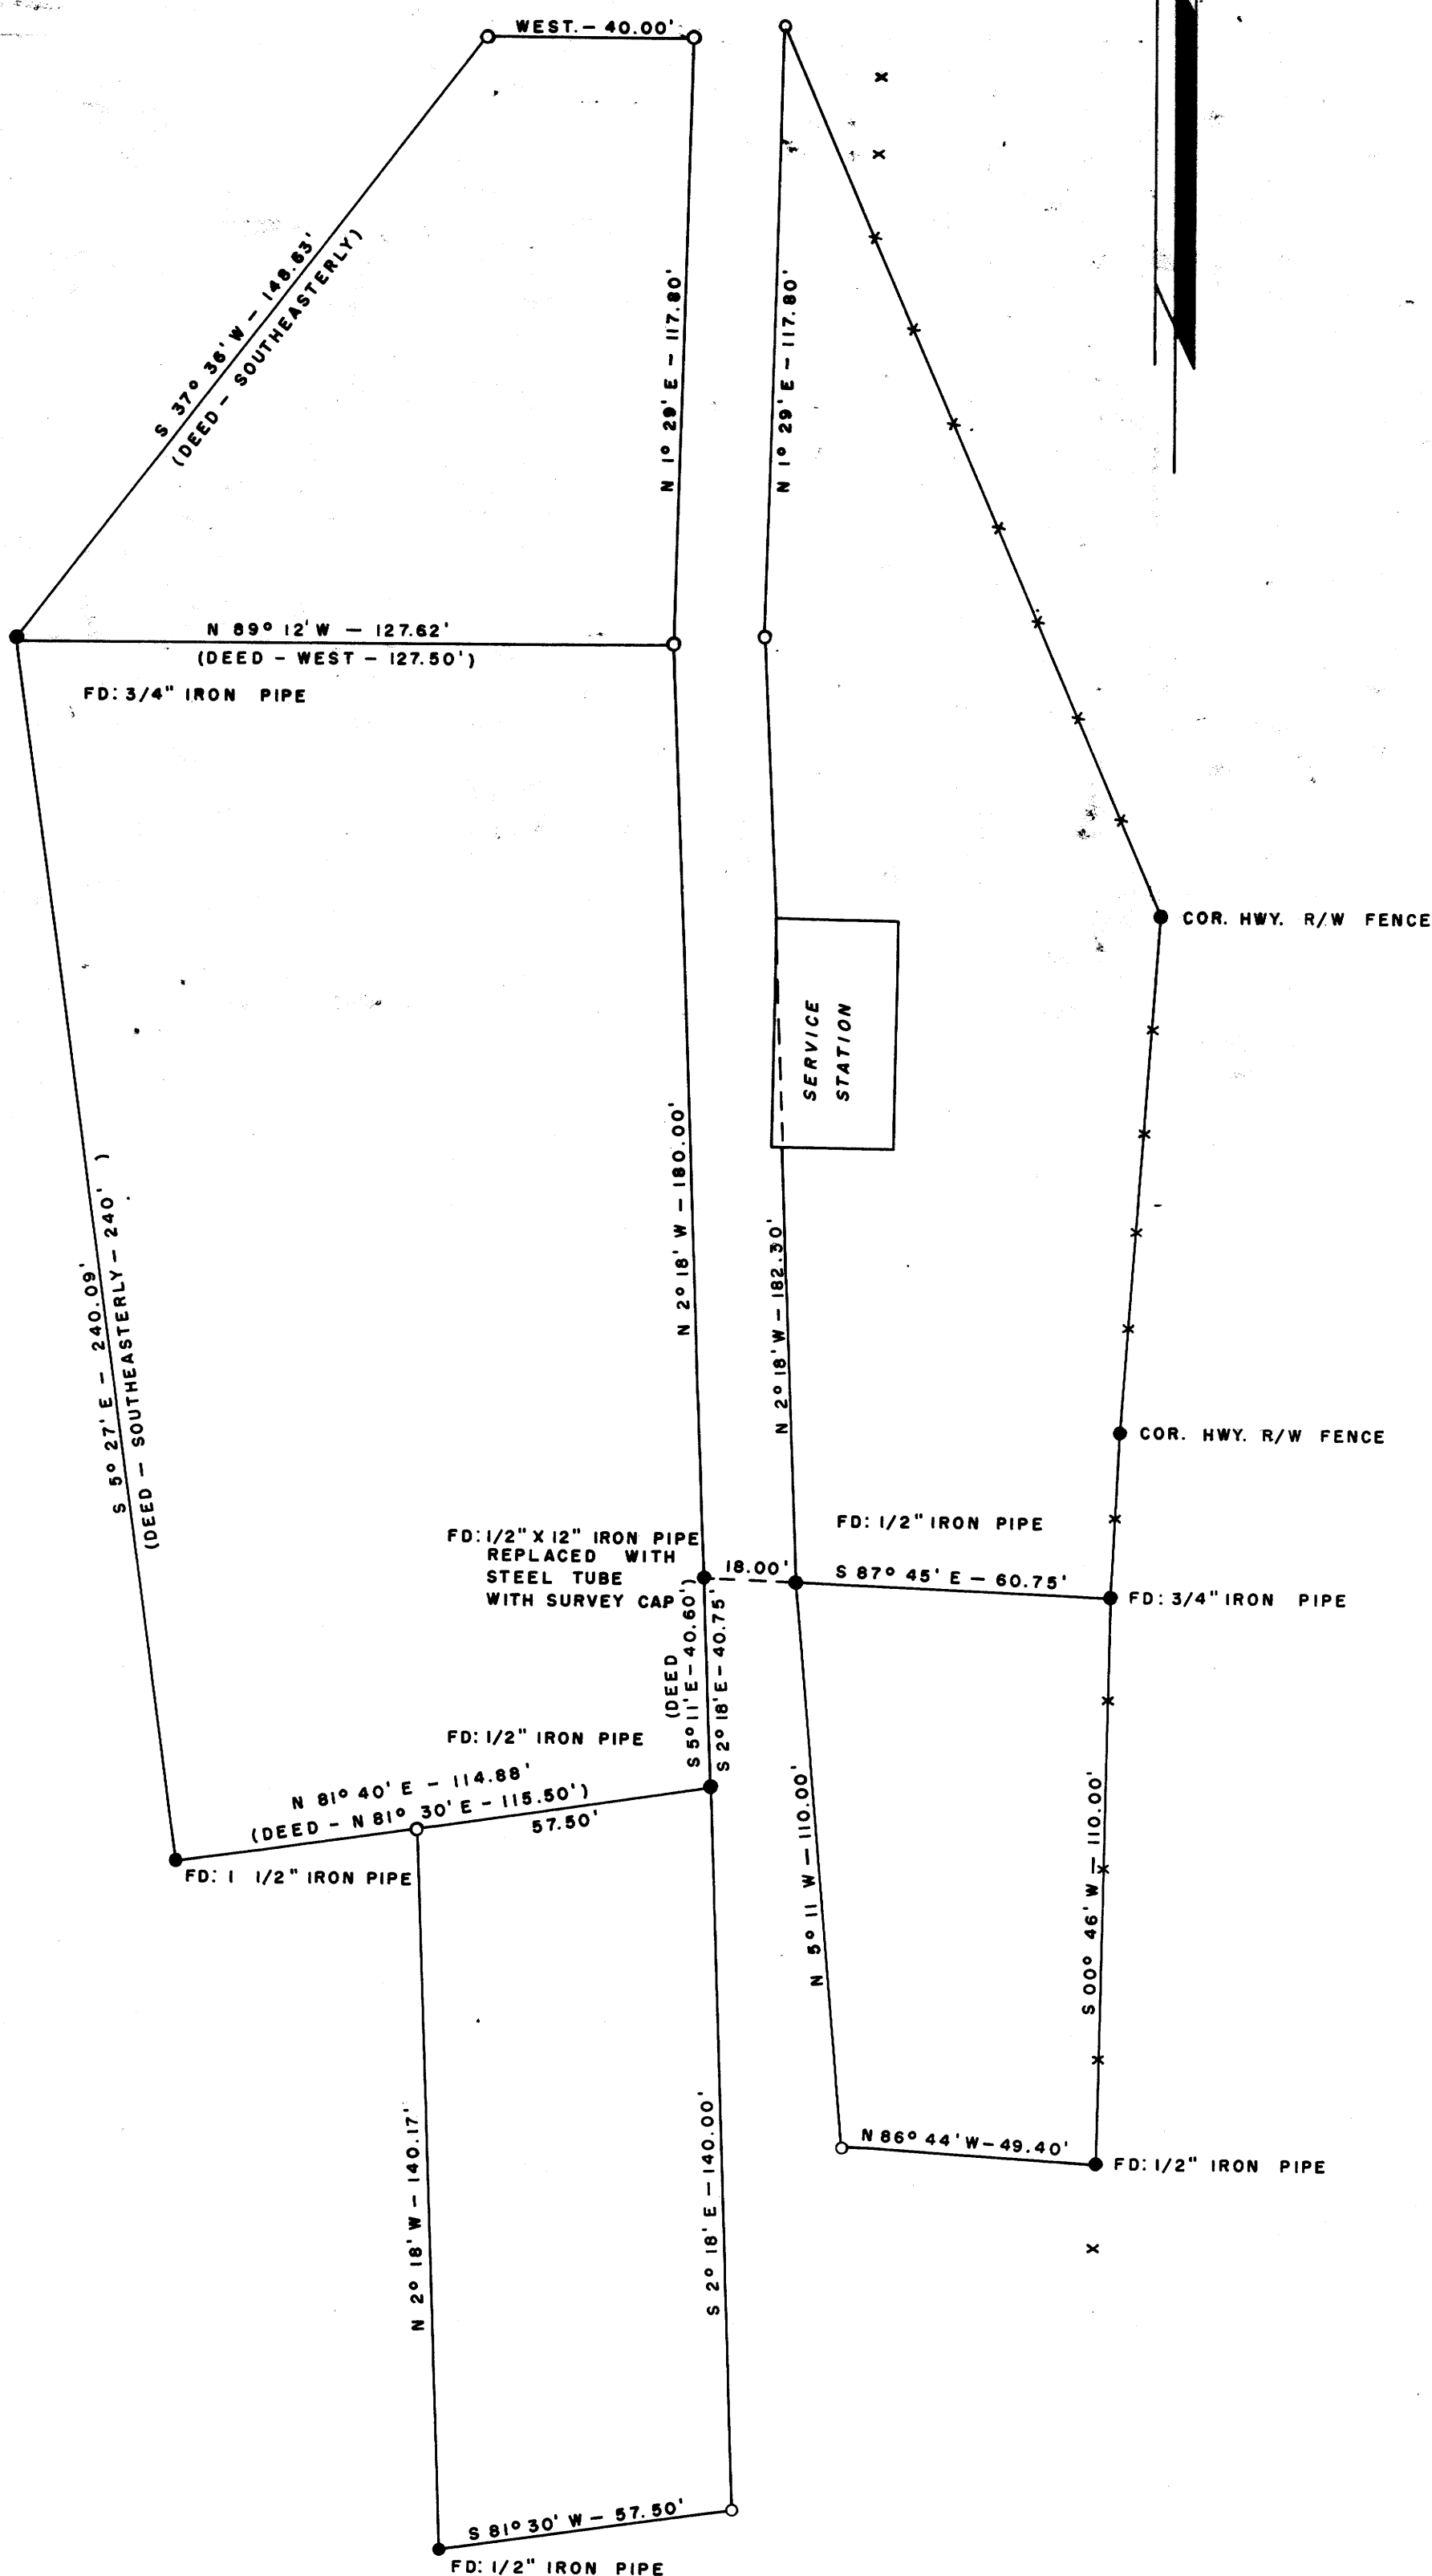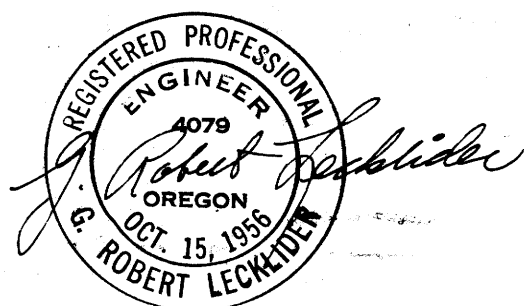

FILED
RECEIVED

SEP 1 1960

COUNTY SURVEYOR
DOUGLAS COUNTY, ORE.