

2-02W

9
16 Found

589°05'E
2660.7

145°9
Found 16


189°45'E
2635.5

9
16 Found

COUNTY SURVEYORS FILE DATA
DO NOT REMOVE FROM OFFICE

MAP
SECTION 16, T.25S., R.1W., WM.
Showing length and bearing of lines,
corners found and corners established.
Scale: 1"=300' Nov. 28, 1960
V.W. Hosford R.L.S. No 253

FILED L.L.
RECEIVED
DEC 9 1960
COUNTY SURVEYOR
DOUGLAS COUNTY, ORE.

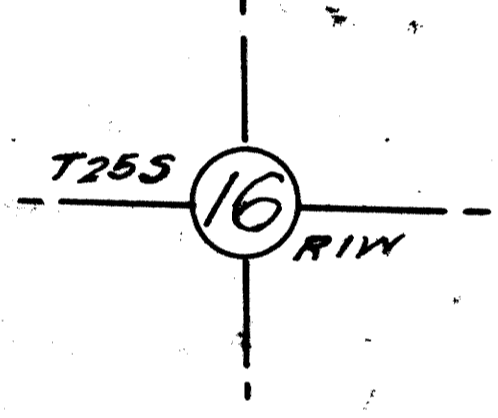

REGISTERED
OREGON
LAND SURVEYOR
V.W. Hosford
MAY 6 1949
V. W. HOSFORD
253

Truck Road

Fire Patrol Road

14 5
17 16 Established

14 5
16 15 Found

Established
17 16
21
Jeep Road

184°32'W.
2728.4

145°16
Found 21

389°22'W.
2665.0

16
21 Found