


FOUND 26
5/8" IR
BTS. AS RECORDED

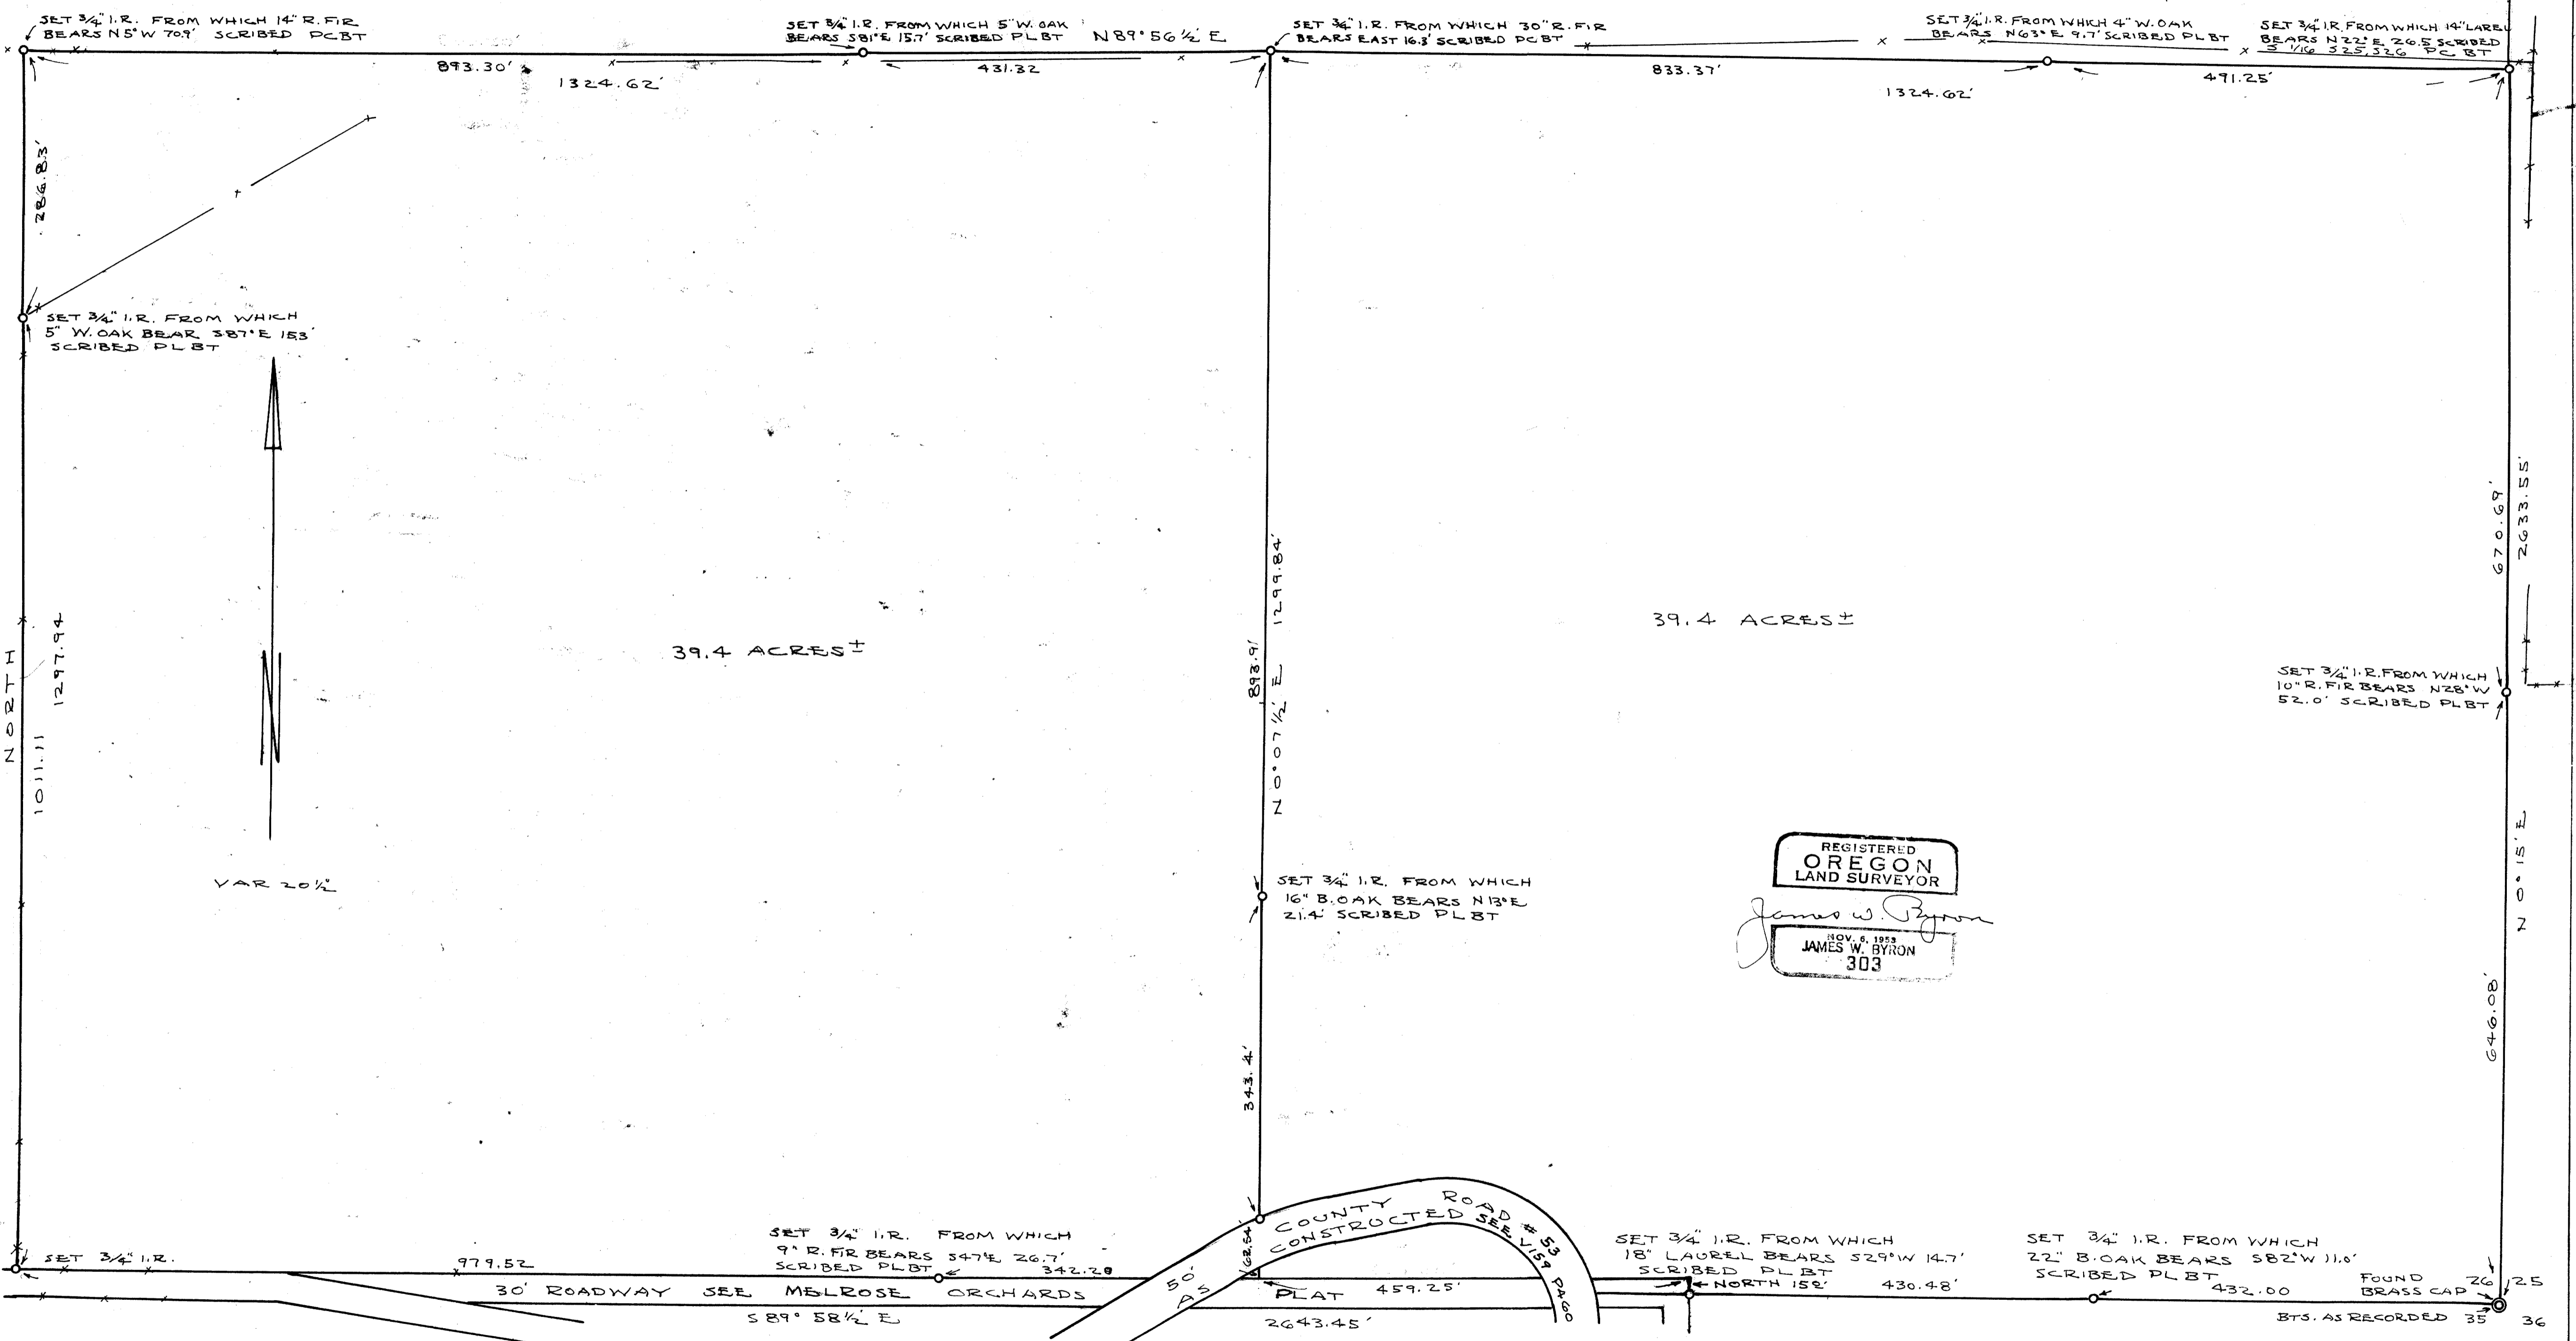

REGISTERED
OREGON
LAND SURVEYOR

James W. Byron
NOV. 6, 1953
JAMES W. BYRON
303

COUNTY SURVEYORS FILE #
DO NOT REMOVE FROM OFFICE

FILED
RECEIVED

MAR 18 1961
COUNTY SURVEYOR
DOUGLAS COUNTY, ORE.

JAMES E. CONN
A DIVISION OF THE SOUTH 1/2 OF THE SE 1/4
SECTION 26 T26 S R7 W
SURVEYED BY JAMES W. BYRON - FEB. 1961
SCALE 1"=100'

M 20-22

M 20-22