

M 20-30

COUNTY SURVEYORS FILE DATA
DO NOT REMOVE FROM OFFICE


SURVEY FOR DEED DESCRIPTION

Section 18, T.22 S., R.5 W. W.M.

for

Lewis Lakey Drain, Oregon.

March 1961 Scale 1" = 200'

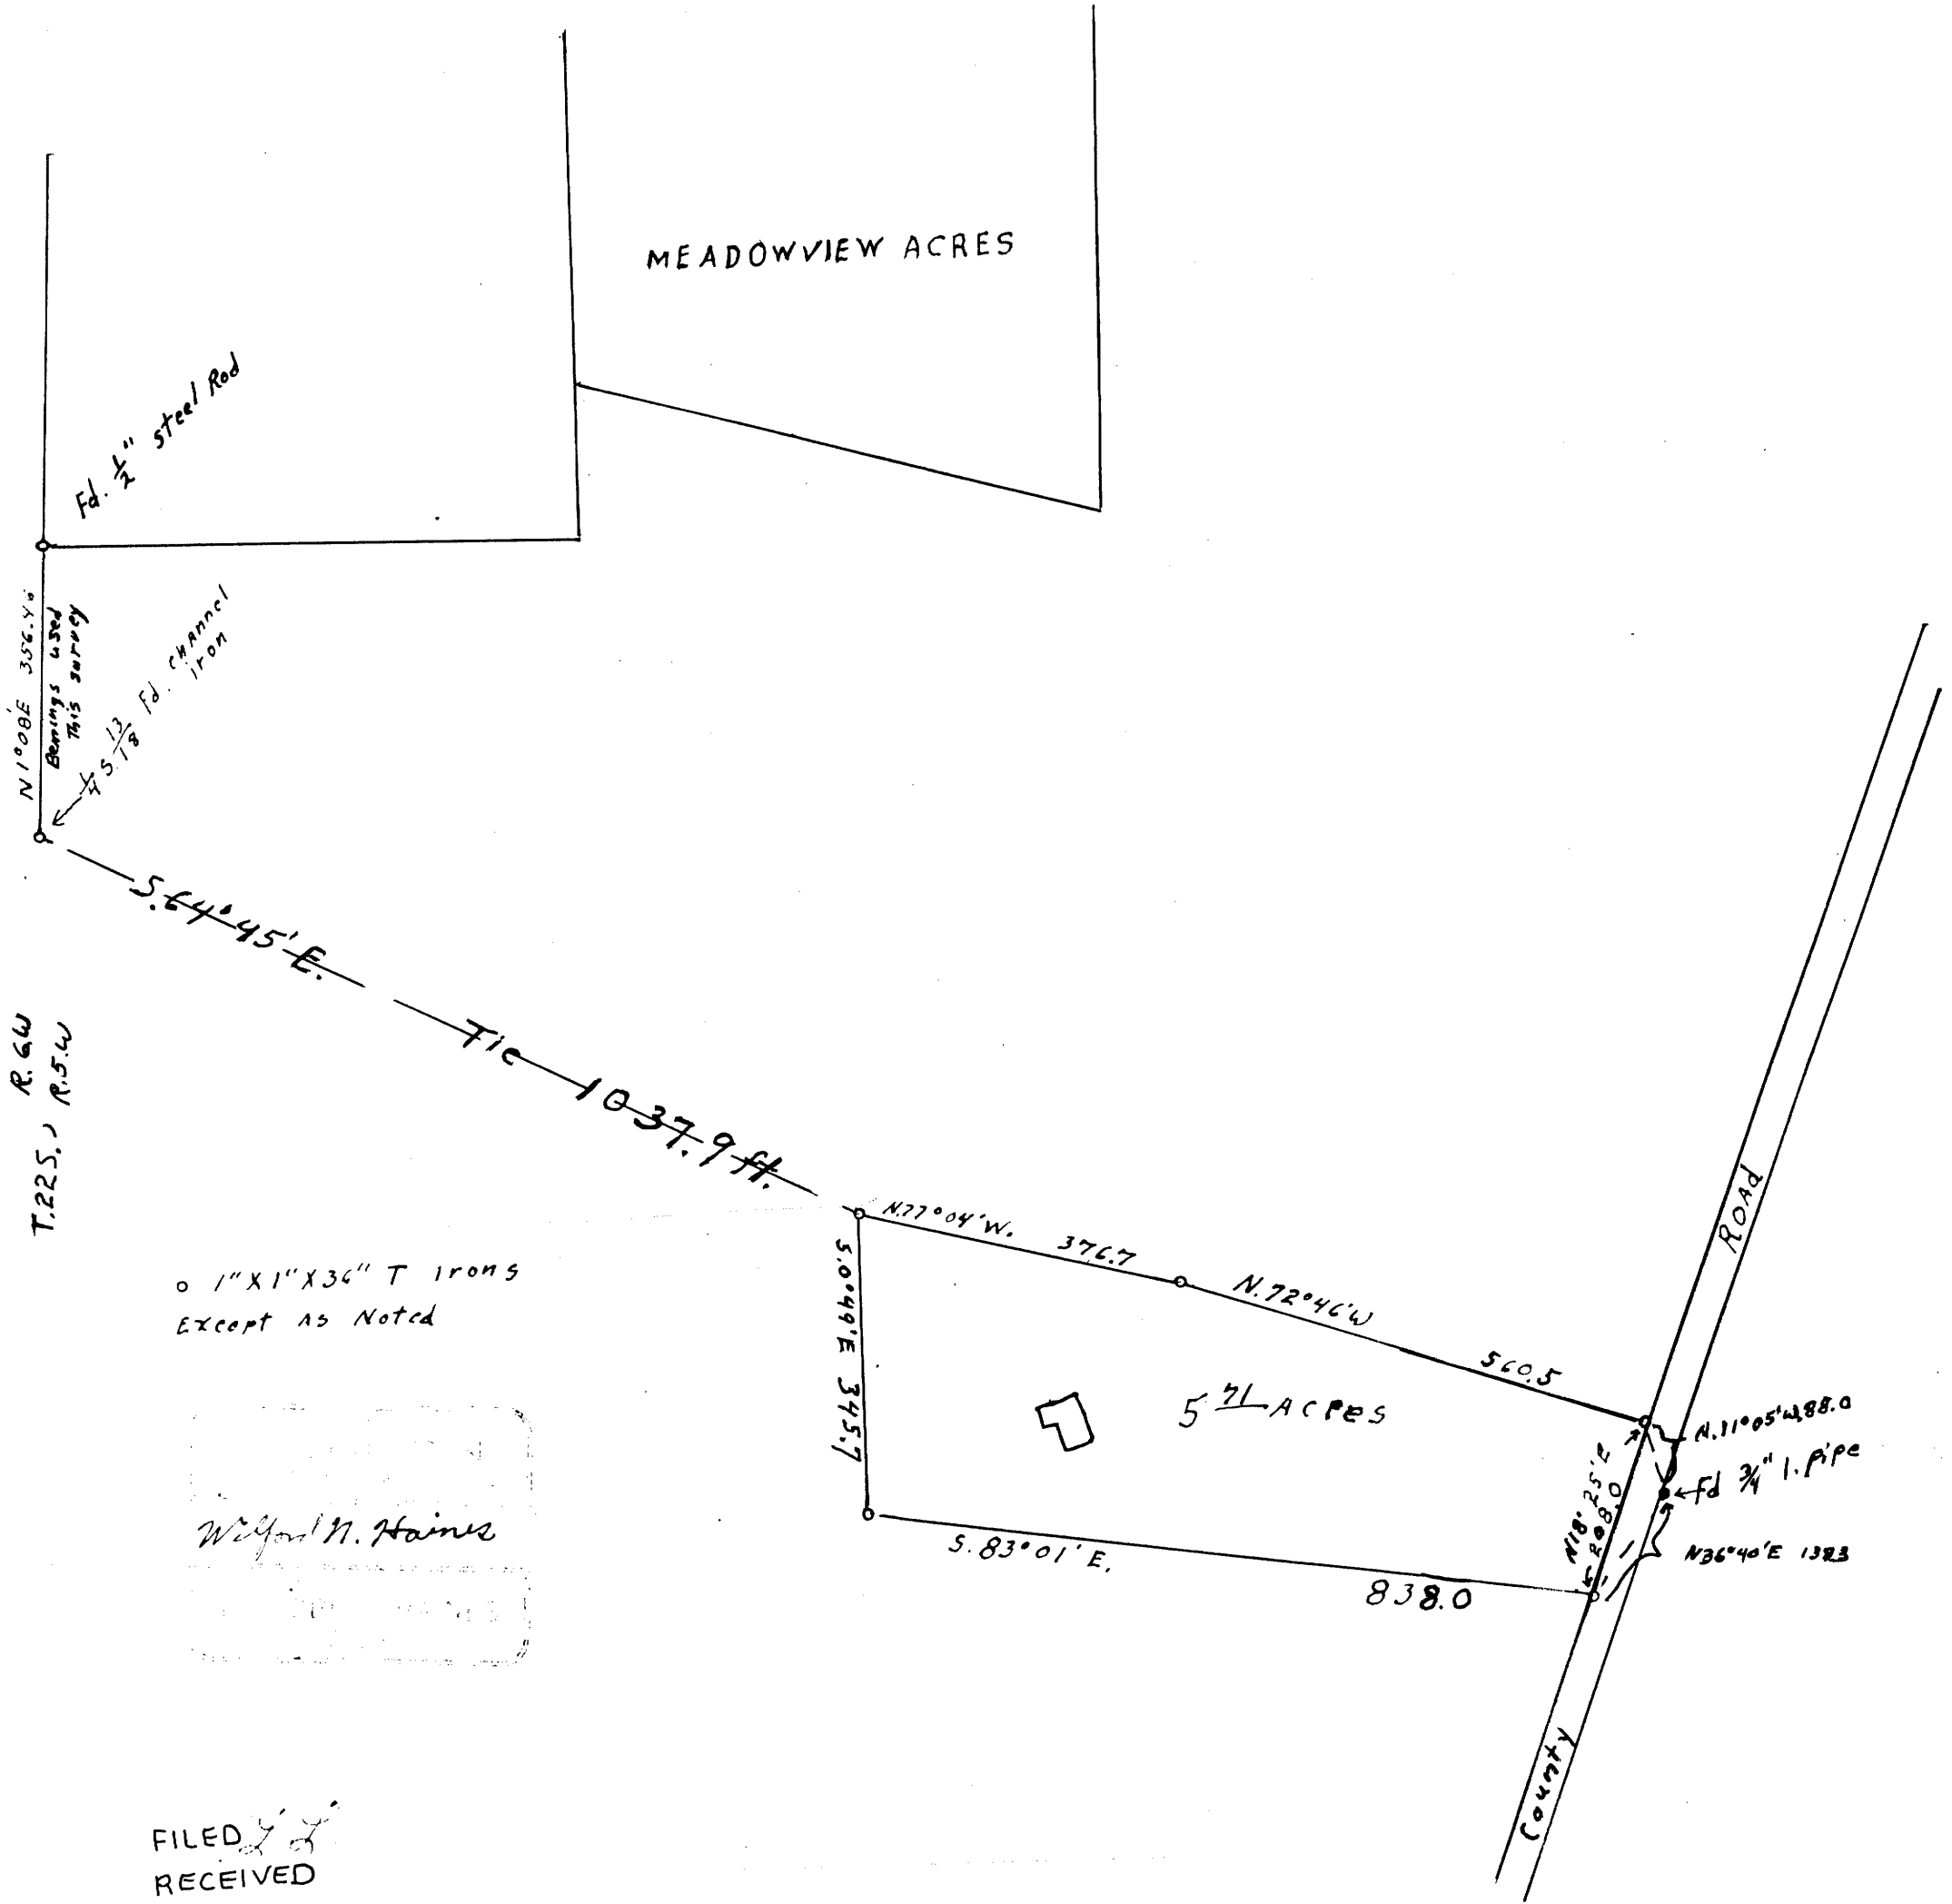

R. 6W
T. 22 S., R. 5 W

o 1" X 1" X 36" T Irons
Except as Noted

W. M. Haines

FILED
RECEIVED

APR 17 1961

COUNTY SURVEYOR
DOUGLAS COUNTY, ORE.

THIS COPY MADE FROM
A XEROX 2510

DATE July 14, 89

M 20-30