
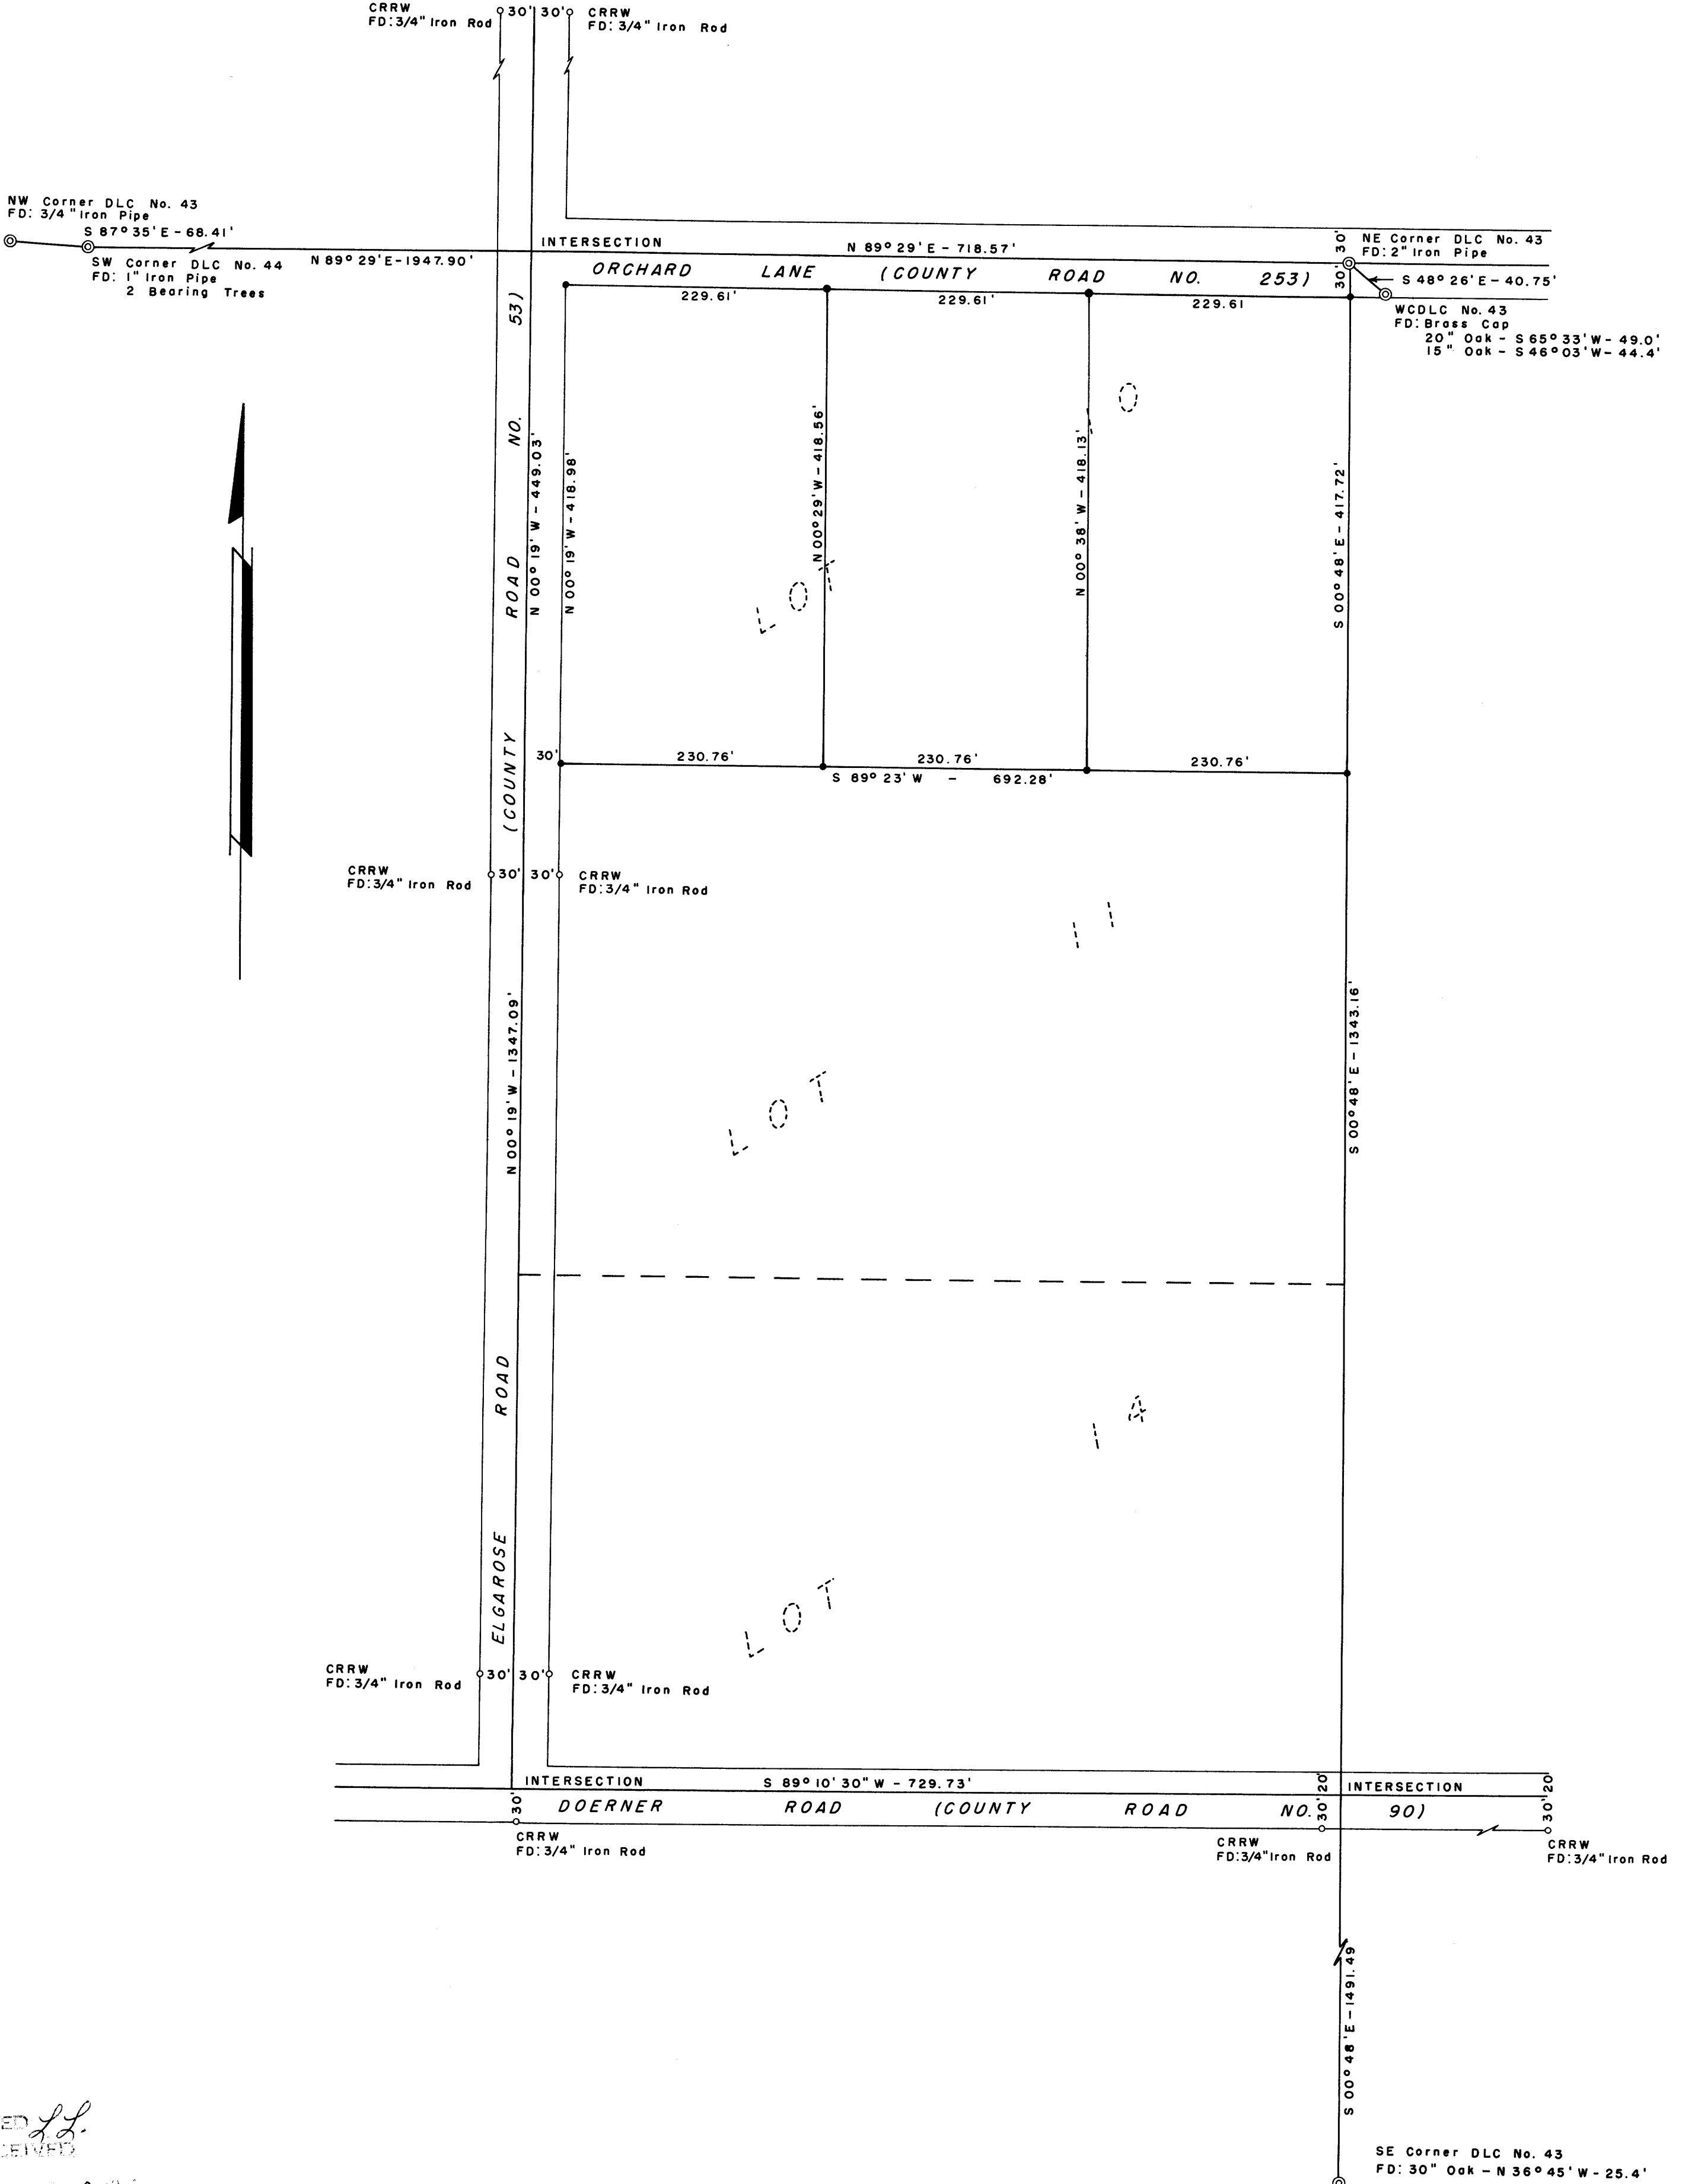


COUNTY SURVEYORS FILE DATA
DO NOT REMOVE FROM OFFICE

SURVEY OF LOT 10, FIRST ADDITION TO EDEN ORCHARDS DOUGLAS COUNTY, OREGON

SURVEYED FOR: H. L. HANDY
SURVEYED BY: G. R. LECKLIDER - ENGINEER
SCALE: 1" = 100'

● DENOTES STEEL TUBE WITH SURVEY CAP SET

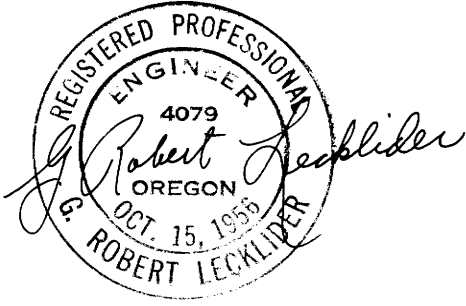

FILED
RECEIVED

APR 19 1961

COUNTY SURVEYOR
DOUGLAS COUNTY, ORE.