


M 20-62

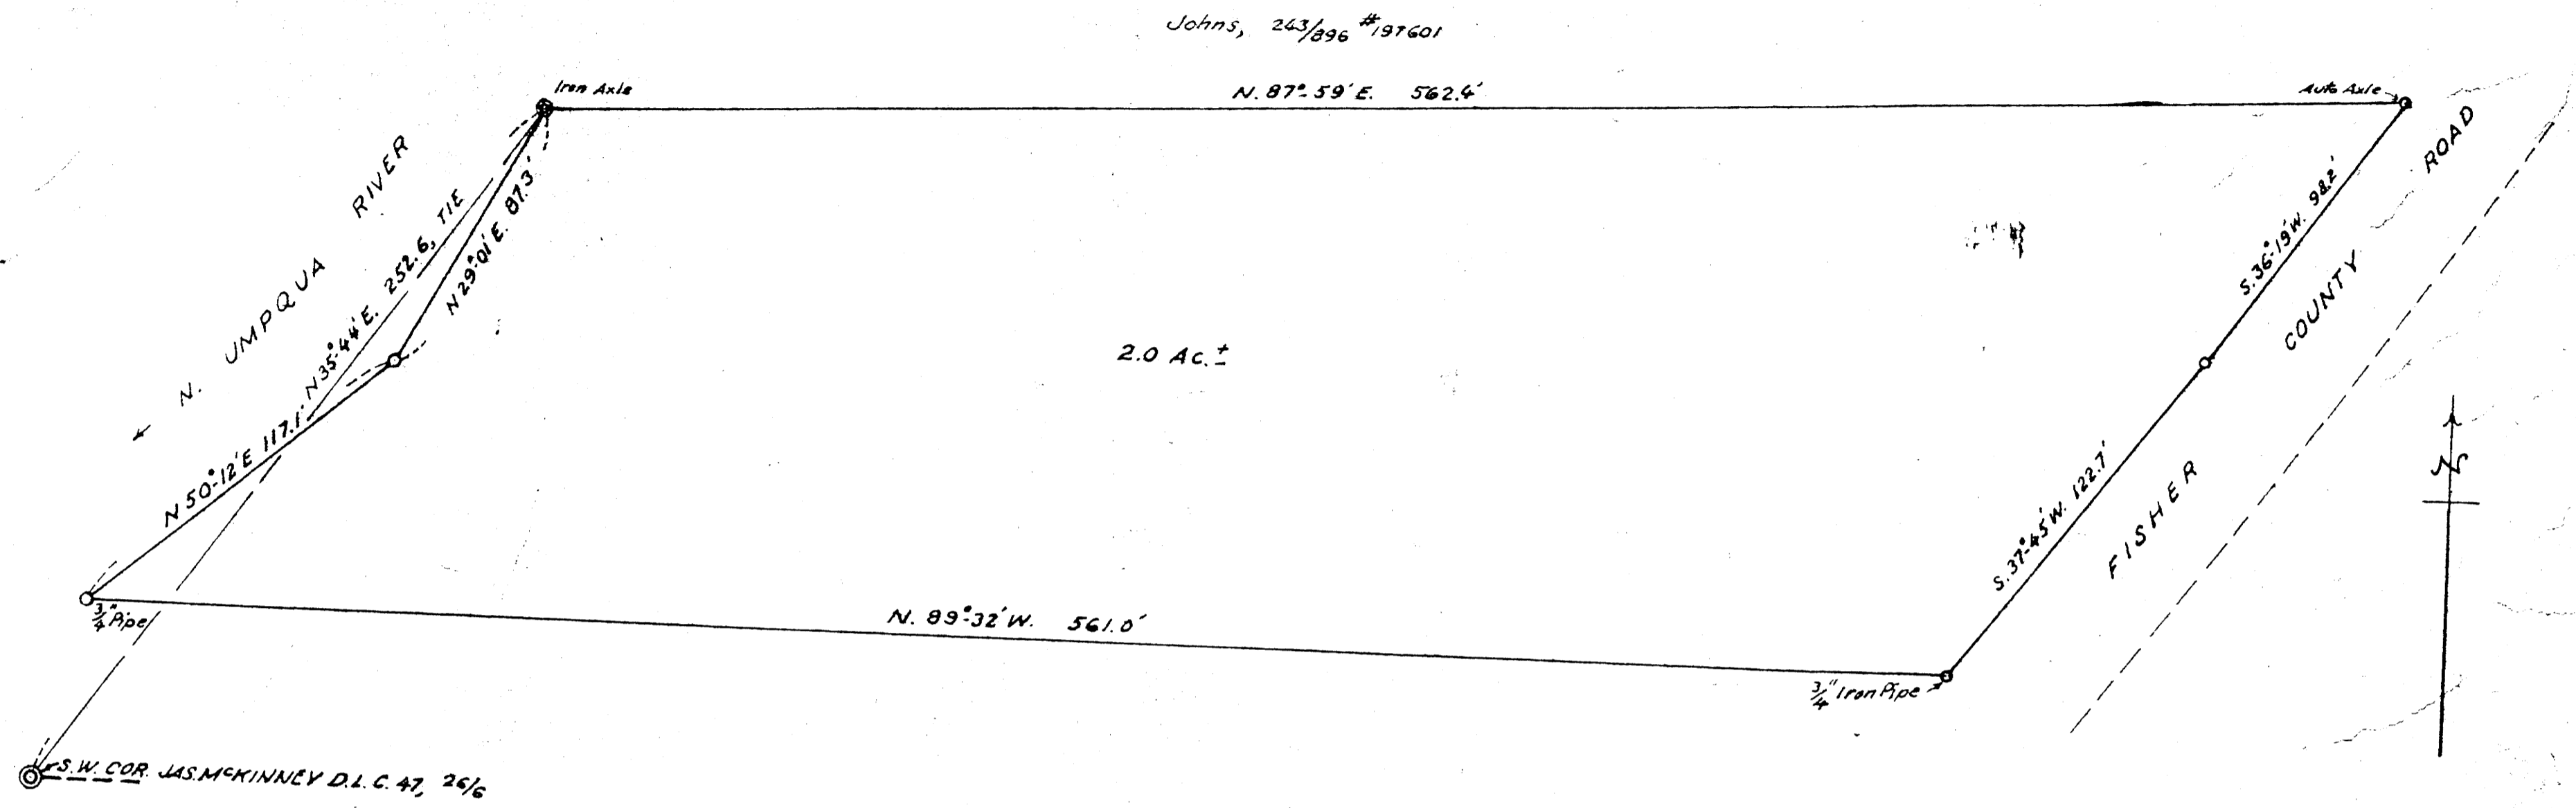

Johns, 243/896 #197601

2.0 Ac. ±

THIS COPY MADE FROM  
A XEROX 2510  
DATE July 18, 89

FILED *L.L.*  
RECEIVED  
JUN 26 1961  
COUNTY SURVEYOR  
DOUGLAS COUNTY, ORE.

CALKINS TO FREEMAN  
ACREAGE IN JAS MCKINNEY DON. LND. CLM. 47,  
IN SEC. 27, T.28S; R.6W; WIL. MER.  
DOUGLAS COUNTY, OREGON.  
MAR. 1961  
1" = 40 FT.

*Arthur Boyer*

COUNTY SURVEYORS FILE DATA  
DO NOT REMOVE FROM OFFICE

M 20-62