


THIS COPY MADE FROM
A XEROX 2510
DATE July 19 89

M 20-65

SCHOOL DIST. 4

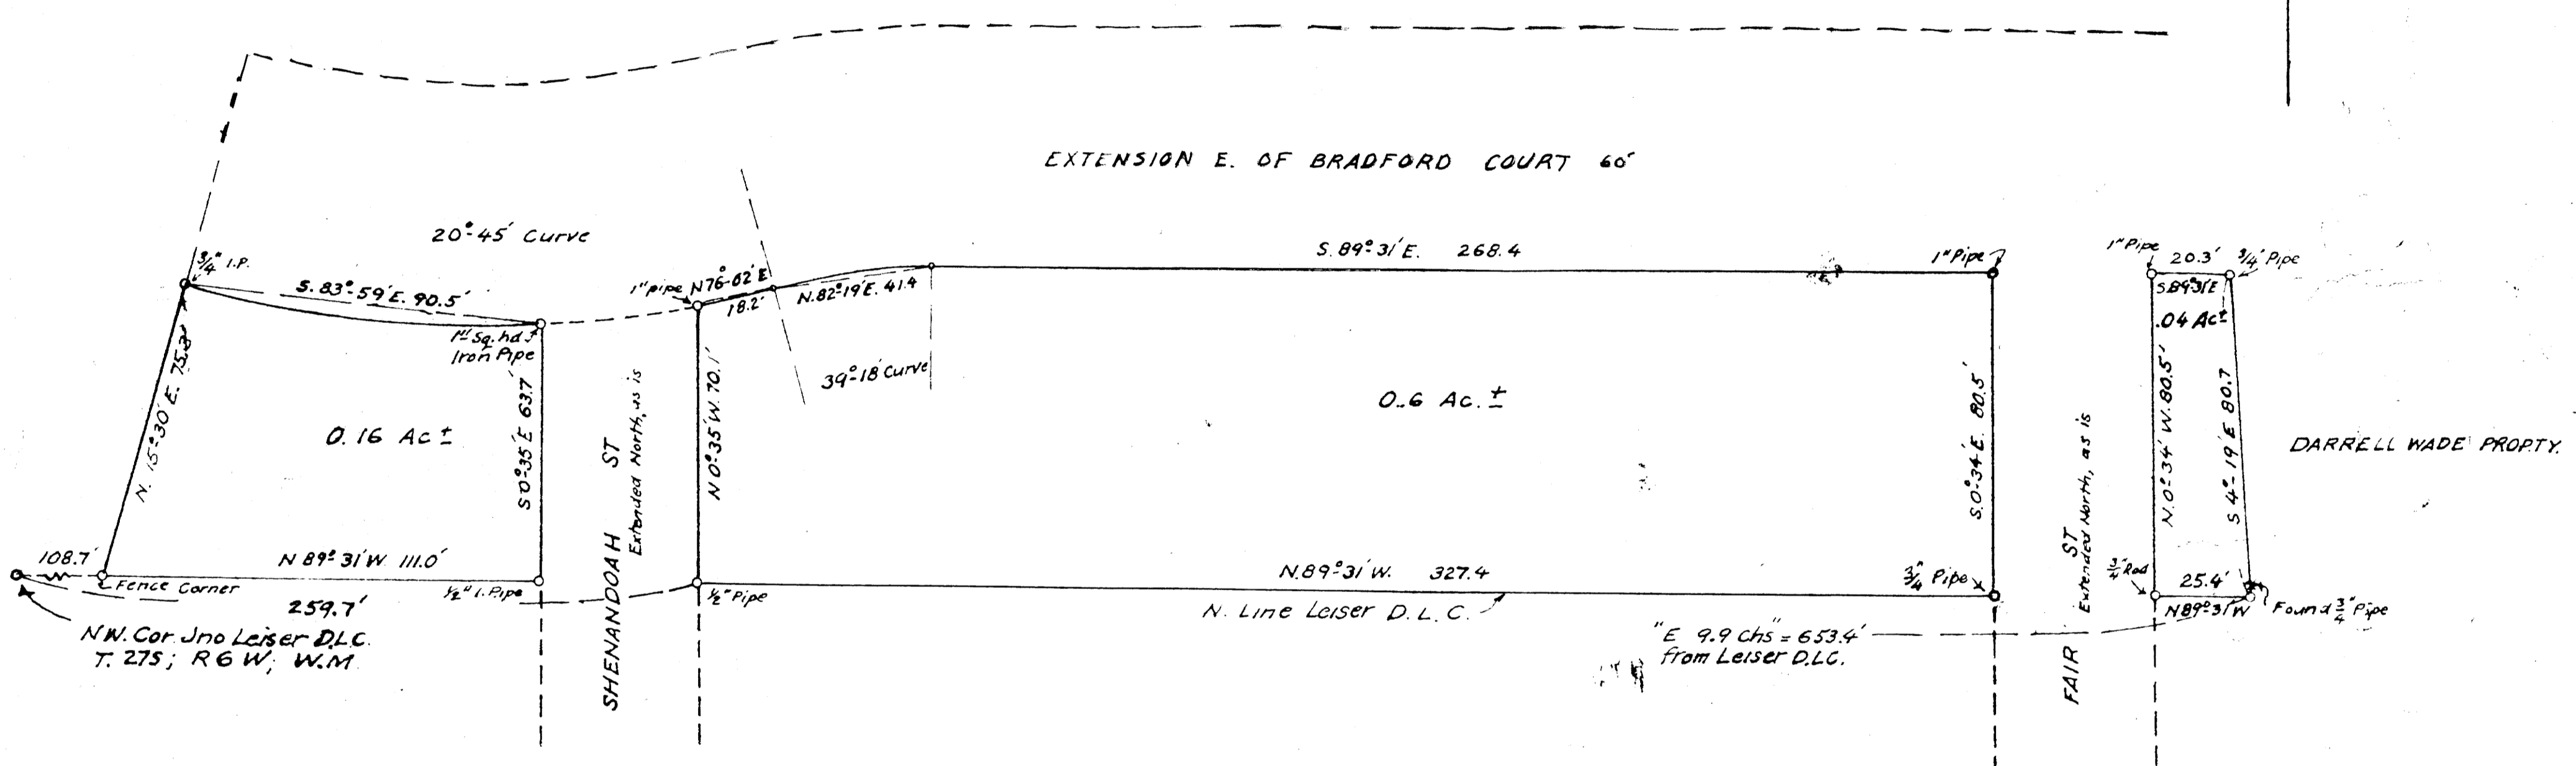

FILED
RECEIVED
JUN 26 1961
COUNTY SURVEYOR
DOUGLAS COUNTY, ORE.

COUNTY SURVEYORS FILE DATA
DO NOT REMOVE FROM OFFICE

Arthur Dyer

1" = 30 ft.

M. 20-65