


M 20-67

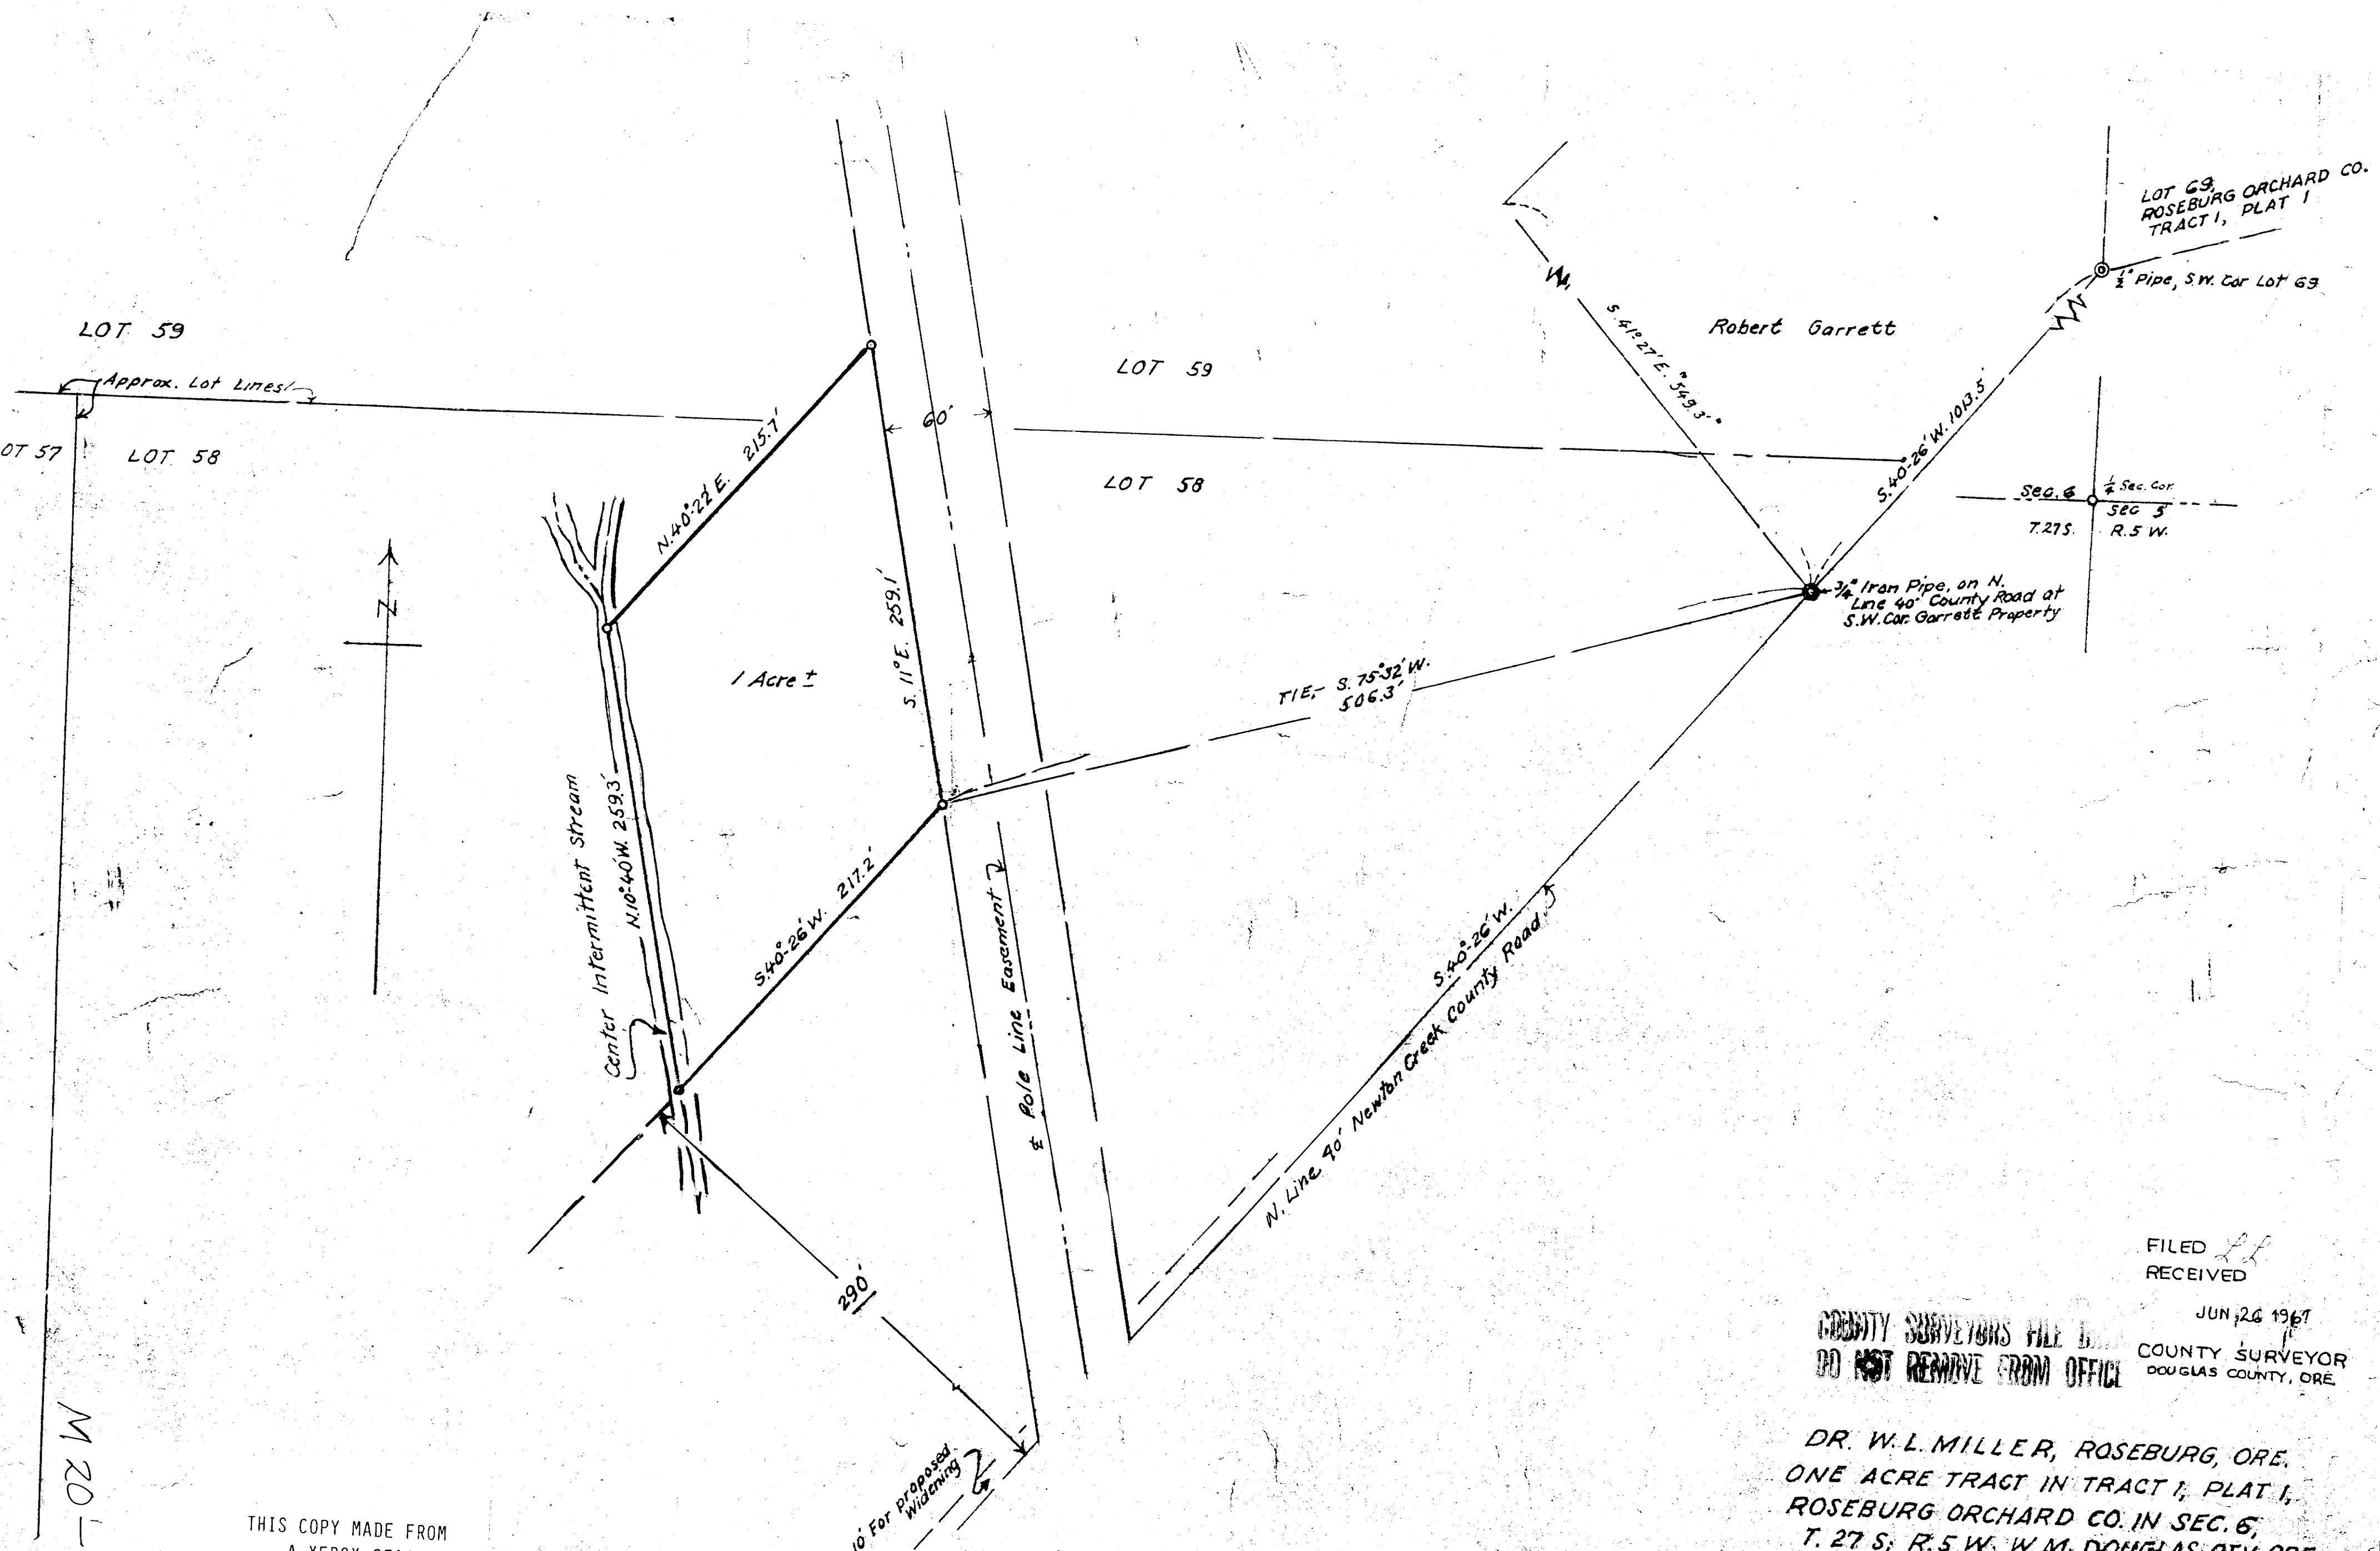


LOT 59

Approx. Lot Lines

LOT 57

LOT 58

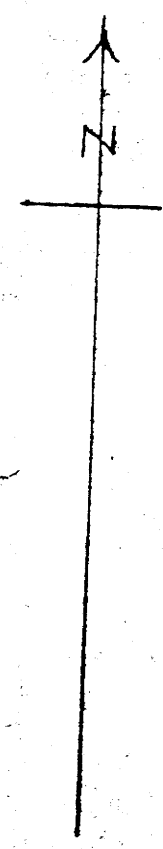

1 Acre ±

Robert Garrett

LOT 69,
ROSEBURG ORCHARD CO.
TRACT 1, PLAT 1

1/2" Pipe, S.W. Cor Lot 69

Sec. 6
1/4 Sec. Cor
SEC 5
7.275.
R. 5 W.

3/4" Iron Pipe, on N.
Line 40' County Road at
S.W. Cor. Garrett Property

TIE - S. 75° 32' W.
506.3'

S. 40° 26' W. 109.5'

S. 40° 26' W.

N. Line 40' Newbr Creek County Road

± Pole Line Easement

290'

10' For Proposed Widening

FILED *ll*
RECEIVED
JUN 26 1967
COUNTY SURVEYOR
DOUGLAS COUNTY, ORE.

COUNTY SURVEYORS FILE D.
DO NOT REMOVE FROM OFFICE

DR. W. L. MILLER, ROSEBURG, ORE.
ONE ACRE TRACT IN TRACT 1, PLAT 1,
ROSEBURG ORCHARD CO. IN SEC. 6,
T. 27 S; R. 5 W, W.M. DOUGLAS CTY, ORE.
MAY, 1961

Arthur Boyer 1" = 60 ft.

THIS COPY MADE FROM
A XEROX 2510
DATE July 19, 89

M 20-67