


COUNTY SURVEYORS FILE DATA  
DO NOT REMOVE FROM OFFICE

# SURVEY FOR DEED DESCRIPTION IN SEC. 11 & 14, T.27 S., R.6 W., W.M. DOUGLAS COUNTY, OREGON

SURVEYED FOR: USFS RESEARCH CENTER  
SURVEYED BY: G. R. LECKLIDER - ENGINEER

JULY, 1961  
SCALE: 1" = 60'


• DENOTES STEEL TUBE WITH SURVEY CAP SET.

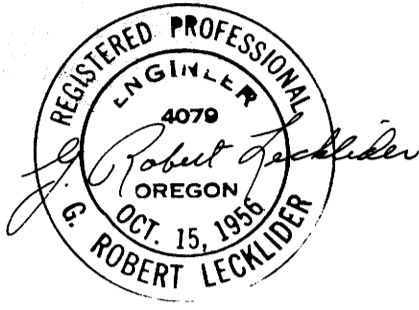

GARDEN

VALLEY

BLVD.

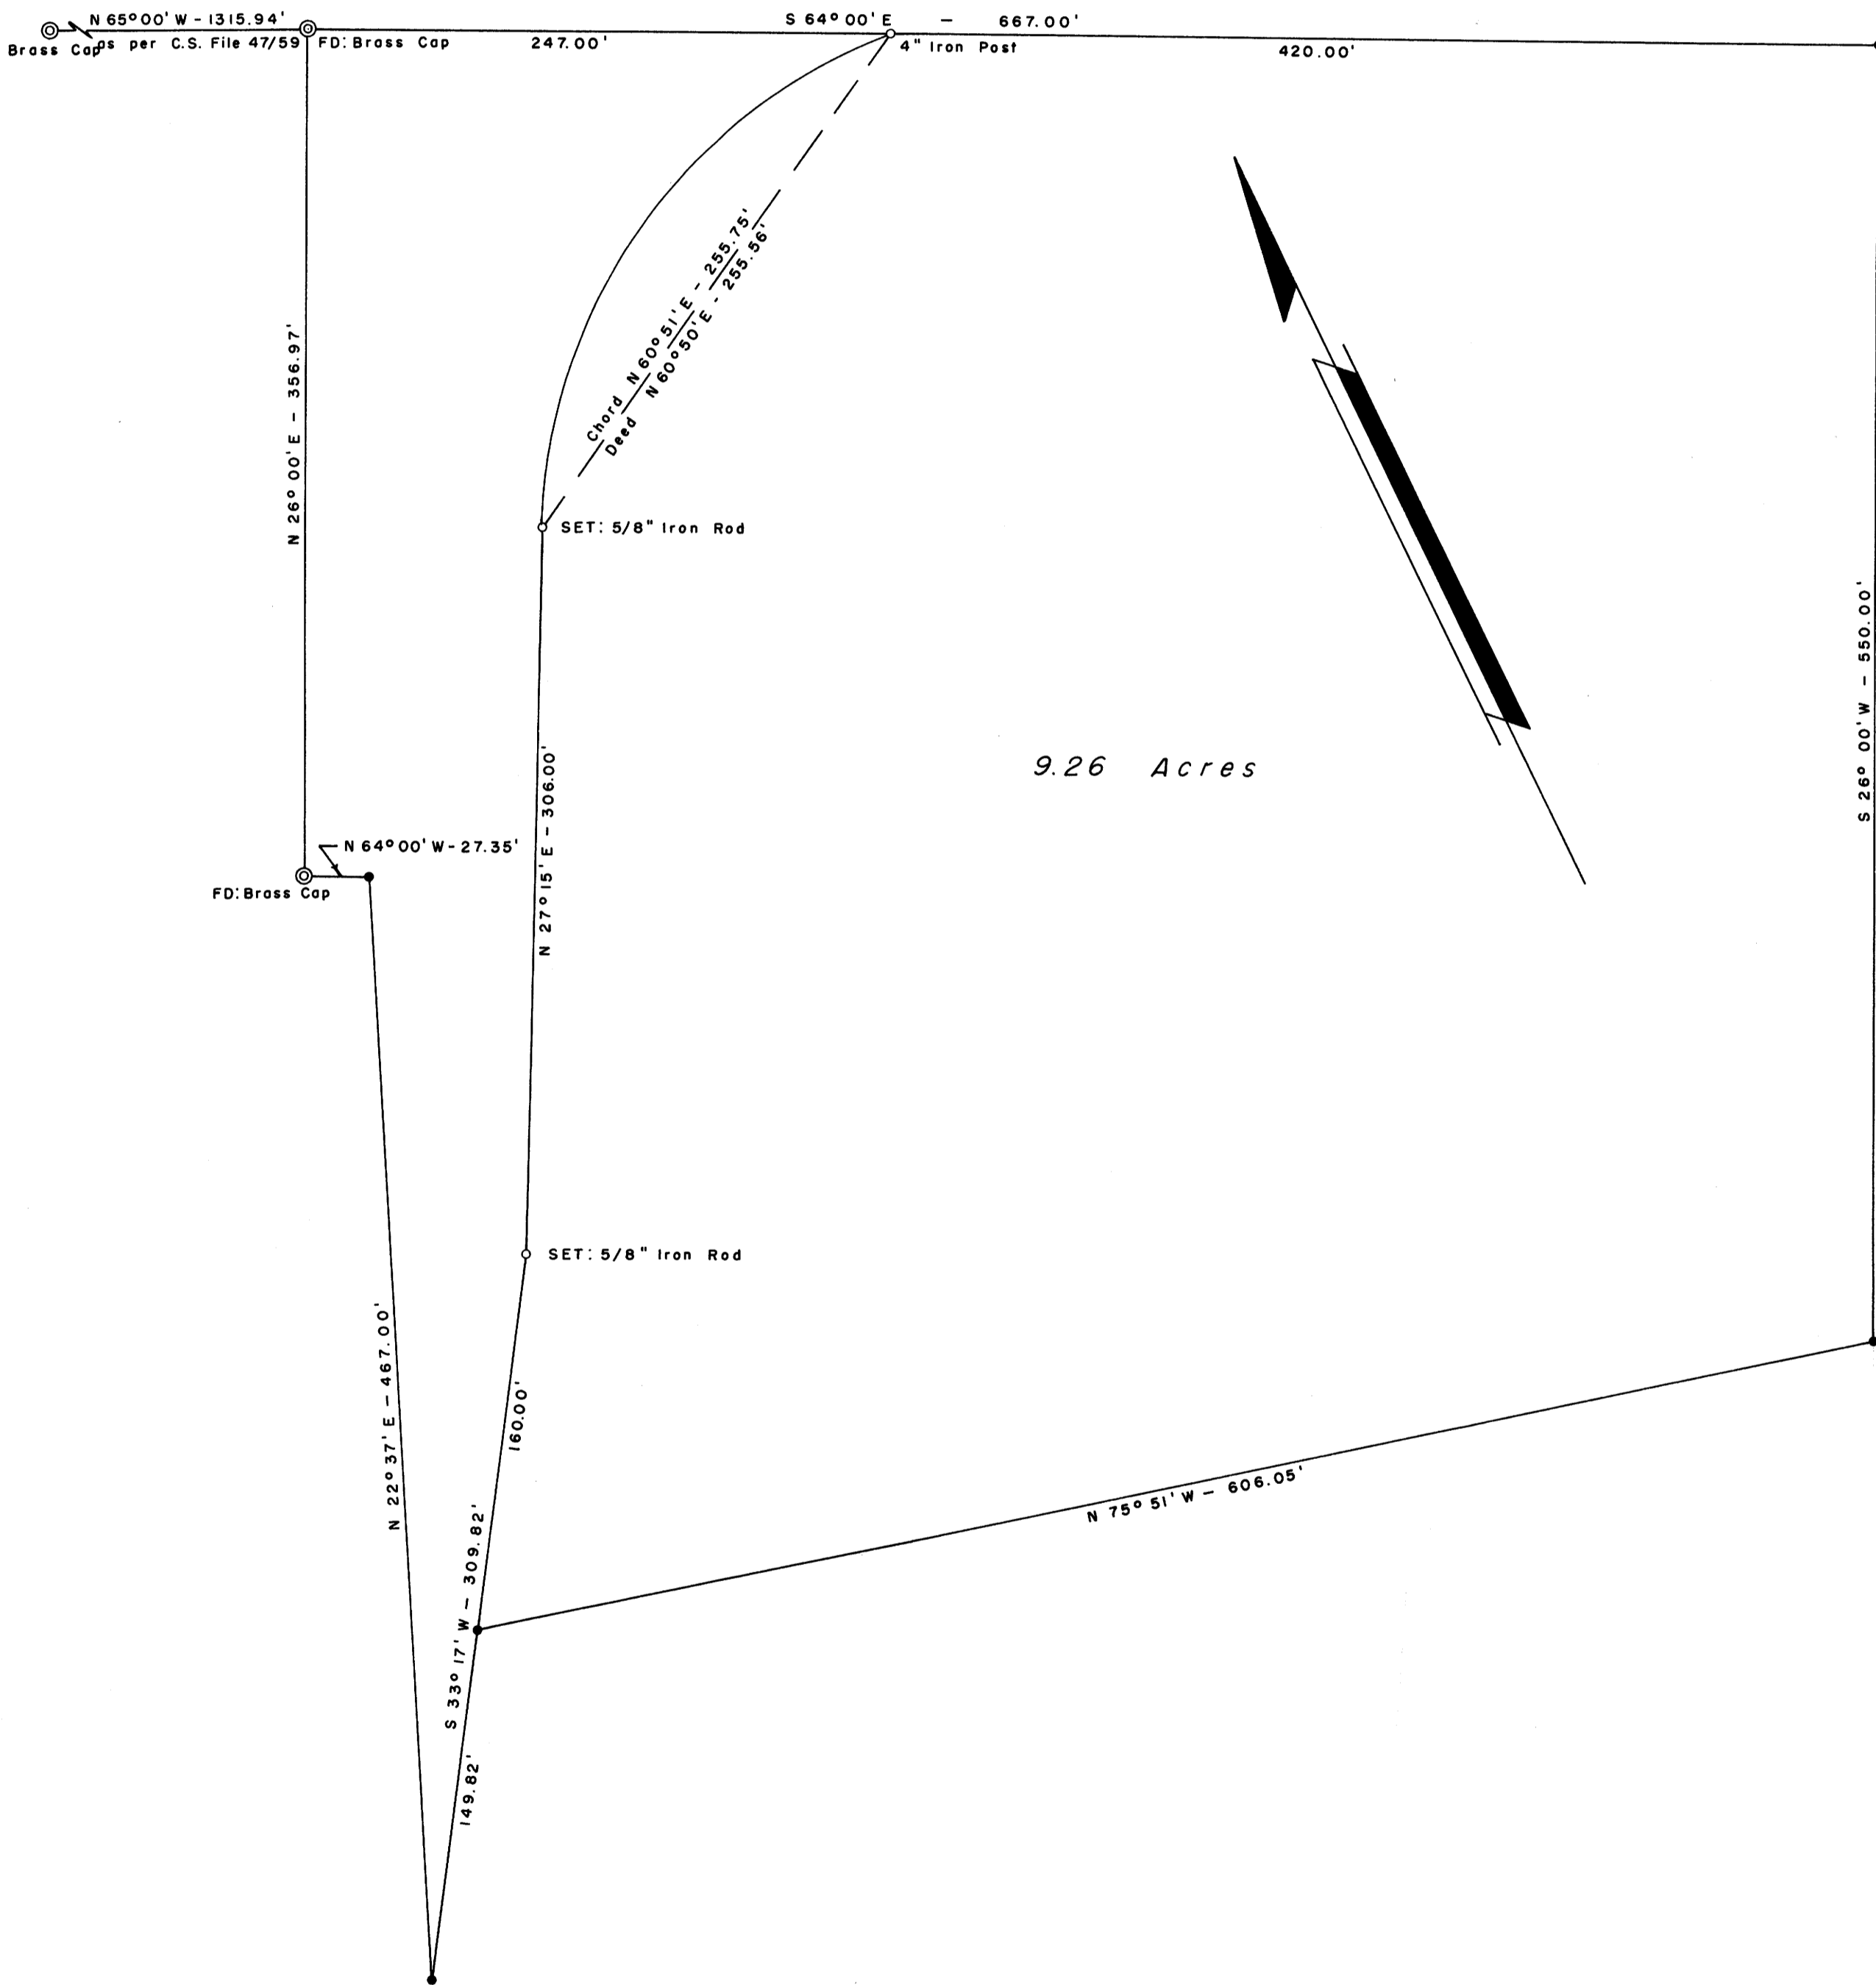

FILED  
RECEIVED *L.L.*  
JUL 1 1961  
COUNTY SURVEYOR  
DOUGLAS COUNTY, ORE.