


SURVEY TO ESTABLISH PROPERTY LINES IN SEC. 35, T 25 S, R 5 W & SECS. 2 & 11, T 26 S, R 5 W

SURVEYED FOR: BERNARD GRUBBE
SEPTEMBER: 1961
SURVEYED BY: G. R. LECKLIDER-ENGR.
SCALE: 1" = 1000'

ALL BEARINGS BASED ON SOLAR OBSERVATIONS.

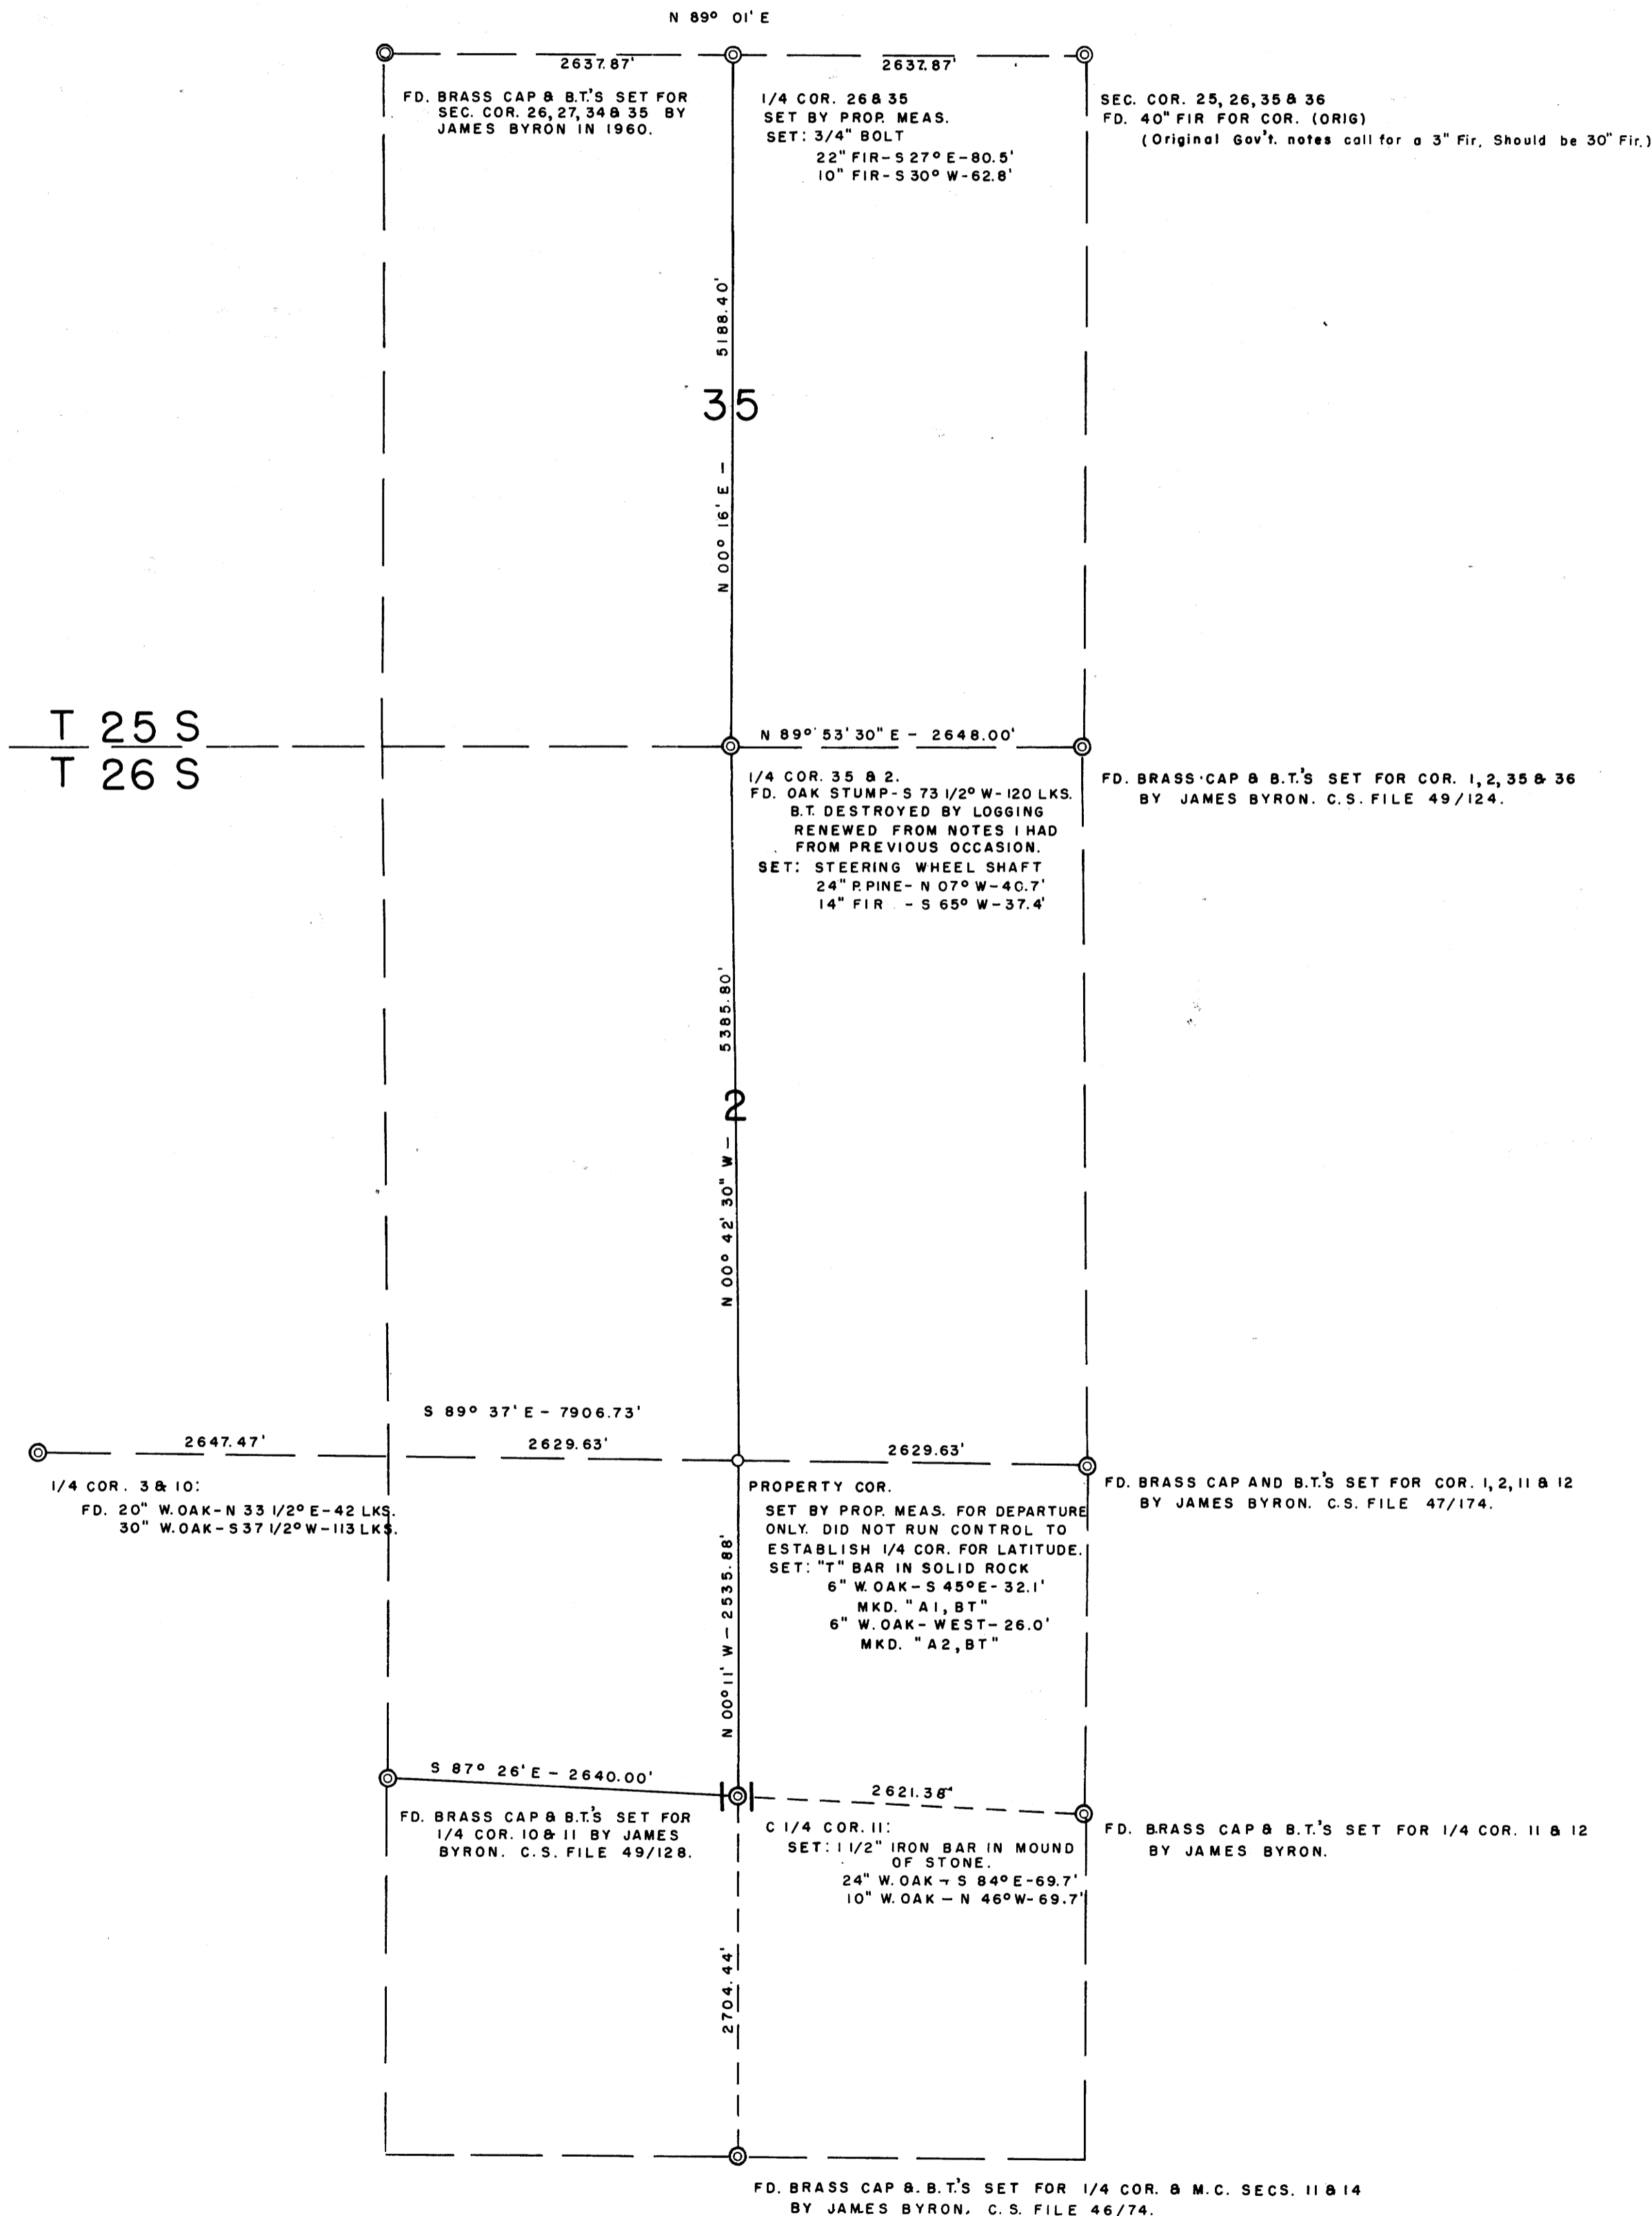

FILED L.L.
RECEIVED

COUNTY SURVEYOR
CLATSOP COUNTY, ORE.