

Fd 3/4 1. Pipe
with New 1/2" I.P.
Alongside

There is a stump
with scribble South
About 4. ft.

Fd. post
R.W. post
Steel Rod


Fd 3/4 1. Pipe

FILED *L.L.*
RECEIVED

OCT 27 1961

COUNTY SURVEYOR
DOUGLAS COUNTY, ORE.

SURVEY FOR DEED DESCRIPTION
LEVI SCOTT D.L.C.# 37, T.22 S., R.9 W.
for
FRANK CUNNINGHAM SCOTTSBURG, OREG.
Scale 1" = 40' Nov. 1961

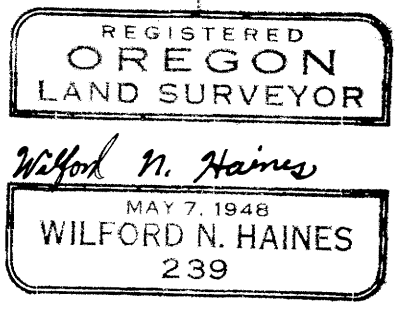

684.7

5.04° 35' W

