


MAP
OF
LOTS-151-152-153-154 & 155
Tract-1 Plat-1
ROSEBURG ORCHARD CO.
Sections-6 & 7 T_p.27S-R_g.5W W.M.
Scale-1"=100'

COUNTY SURVEYOR
DO NOT REMOVE FROM FILE

M 21-43

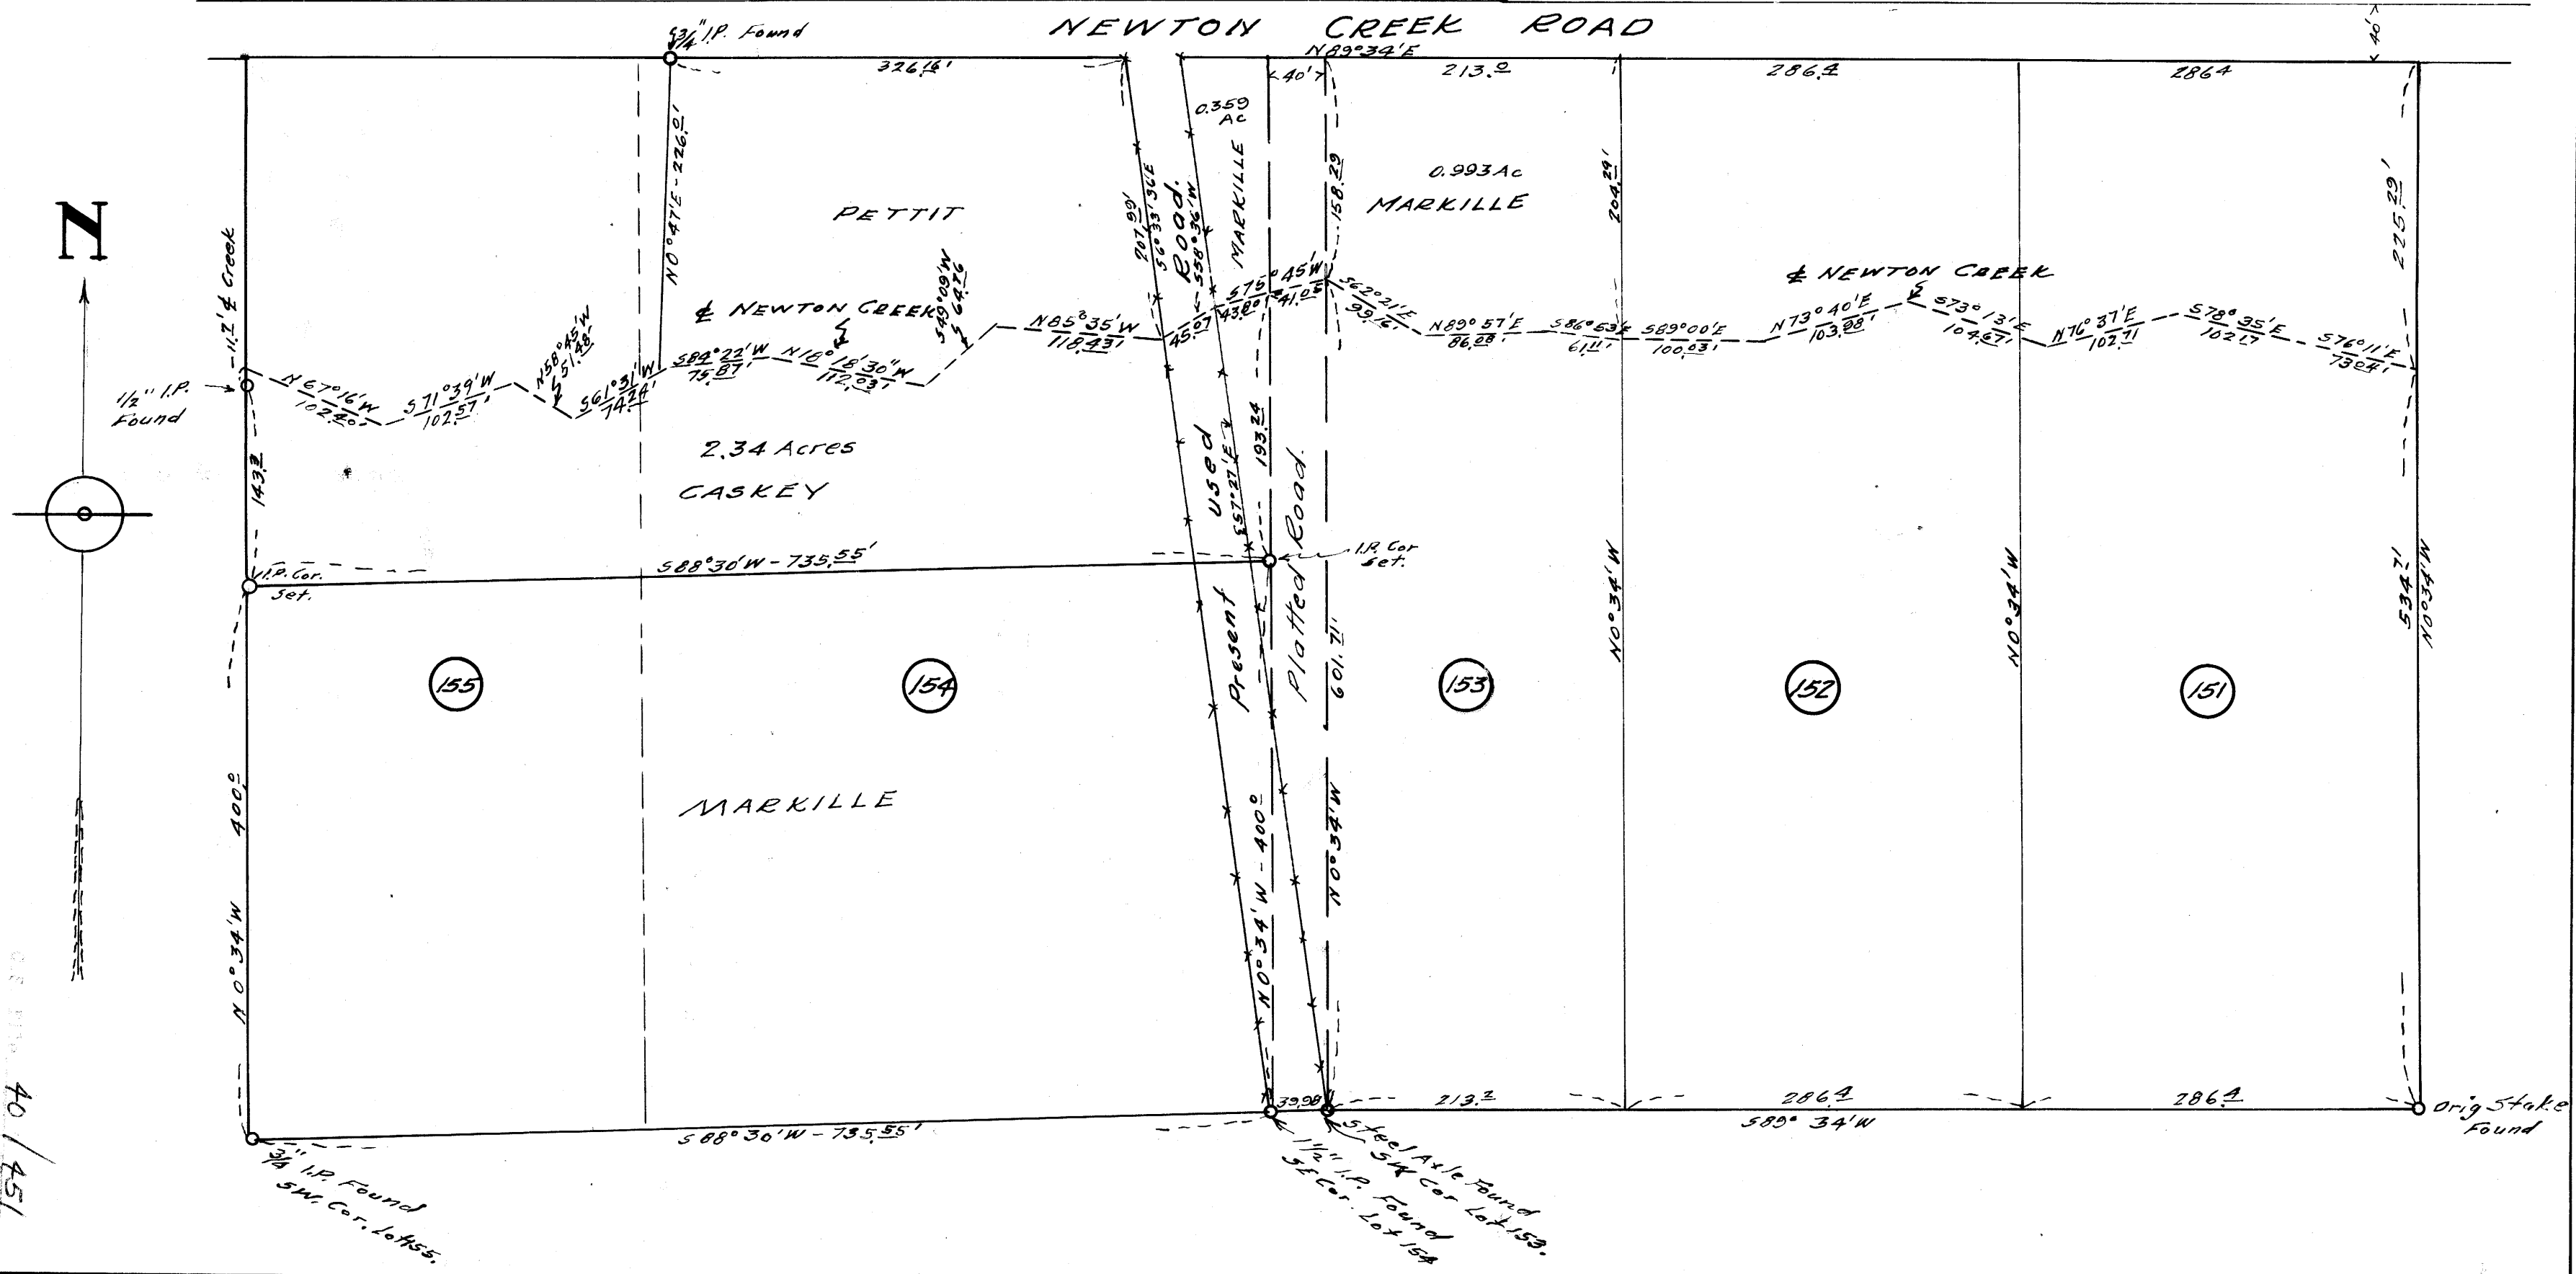

M 21-43
40/451

CS FILE FOLDER

CONTAINS

MORE

INFORMATION