


FILED
RECEIVED
JUN 7 1956
COUNTY SURVEYOR
CLATSOP COUNTY, ORE.

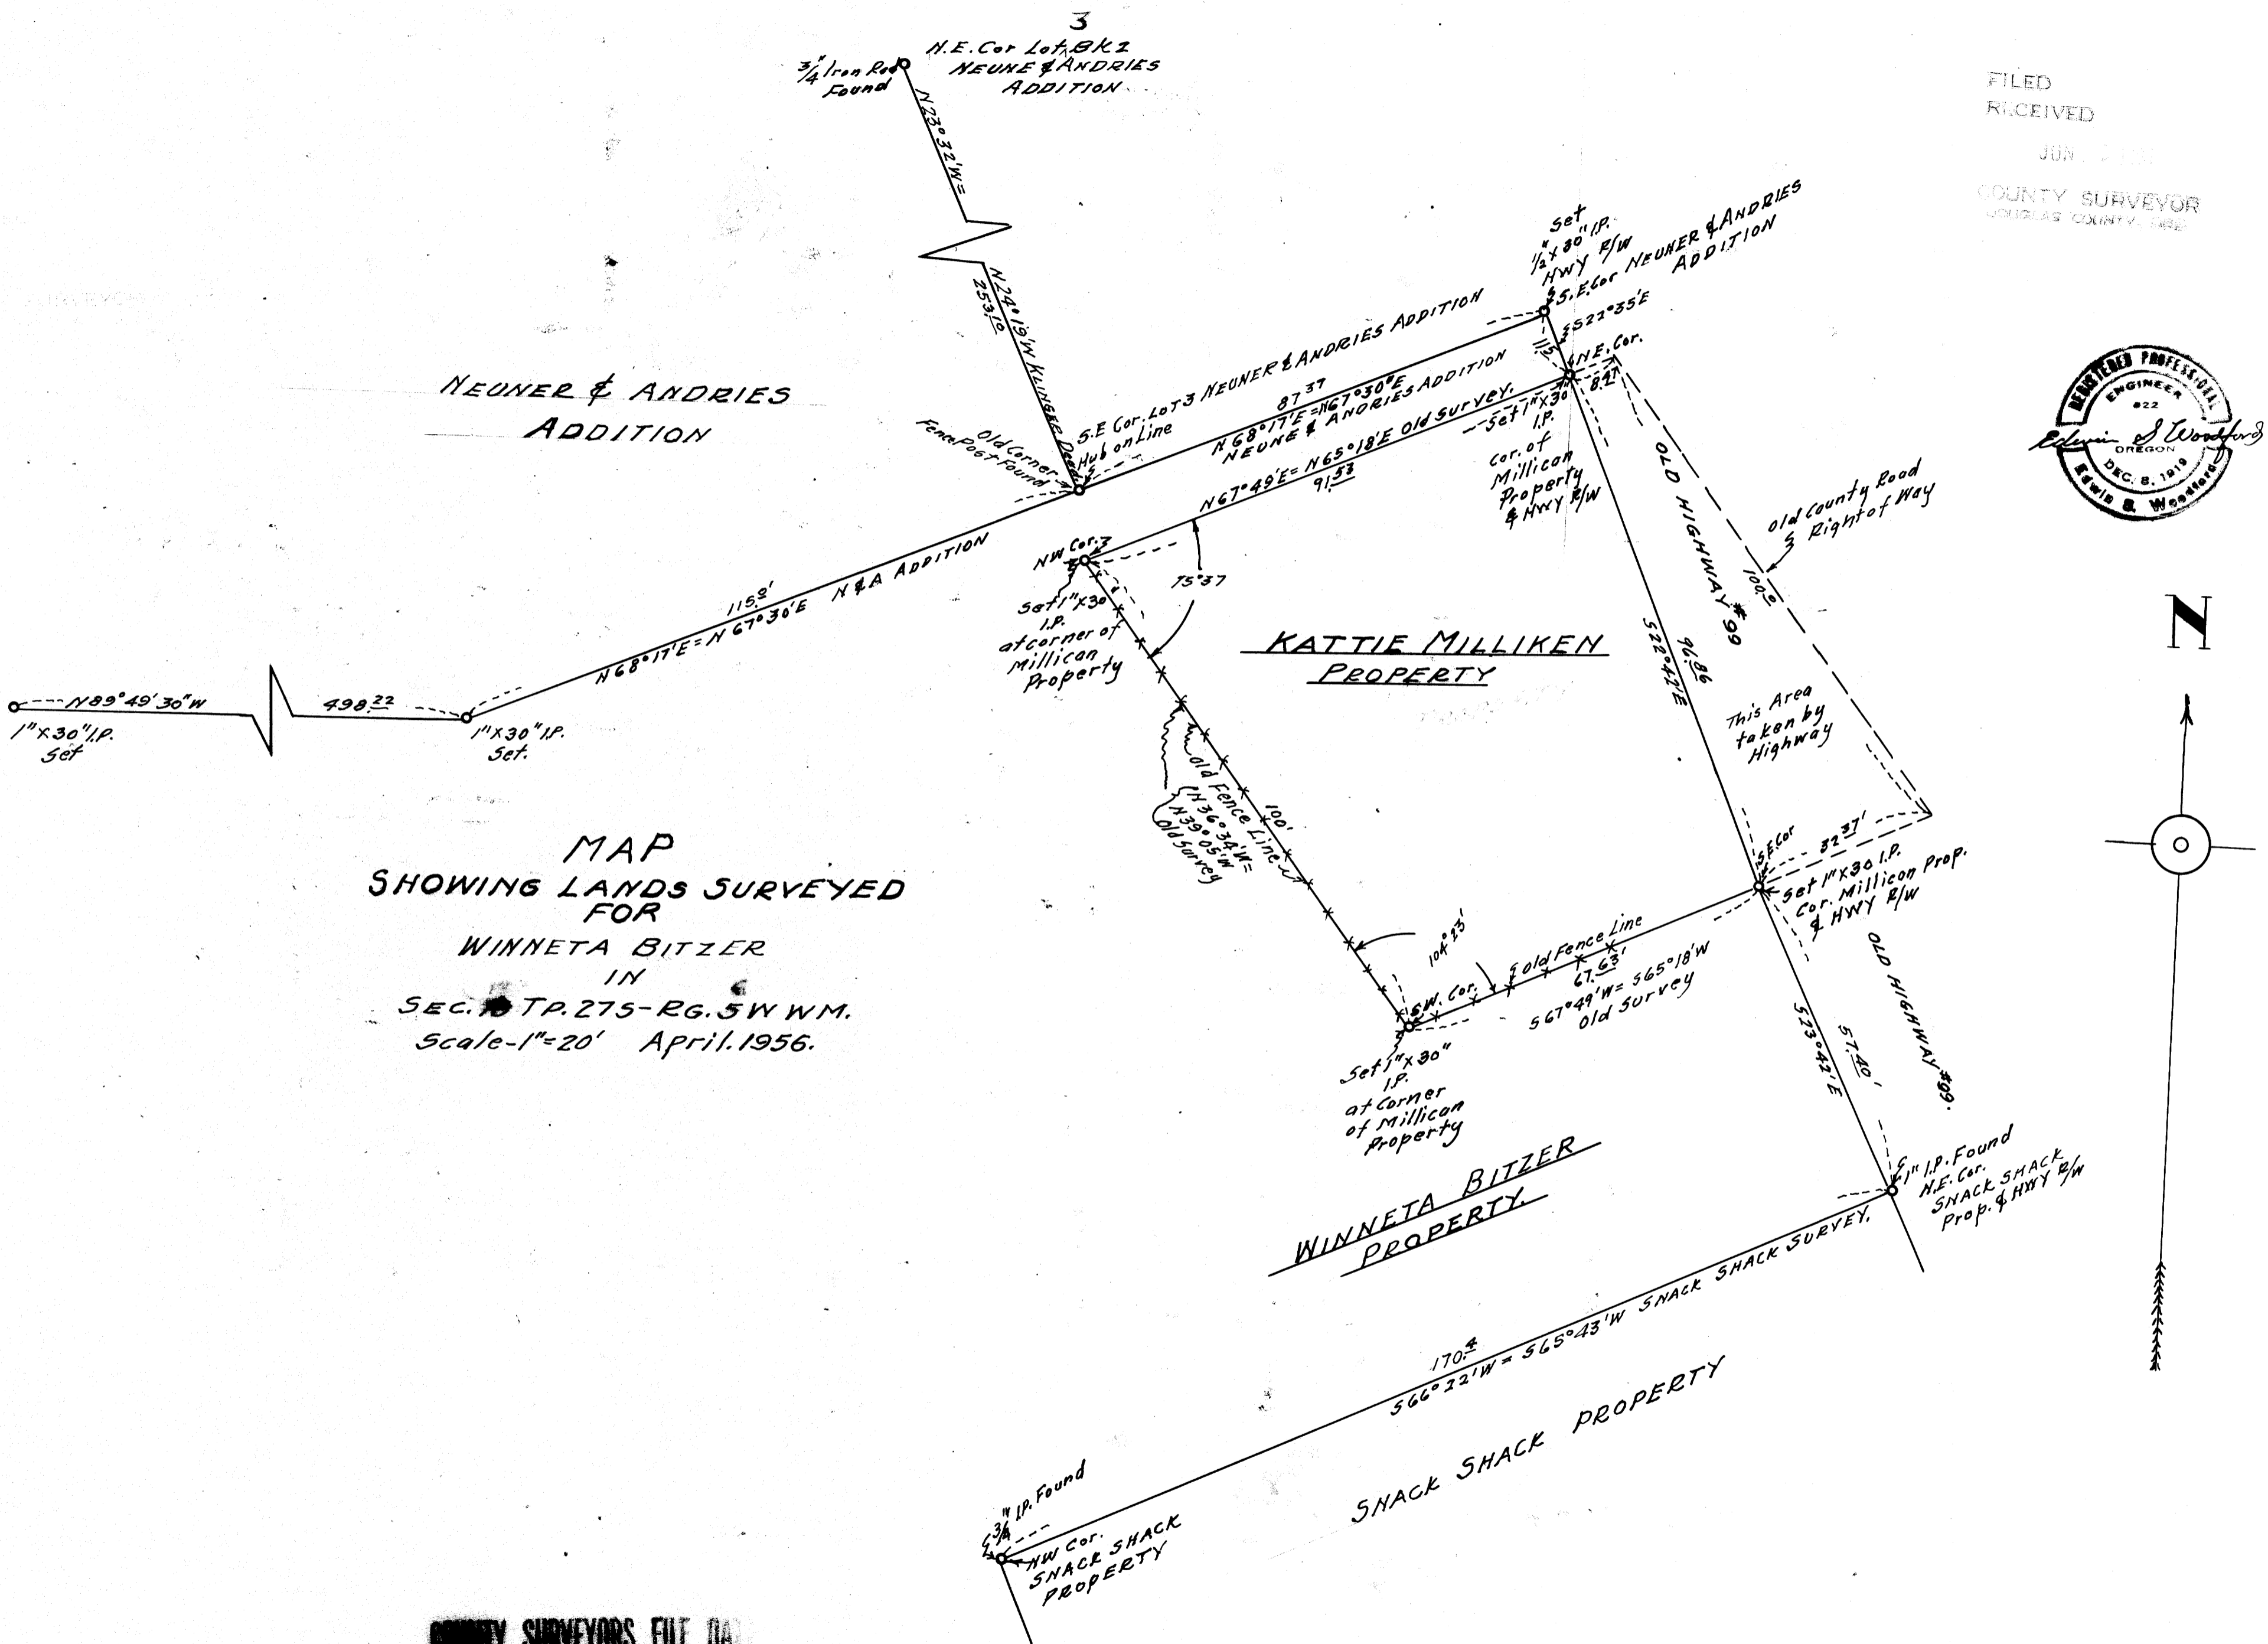

MAP
SHOWING LANDS SURVEYED
FOR
WINNETA BITZER
IN
SEC. 10 TP. 27S-RG. 5W WM.
Scale-1"=20' April, 1956.

COUNTY SURVEYORS FILE DATA
DO NOT REMOVE FROM OFFICE