

FIELD SURVEY & PLAT FOR  
MRS. IMARTHE THOMAS  
 CANYONVILLE, OREGON  
 SEC. 21, T30S, R5W, W.M., DOUGLAS COUNTY, OREGON  
 SCALE: 1 IN. = 50 FT.

MARTIN ENGINEERING SERVICE ~ MYRTLE CREEK, ORE.

DEEDS: Vol. 128, P. 531; Vol. 155, P. 172


**COUNTY SURVEYOR**  
 DO NOT REMOVE FROM

OCTOBER 1961

FILED RECEIVED

COUNTY SURVEYOR  
 DOUGLAS COUNTY, ORE.

• SET 3/4" IRON PIPE

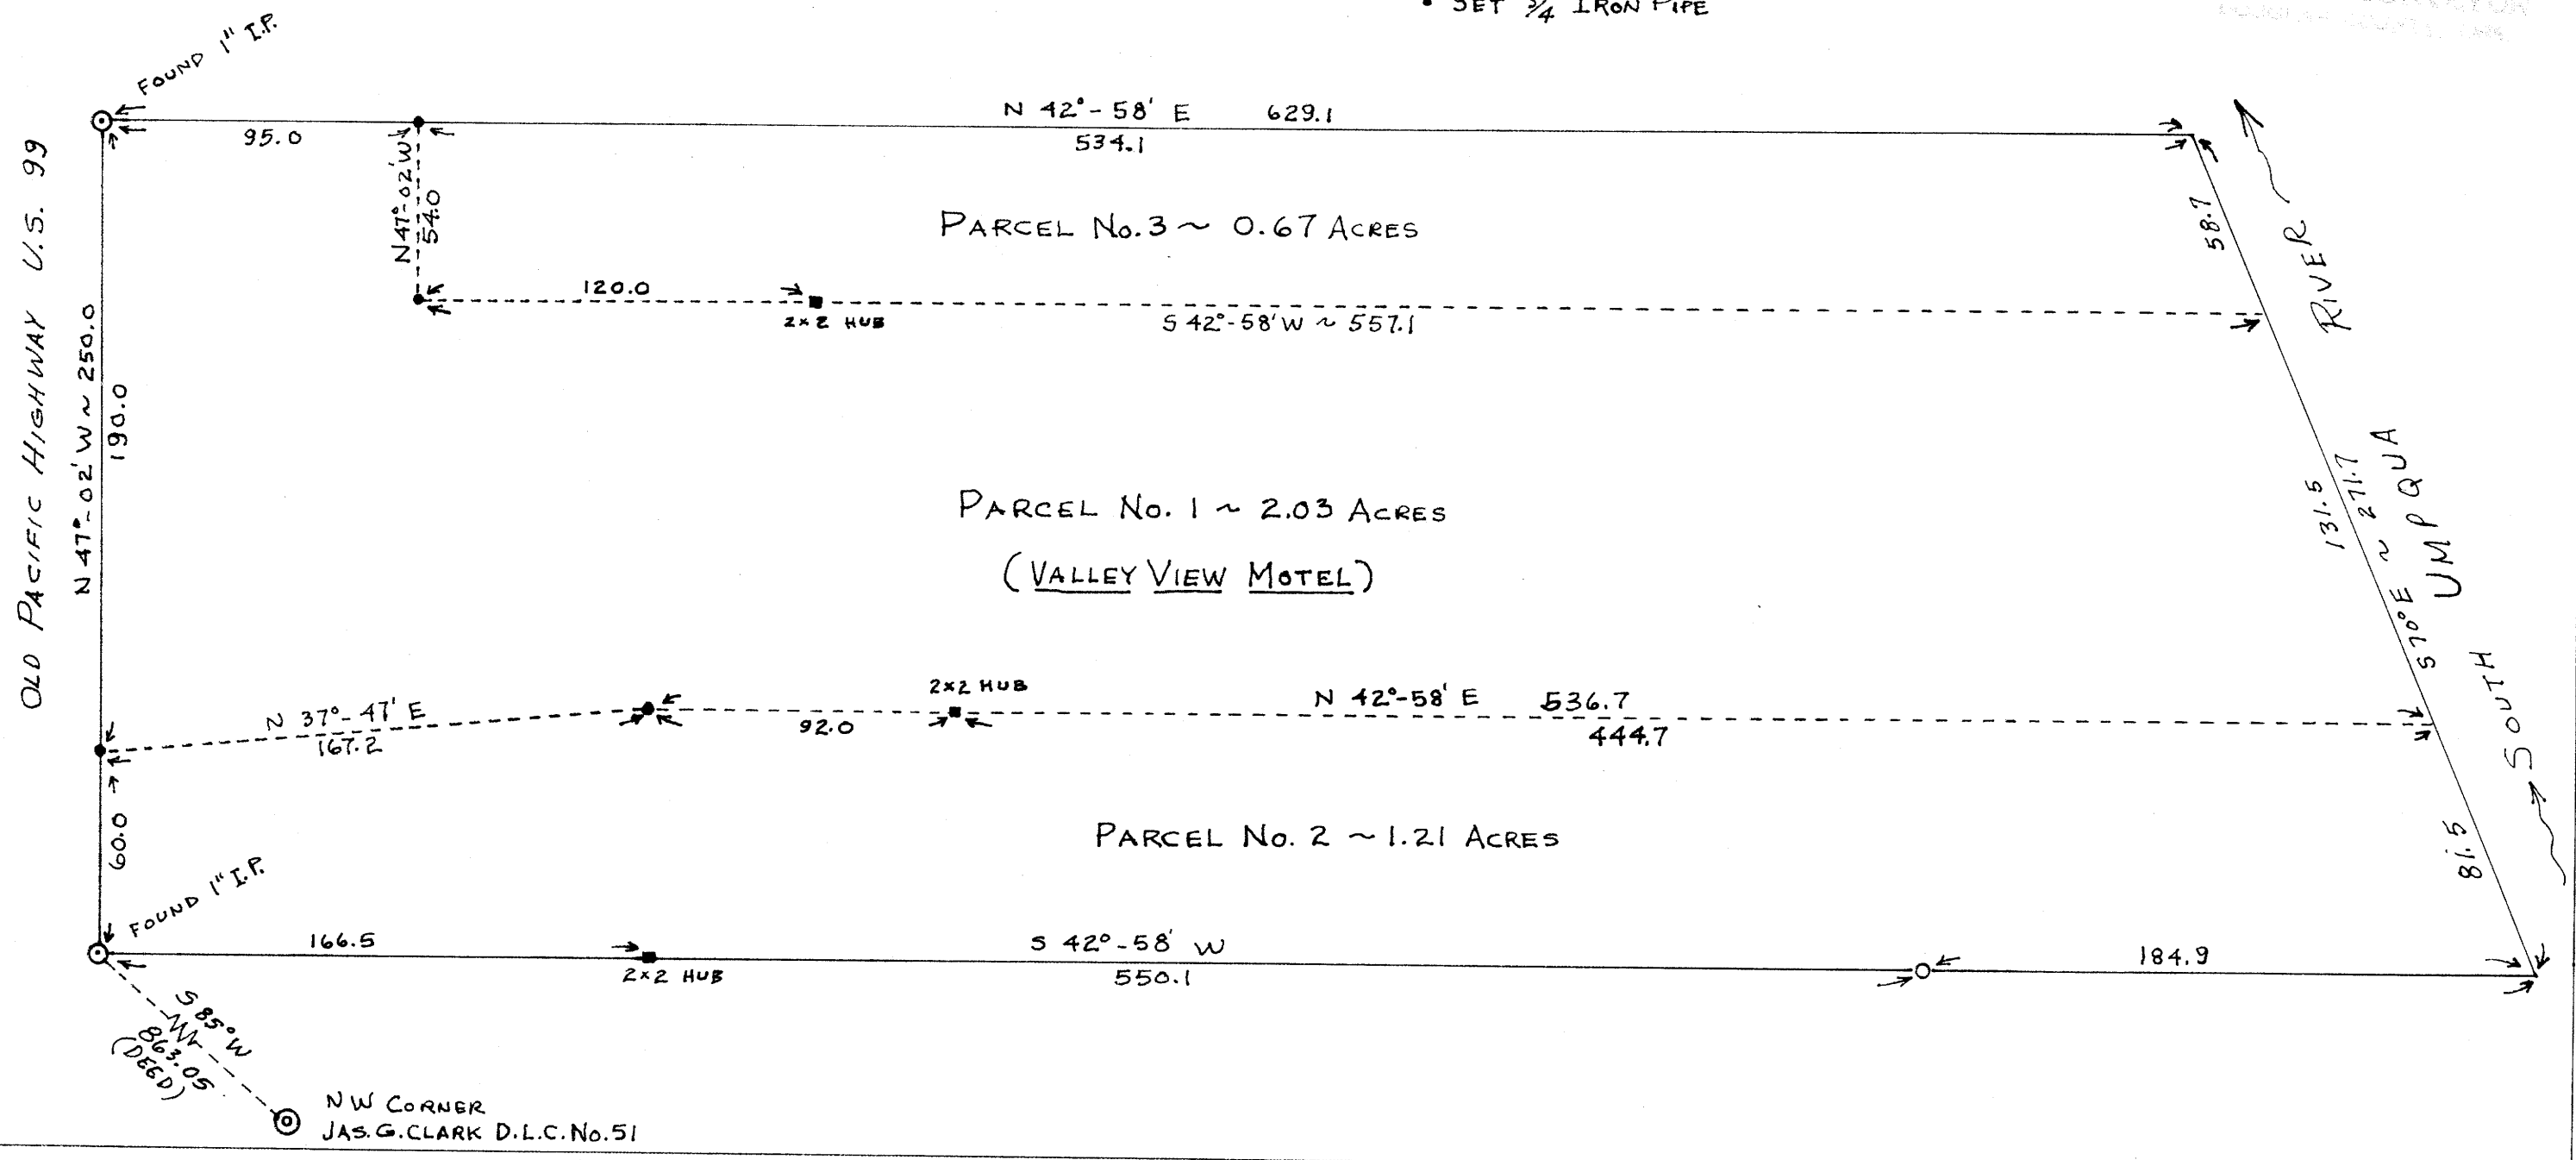

OLD PACIFIC HIGHWAY U.S. 99

M 21-66

M 21-66