


1/4 Sec. Cor  
21  
28

Sec. Cor  
21 22  
28 27

3/4" Iron Pipe set by A. Boyer  
Dep. Co. Surveyor Jan 1939  
1/2 way between Sec. Cor & 1/4 Cor

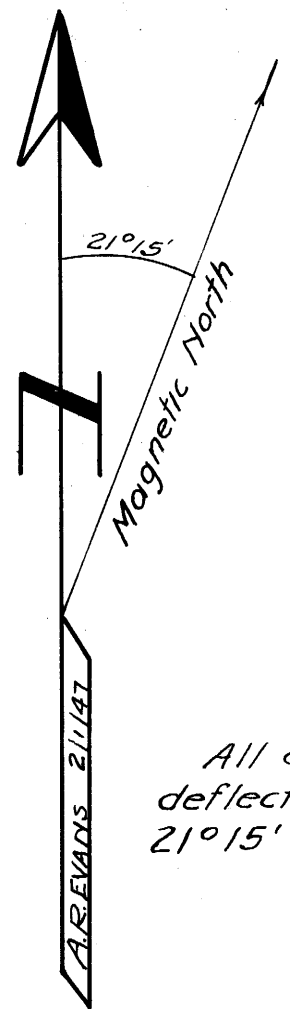

All angles turned by  
deflection. Assumed Variation  
21° 15'

1/2 Road to NE 1/4 NE 1/4  
Sec 28 T28S R5W

Iron Bolt  
S 56° 25' W 153.8

Iron Bolt  
N 1° 30' E 333.82

22.1' Gate

West Boundary L.B. Atterbury Property N 01° 30' E 1312.6

L.B. ATTERBURY

ROAD

**COUNTY SURVEYOR'S OFFICE  
DOUGLAS COUNTY OREGON**

**SURVEY OF WEST BOUNDARY  
L.B. ATTERBURY PROPERTY IN  
NE 1/4 NE 1/4 SECTION 28, T28S, R5W. W.M.**

**BEN B IRVING COUNTY SURVEYOR  
SURVEYED JAN. 24 1947 BY  
N.E. RICHARDSON DEPUTY  
SCALE 1" = 100'**

REGISTERED  
OREGON  
LAND SURVEYOR

N.E. Richardson  
JULY 7, 1888  
N. E. RICHARDSON  
85

Iron Bar set by A. Boyer  
Dep. Co. Surveyor, Jan. 1939  
from reference, Survey 1893

HOUSE

S 56° 25' W 33'

**COUNTY SURVEYORS FILE ONLY  
DO NOT REMOVE FROM OFFICE**