

02-12W



PARCELS IN SECTION 36 T.28 S. R.8 W. OREGON

DOUGLAS COUNTY W.M. (TENMILE)

COUNTY SURVEYORS FILE THIS
DO NOT REMOVE FROM FILE

surveyed for
Mrs. Eva Lakey
LOOKWOOD ROAD TENMILE

THIS COPY MADE FROM
A XEROX 2510
DATE July 21, 89

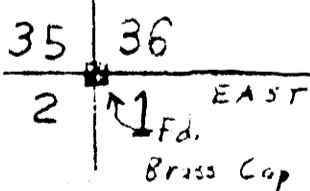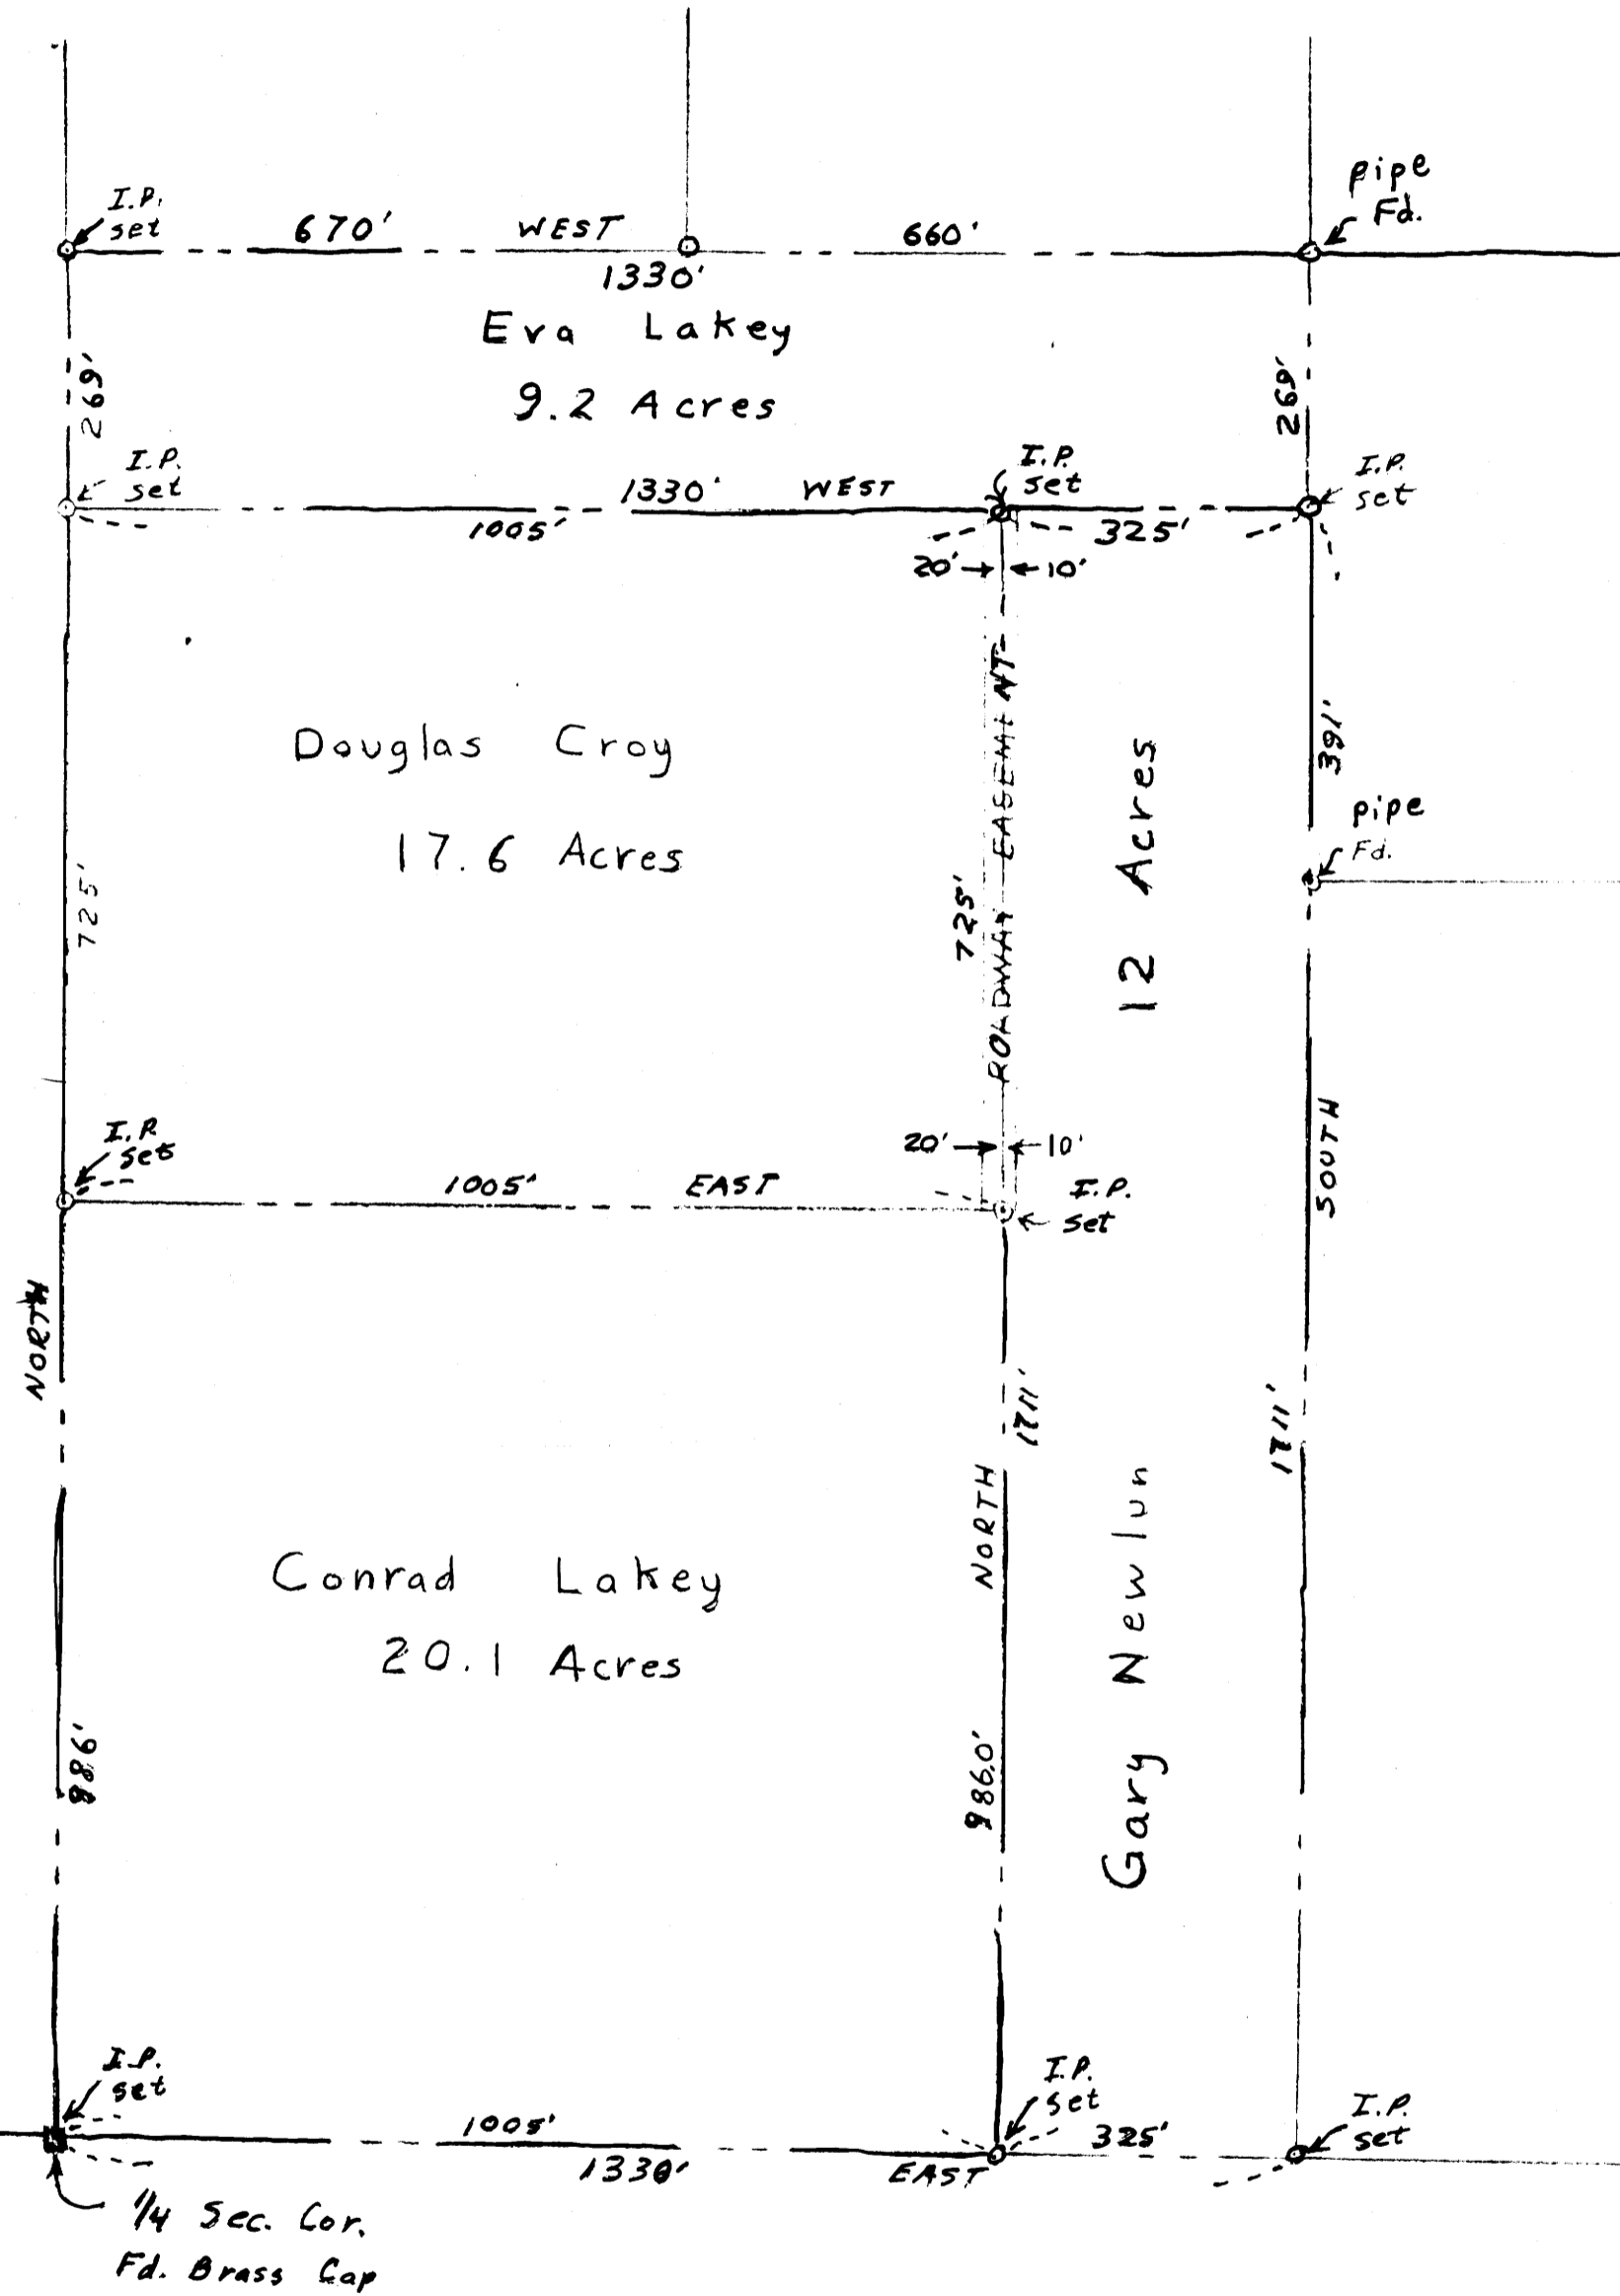

FILED
RECEIVED

DEC 12 1961

surveyed by
JAMES R. DAUGHERTY
Civil-SANITARY ENGINEER
WINSTON, OREGON

COUNTY SURVEYOR
DOUGLAS COUNTY, ORE.

o - denotes 1/2 inch iron p.n

Scale 1" = 200'

November 17, 1961
Rev. Dec. 11, 1961

M 21-70