

FB H-47
W 21-73

COUNTY SURVEYORS
DO NOT REMOVE FROM


SECT. 12, T. 21 S., R. 7 W., W.M.

Dec 1961

Scale 1"=500'

Woolley Logging Co.

Drain Oreg.

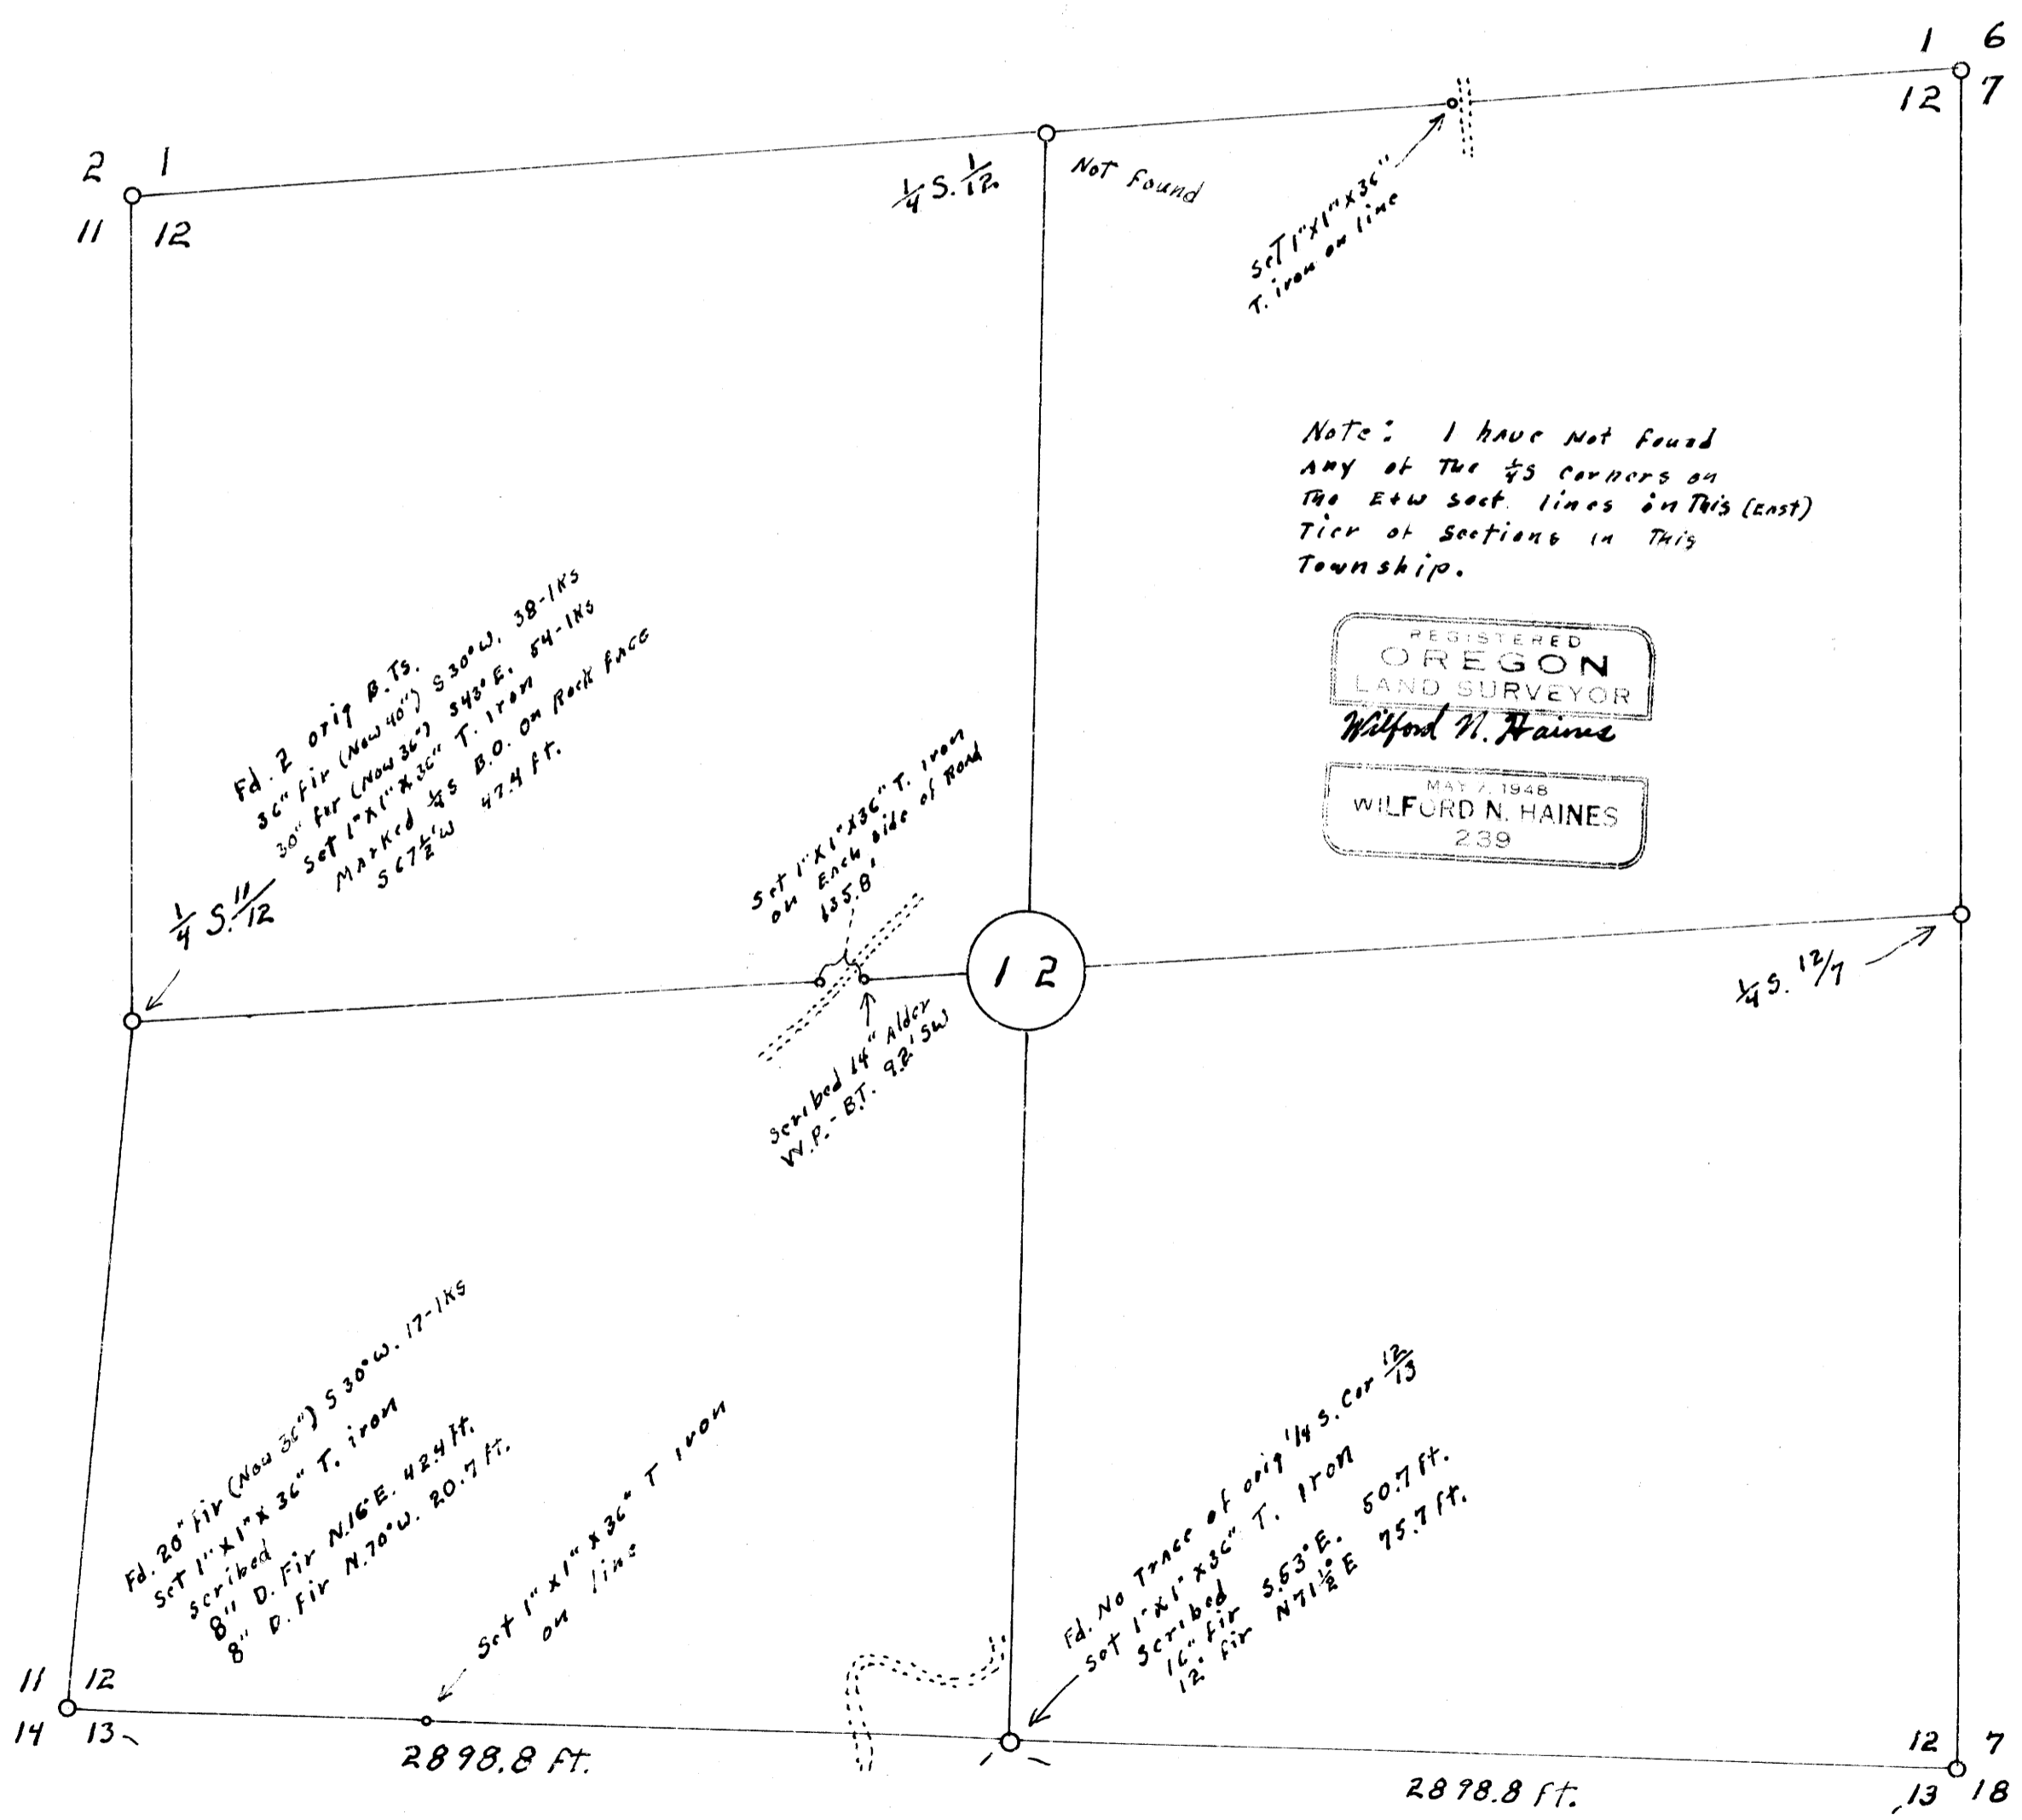

FILED
RECEIVED

MAP FILE M 21 + 73
FB. H-47