
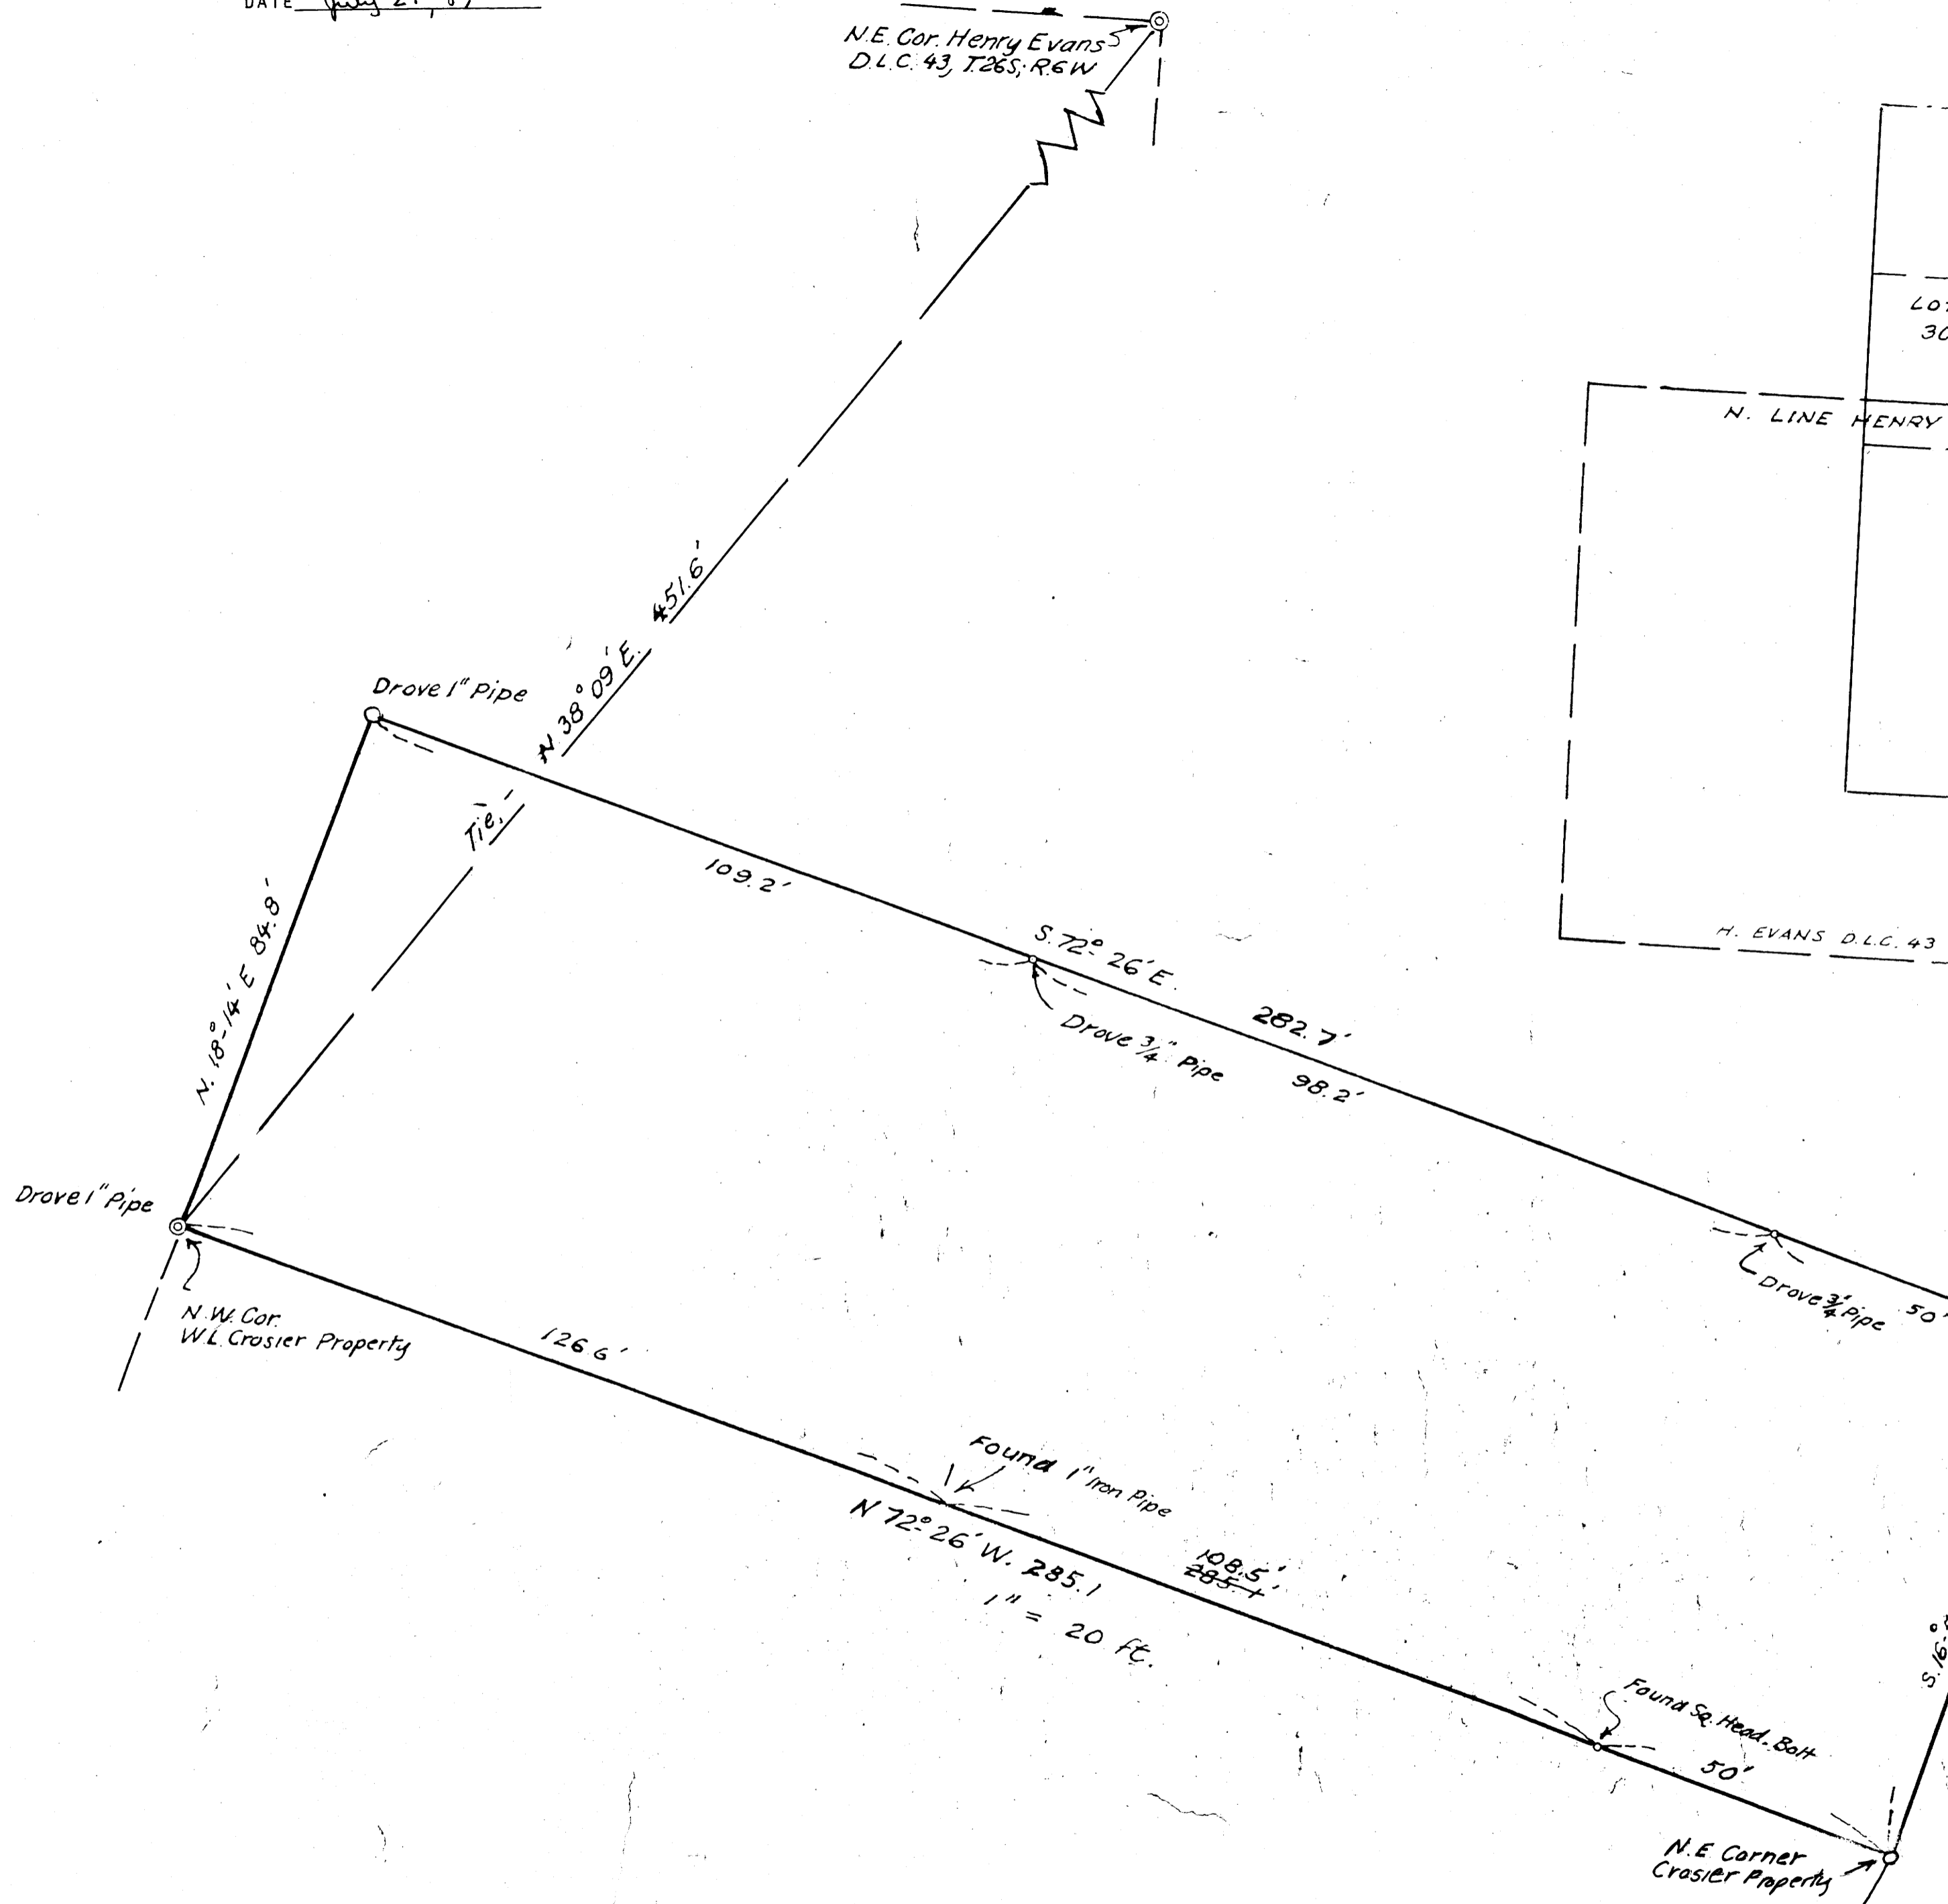


DATE July 24, 89

N.E. Cor. Henry Evans
D.L.C. 43, T.26S, R.6W

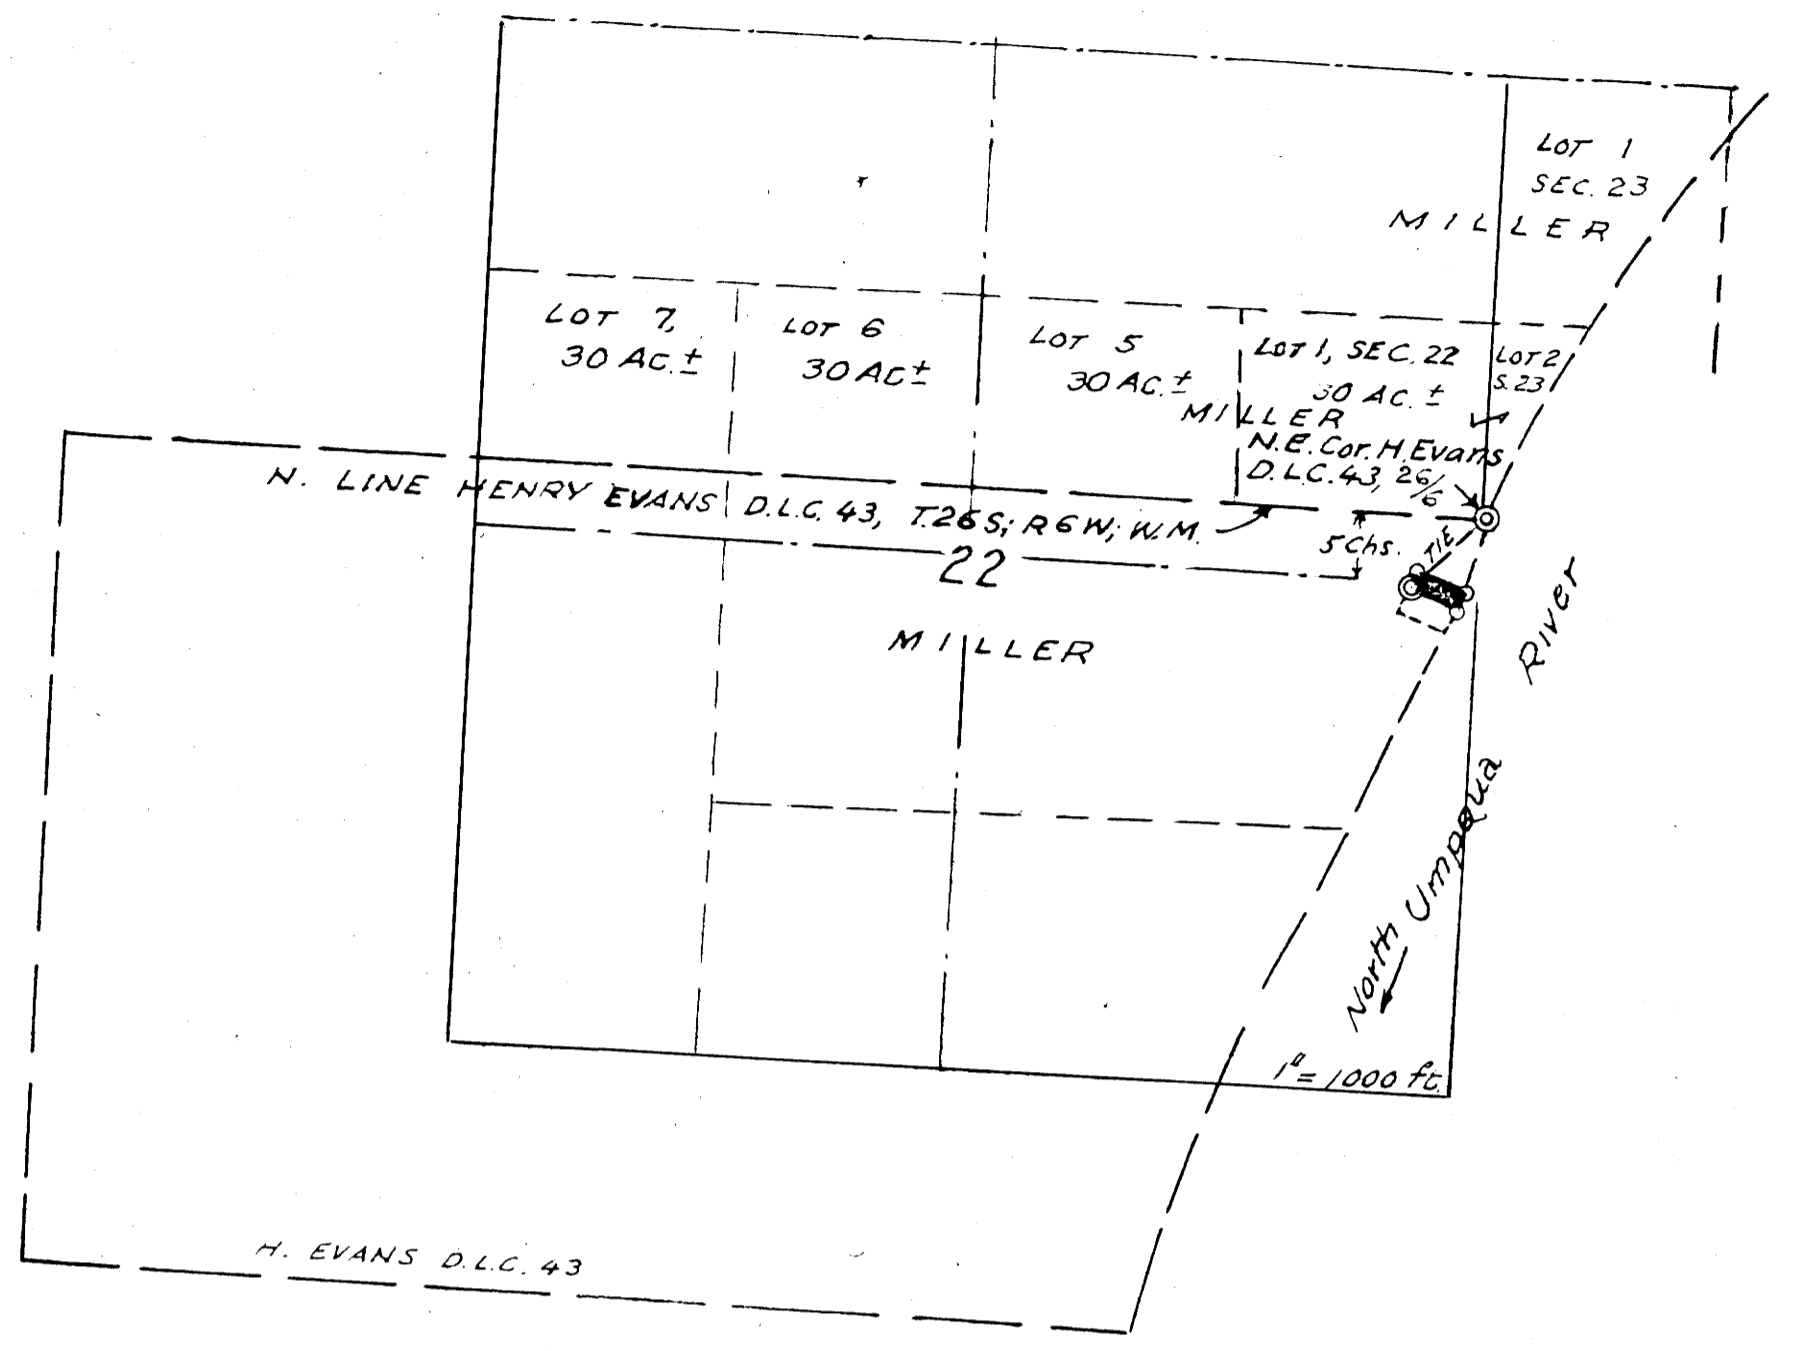

FILED
RECEIVED
SEP 29 1961
COUNTY SURVEYOR
DOUGLAS COUNTY, ORE

MILLER TO JONES PROPTY TRANSFER,
IN THE HENRY EVANS DON.LND.CLAIM #43,
IN SEC. 22, T.26S; R.6W, WIL.MERIDIAN,
DOUGLAS COUNTY, OREGON.
JULY, 1961
Arthur Jones
SCALE AS SHOWN.

M22-14