


COUNTY ENGINEER FILE DAY  
DO NOT REMOVE FROM OFFICE

FILED  
RECEIVED  
JUN 13 1919  
COUNTY SURVEYOR  
DOUGLAS COUNTY, ORE.

MAP  
SHOWING portion of SUTHERLIN D.L.C. No 49  
North of CALAPOOIA RIVER.  
Sections 9 and 10 Tp. 25S-Rg. 4W.W.M.  
SCALE - 1" = 200'

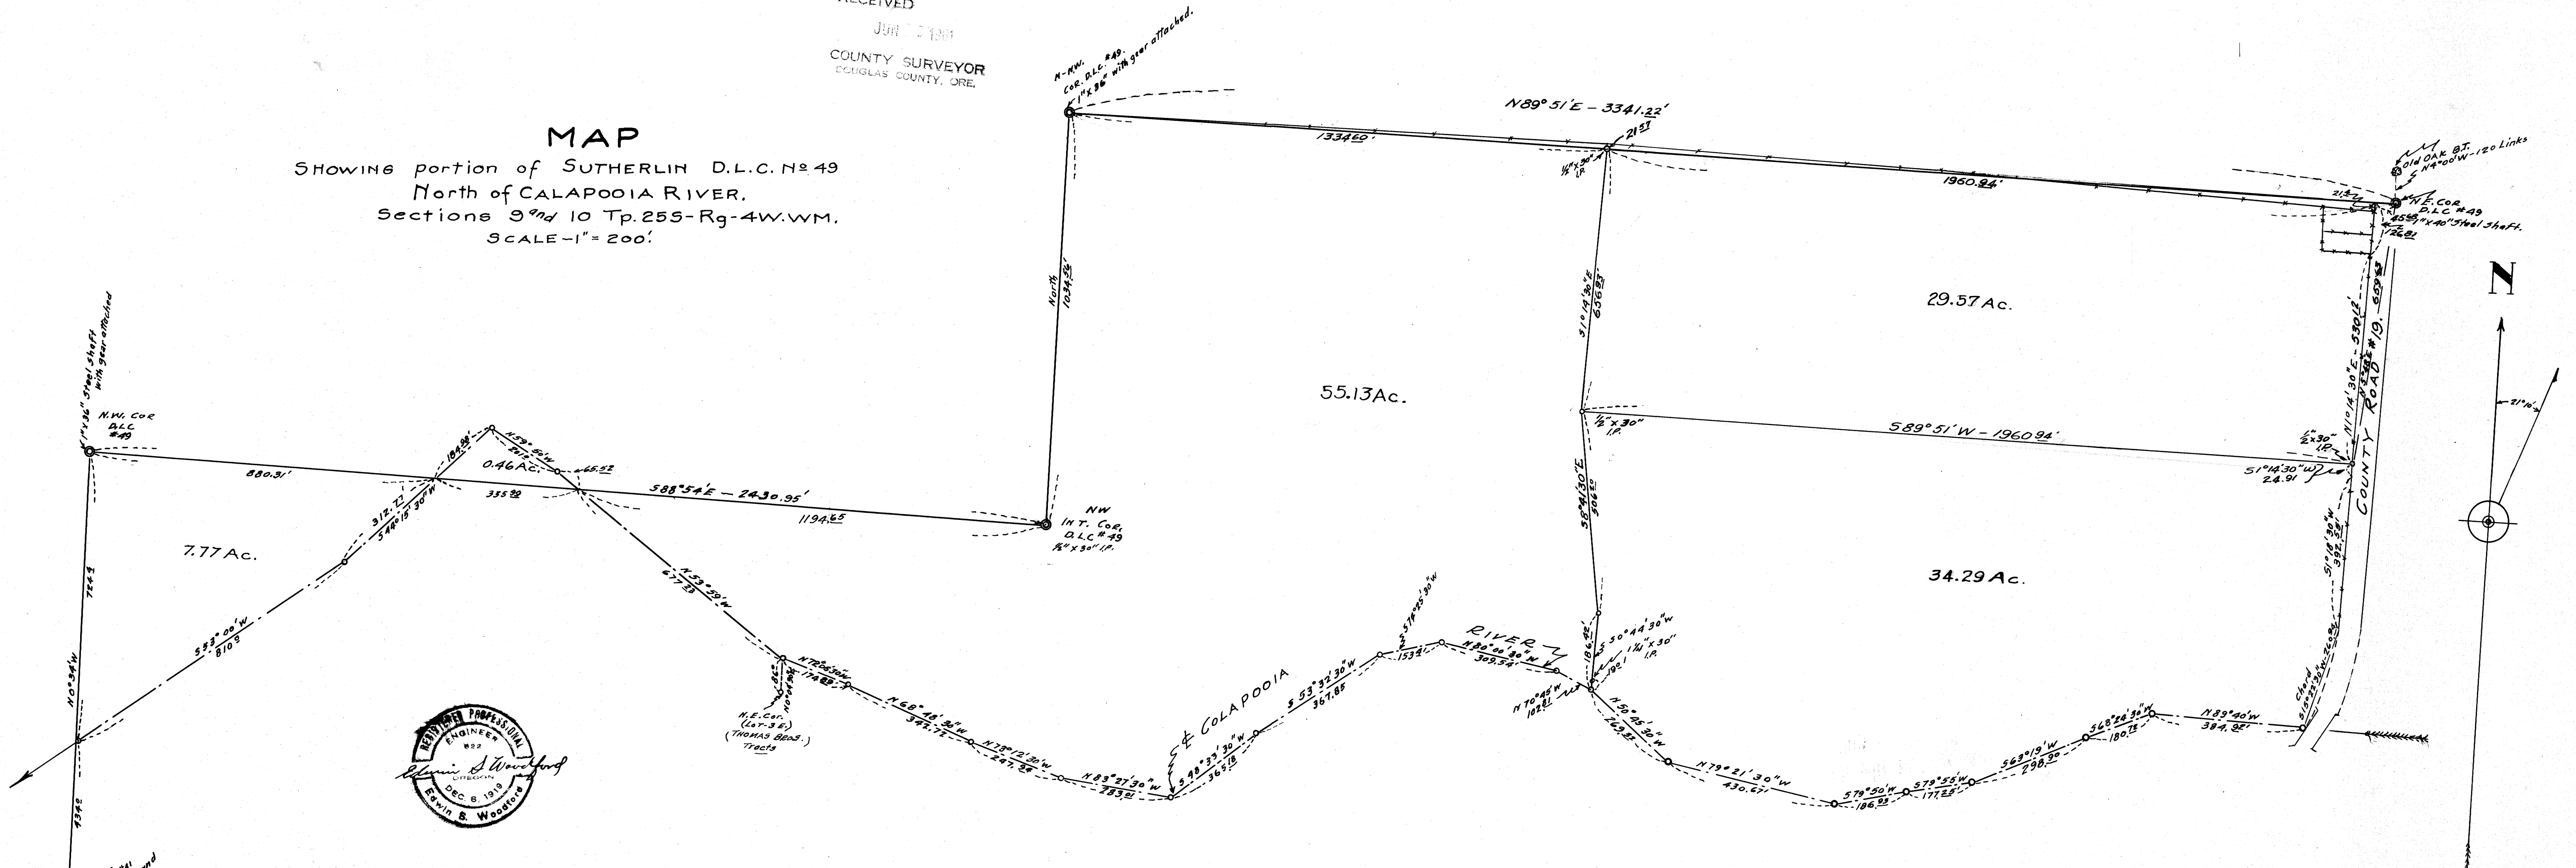

REGISTERED PROFESSIONAL  
ENGINEER  
Erwin S. Woodford  
DEC. 8, 1918  
Erwin S. Woodford

COUNTY ENGINEER FILE DAY  
DO NOT REMOVE FROM OFFICE