
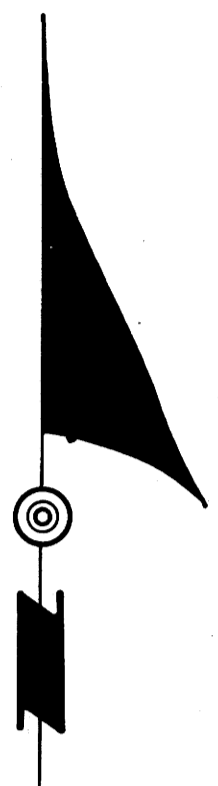


COUNTY SURVEYORS FILE DATA
DO NOT REMOVE FROM OFFICE

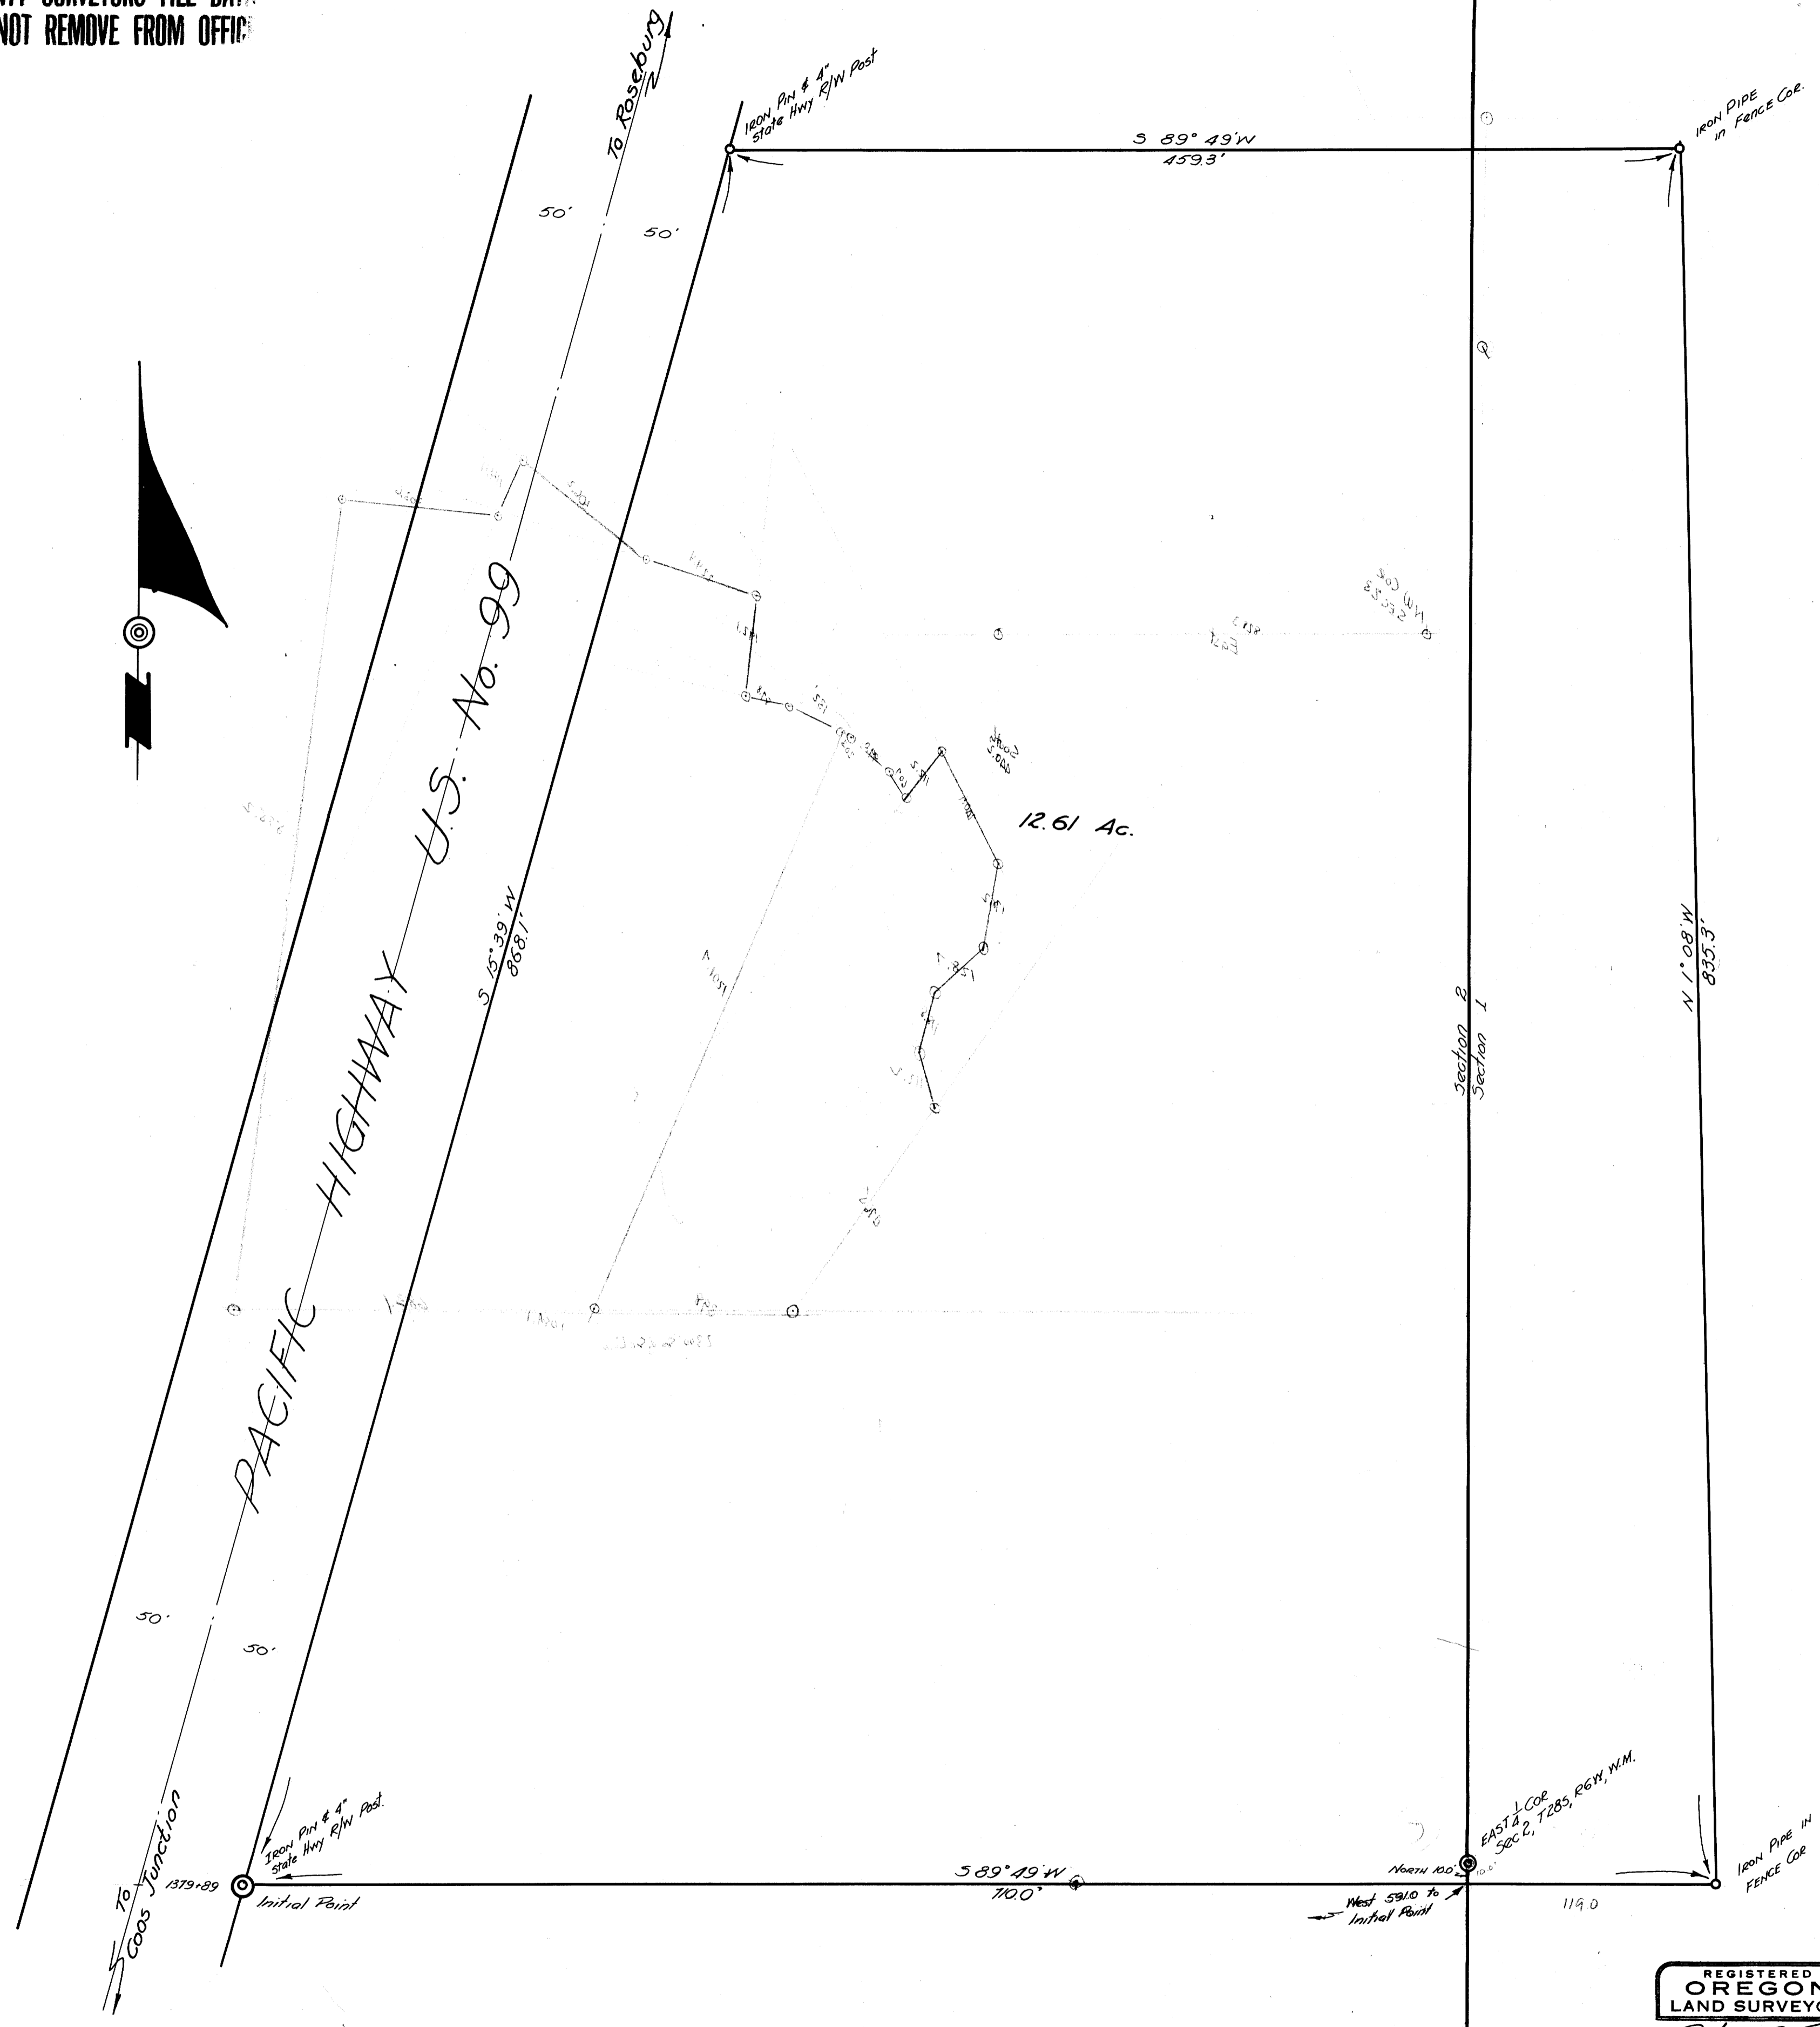

REGISTERED
OREGON
LAND SURVEYOR
Richard R. Ecker
NOVEMBER 9, 1945
RICHARD R. ECKER
158

COUNTY SURVEYORS FILE DATA
DO NOT REMOVE FROM OFFICE

JUNE 1946 Scale: 1" = 50'

CS FILE FOLDER

CONTAINS

MORE

INFORMATION