


COUNTY SURVEYORS FILE DATA
DO NOT REMOVE FROM OFFICE

FILED
RECEIVED
OCT 4 1954
COUNTY SURVEYOR
DOUGLAS COUNTY, ORE.

SURVEY FOR DEED DESCRIPTIONS
IN LOT 5, "CEDAR GROVE"
D.L.C. No. 44, T27S, R4W.W.M.
DOUGLAS COUNTY OREGON

GRANT AND EVANS, ENGINEERS
ROSEBURG, OREGON
SURVEYED, JULY, 1954, SCALE 1"=40'

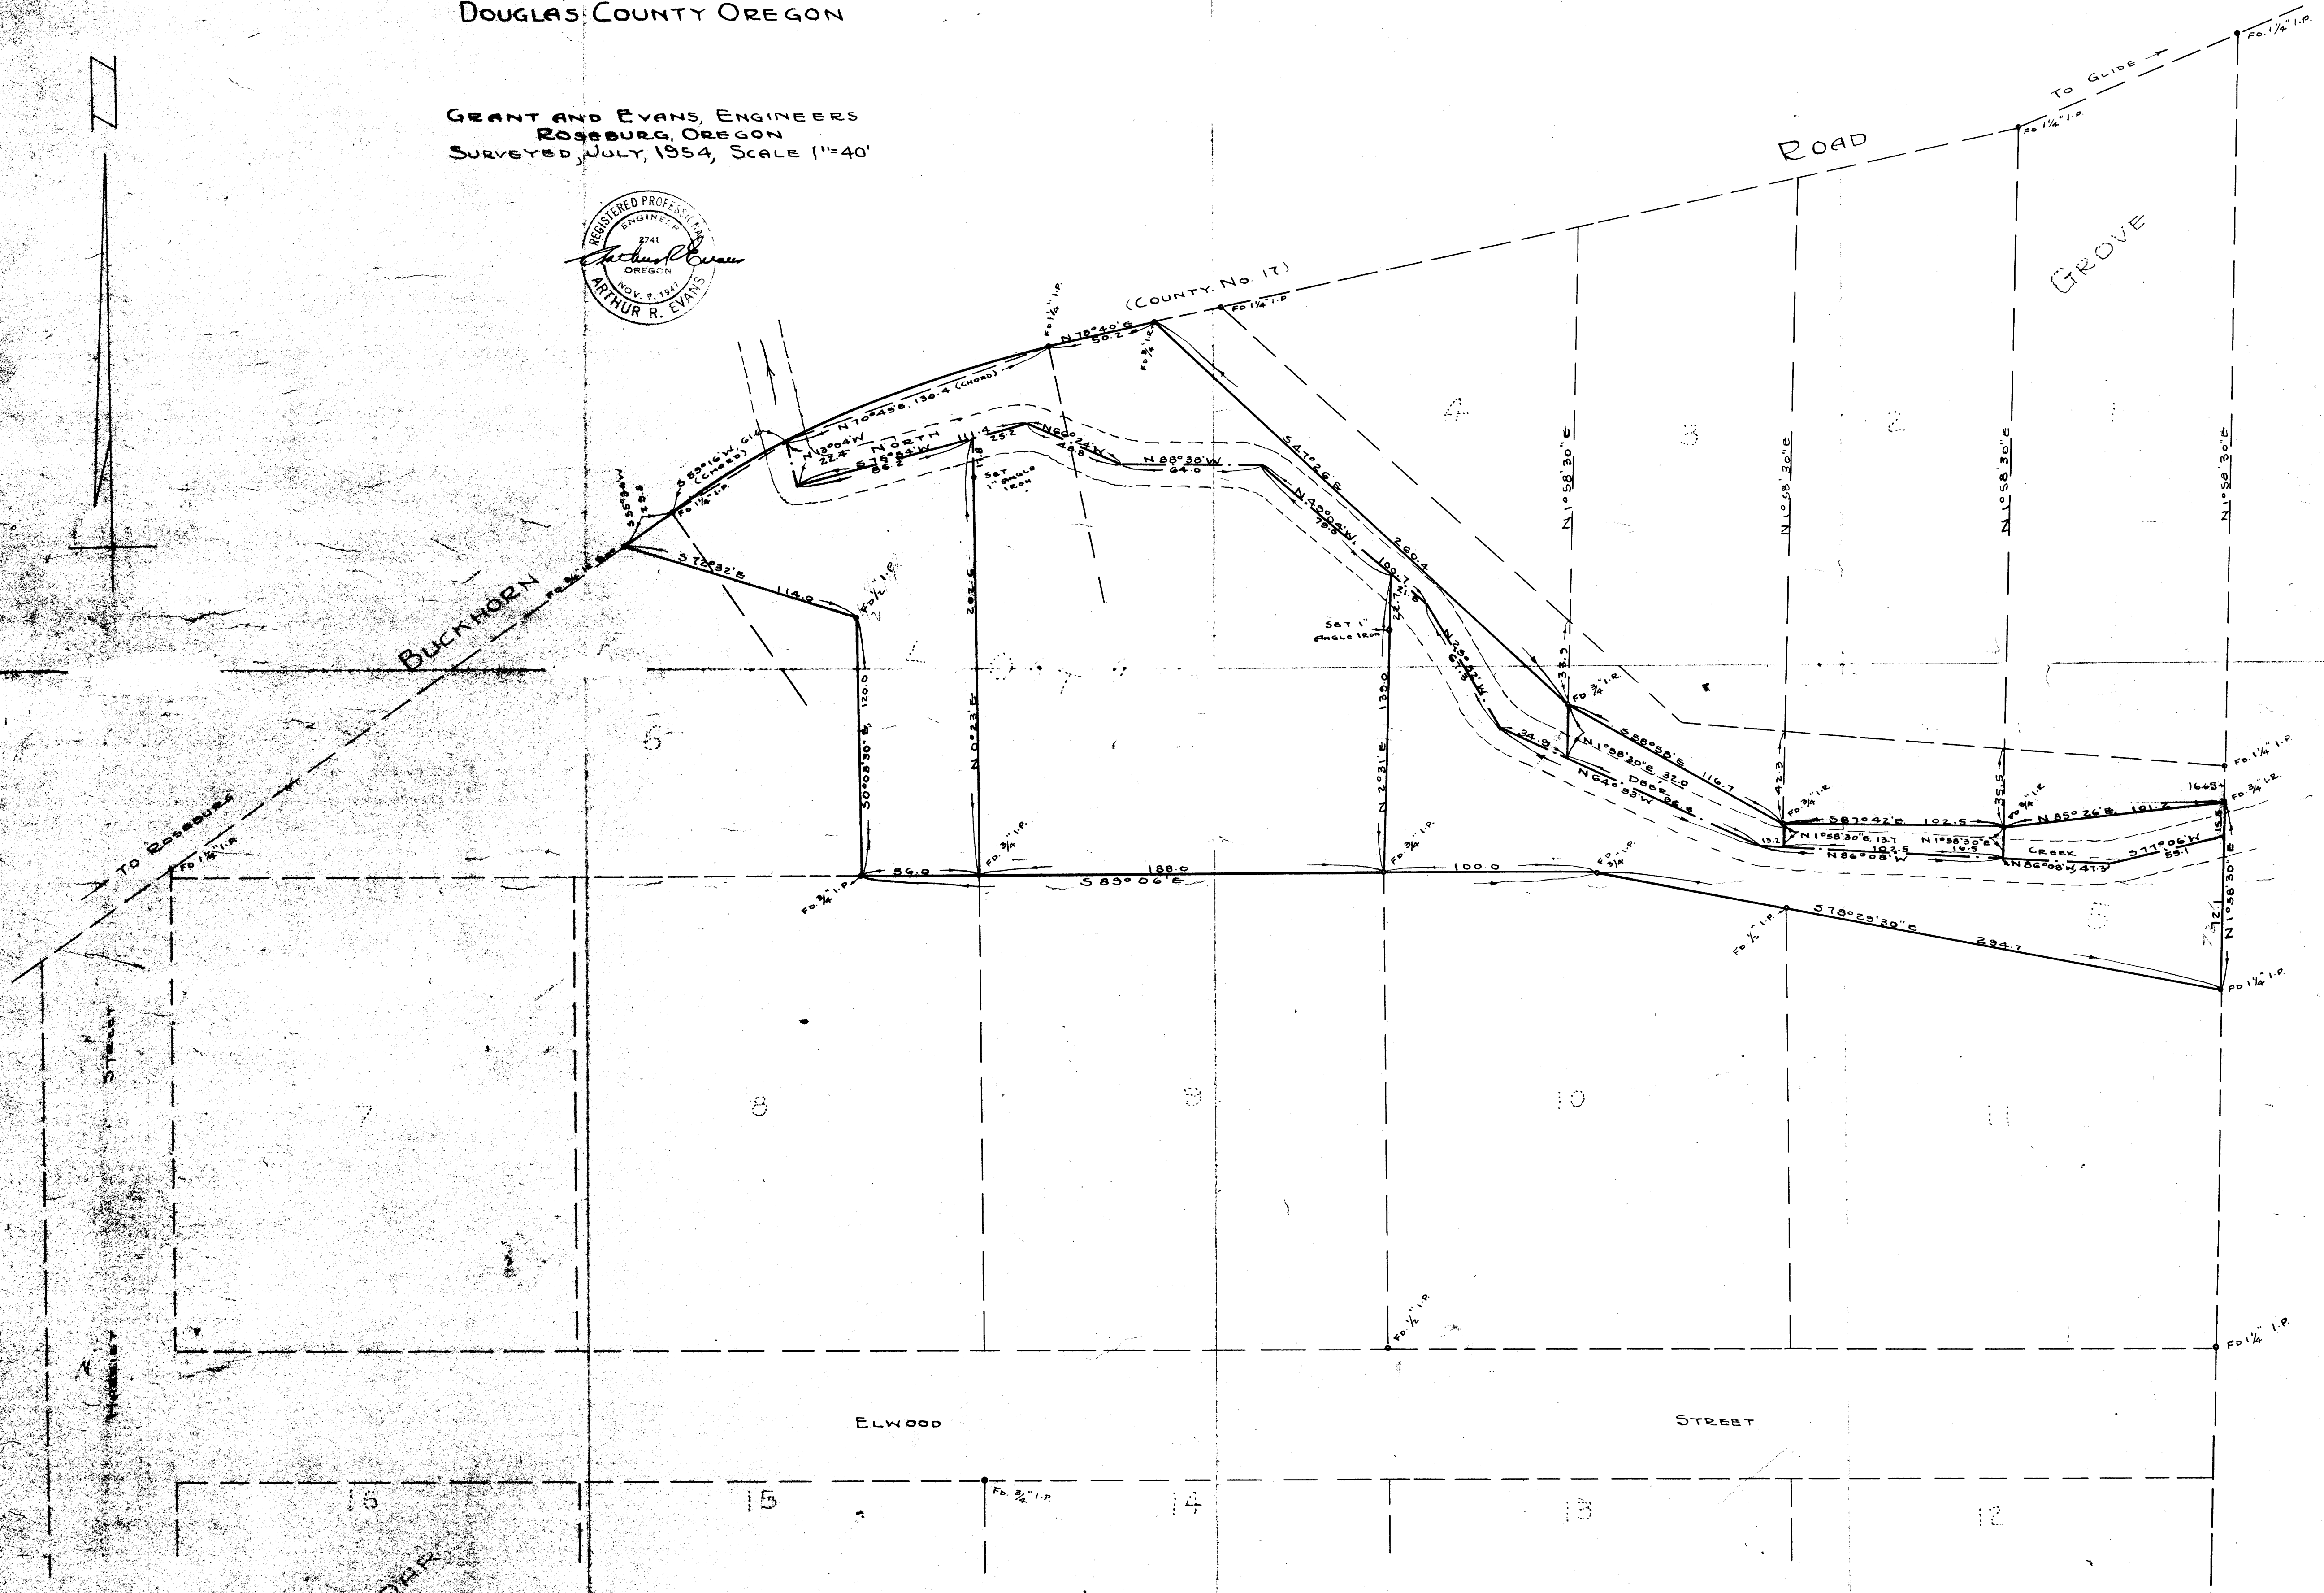

COUNTY SURVEYORS FILE DATA
DO NOT REMOVE FROM OFFICE

FOR TOM LINDBLOOM

MAP FILE M.227-29...