
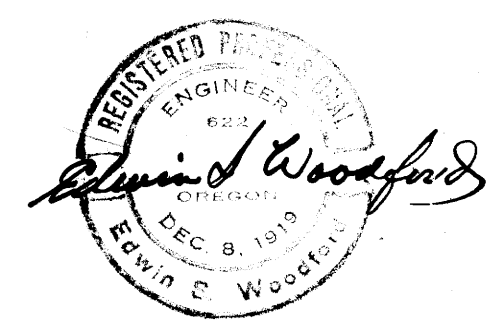


C.S. File: 40/394
15+751

COUNTY SURVEYORS FILE DATA
DO NOT REMOVE FROM OFFICE

WATER SYSTEM MAP

for Easements on
Alvin H. + Edna E. Helgeson, Clay + Ruby
Ulam, Ellis B. + Mildred H. Bischoff, William
+ Ida DeWitt, and Fir Manufacturing Co.
Dec. 1, 1951
Scale 1"=200'

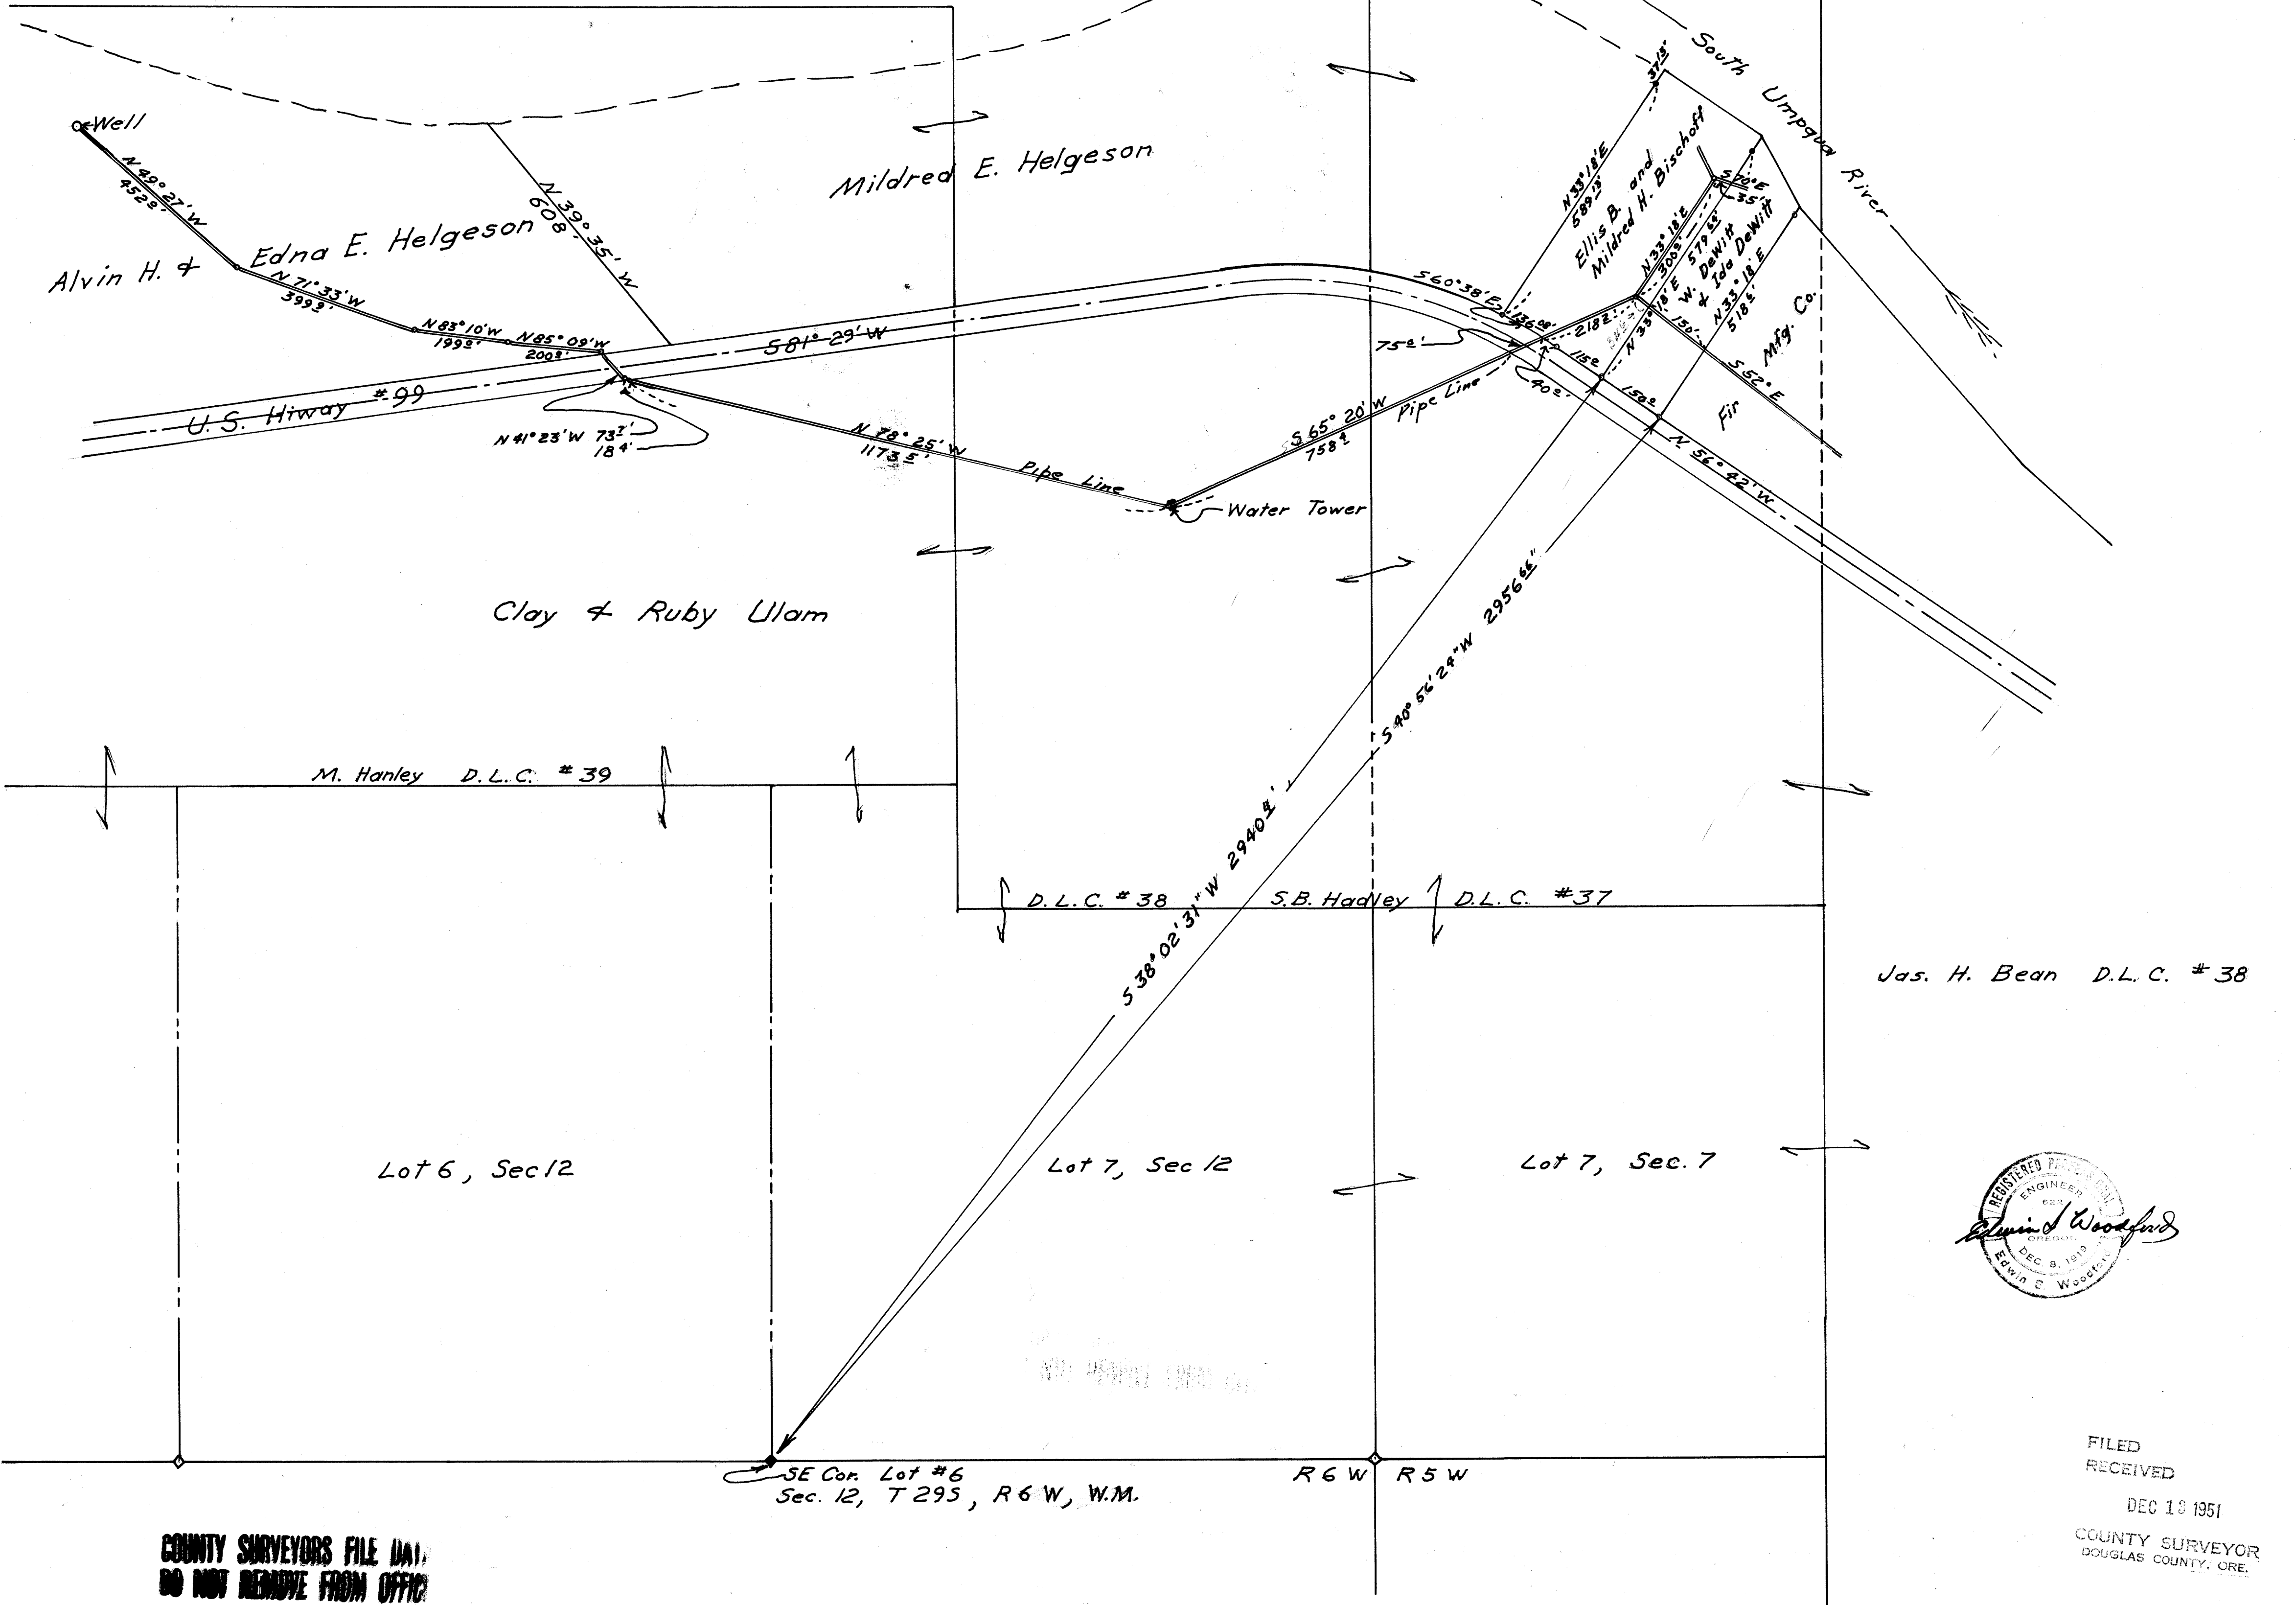

FILED
RECEIVED
DEC 13 1951
COUNTY SURVEYOR
DOUGLAS COUNTY, ORE.

COUNTY SURVEYORS FILE DATA
DO NOT REMOVE FROM OFFICE