


NOTE:
 1. DIMENSIONS AND IRON RODS SET AT ALL PROPERTY CORNERS, EXCEPT 50' IRON ROD AT TURNING AREA CORNERS.
 2. SOME WATER AT 121' DEPTH
 3. GOOD WELLS IN AREA ARE 60' - 75' DEEP
 4. SOLID SANDSTONE ROCK CAN BE ENTERED AT 2' TO 10' DEPTH.
 5. ALL BEARINGS TAKEN FROM WEST LINE OF OLD HWY. 101 S. - 110' WIDE PER GREGG COORDINATE SYSTEM.



FILED
RECEIVED
JUL 22 1965
COUNTY SURVEYOR
DOUGLAS COUNTY, ORE.

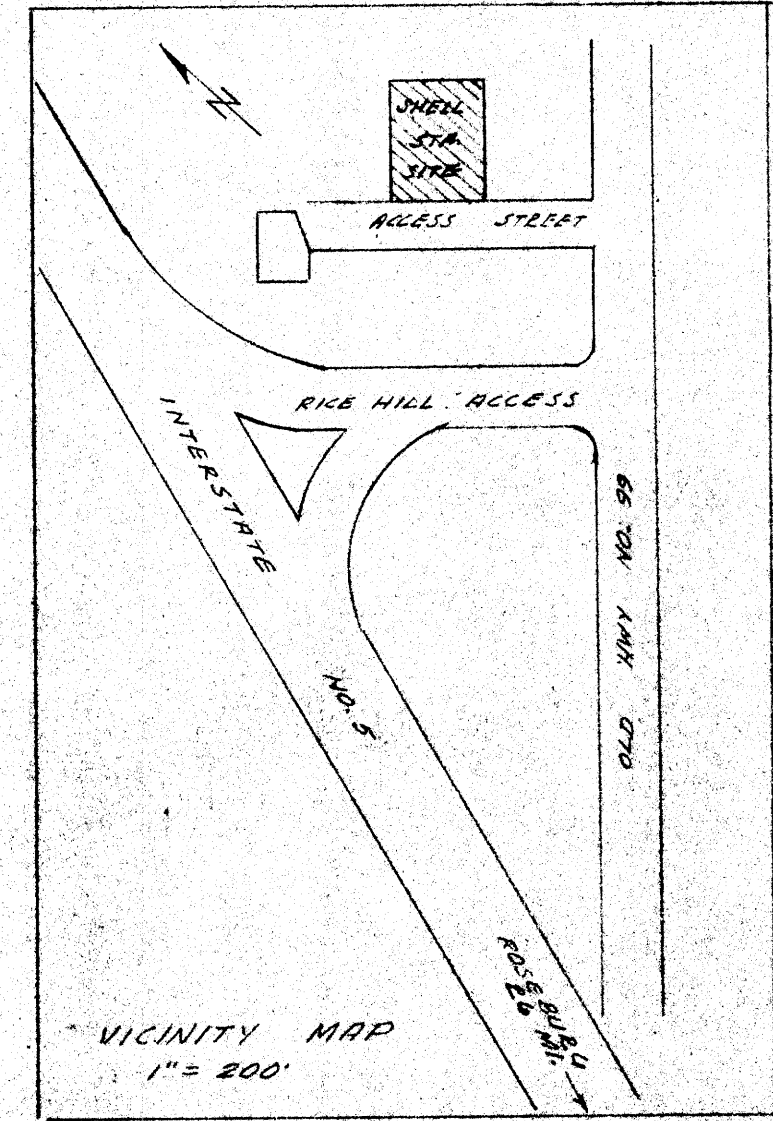

SHELL OIL COMPANY
STATION SITE AT RICE HILL
INTERCHANGE
IN SECTION 28, T 23 S, R 5 W. W.M.
SURVEYED FOR - D.M. WEBB JULY 1965
ENGINEER - W.S. BARNES SCALE 1/8" = 1'