


NOTE: ALL BEARINGS SHOWN ARE MAGNETIC.

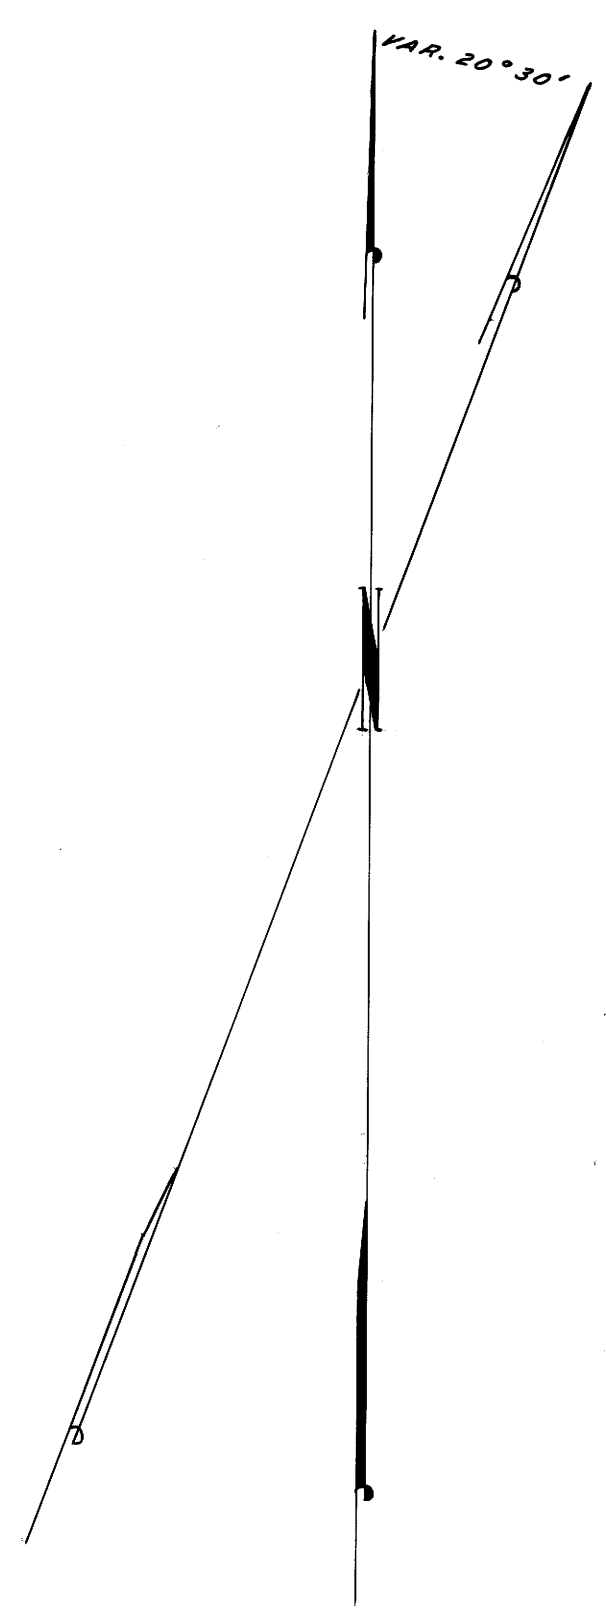

SET BRASS CAP, MKD. 1/4 S 27 / S 26
 T. 29 S., R. 5 W. COUNTY SURVEYORS,
 OFFICE, 1962, SET FROM TIE TO
 S.W. COR. CL. 47 PER GOV. NOTES.
 NEW BT.: 1 1/2\" B. OAK, BEARS S 53° E
 153.6' SCRIBED 1/4 S. 26 C.S. BT.

FD. BRASS CAP,
 S.W. COR. D.L.C. NO. 47
 N 80° 38' W 113.18'

COUNTY SURVEYORS FILE DATA
DO NOT REMOVE FROM OFFICE

COUNTY SURVEYOR'S OFFICE
DOUGLAS COUNTY, OREGON

SURVEY TO SET 1/4 CORNER,
SECTION 26 & 27, T. 29 S., R. 5 W. W.M

REGISTERED
 OREGON
 LAND SURVEYOR

James W. Byron

NOV. 6, 1953
 JAMES W. BYRON
 303

FRED M. DARBY COUNTY SURVEYOR
 SURVEYED MAR. 12, 1962 BY
 JAMES W. BYRON - DEPUTY SCALE 1" = 400'
 SURVEYED FOR DOUGLAS CO.