
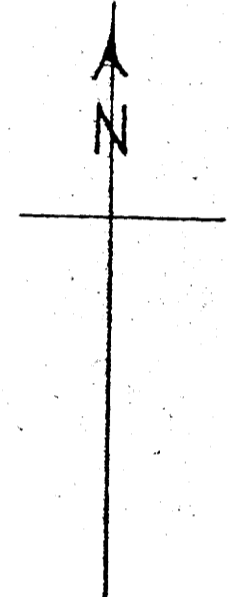


M 23-53

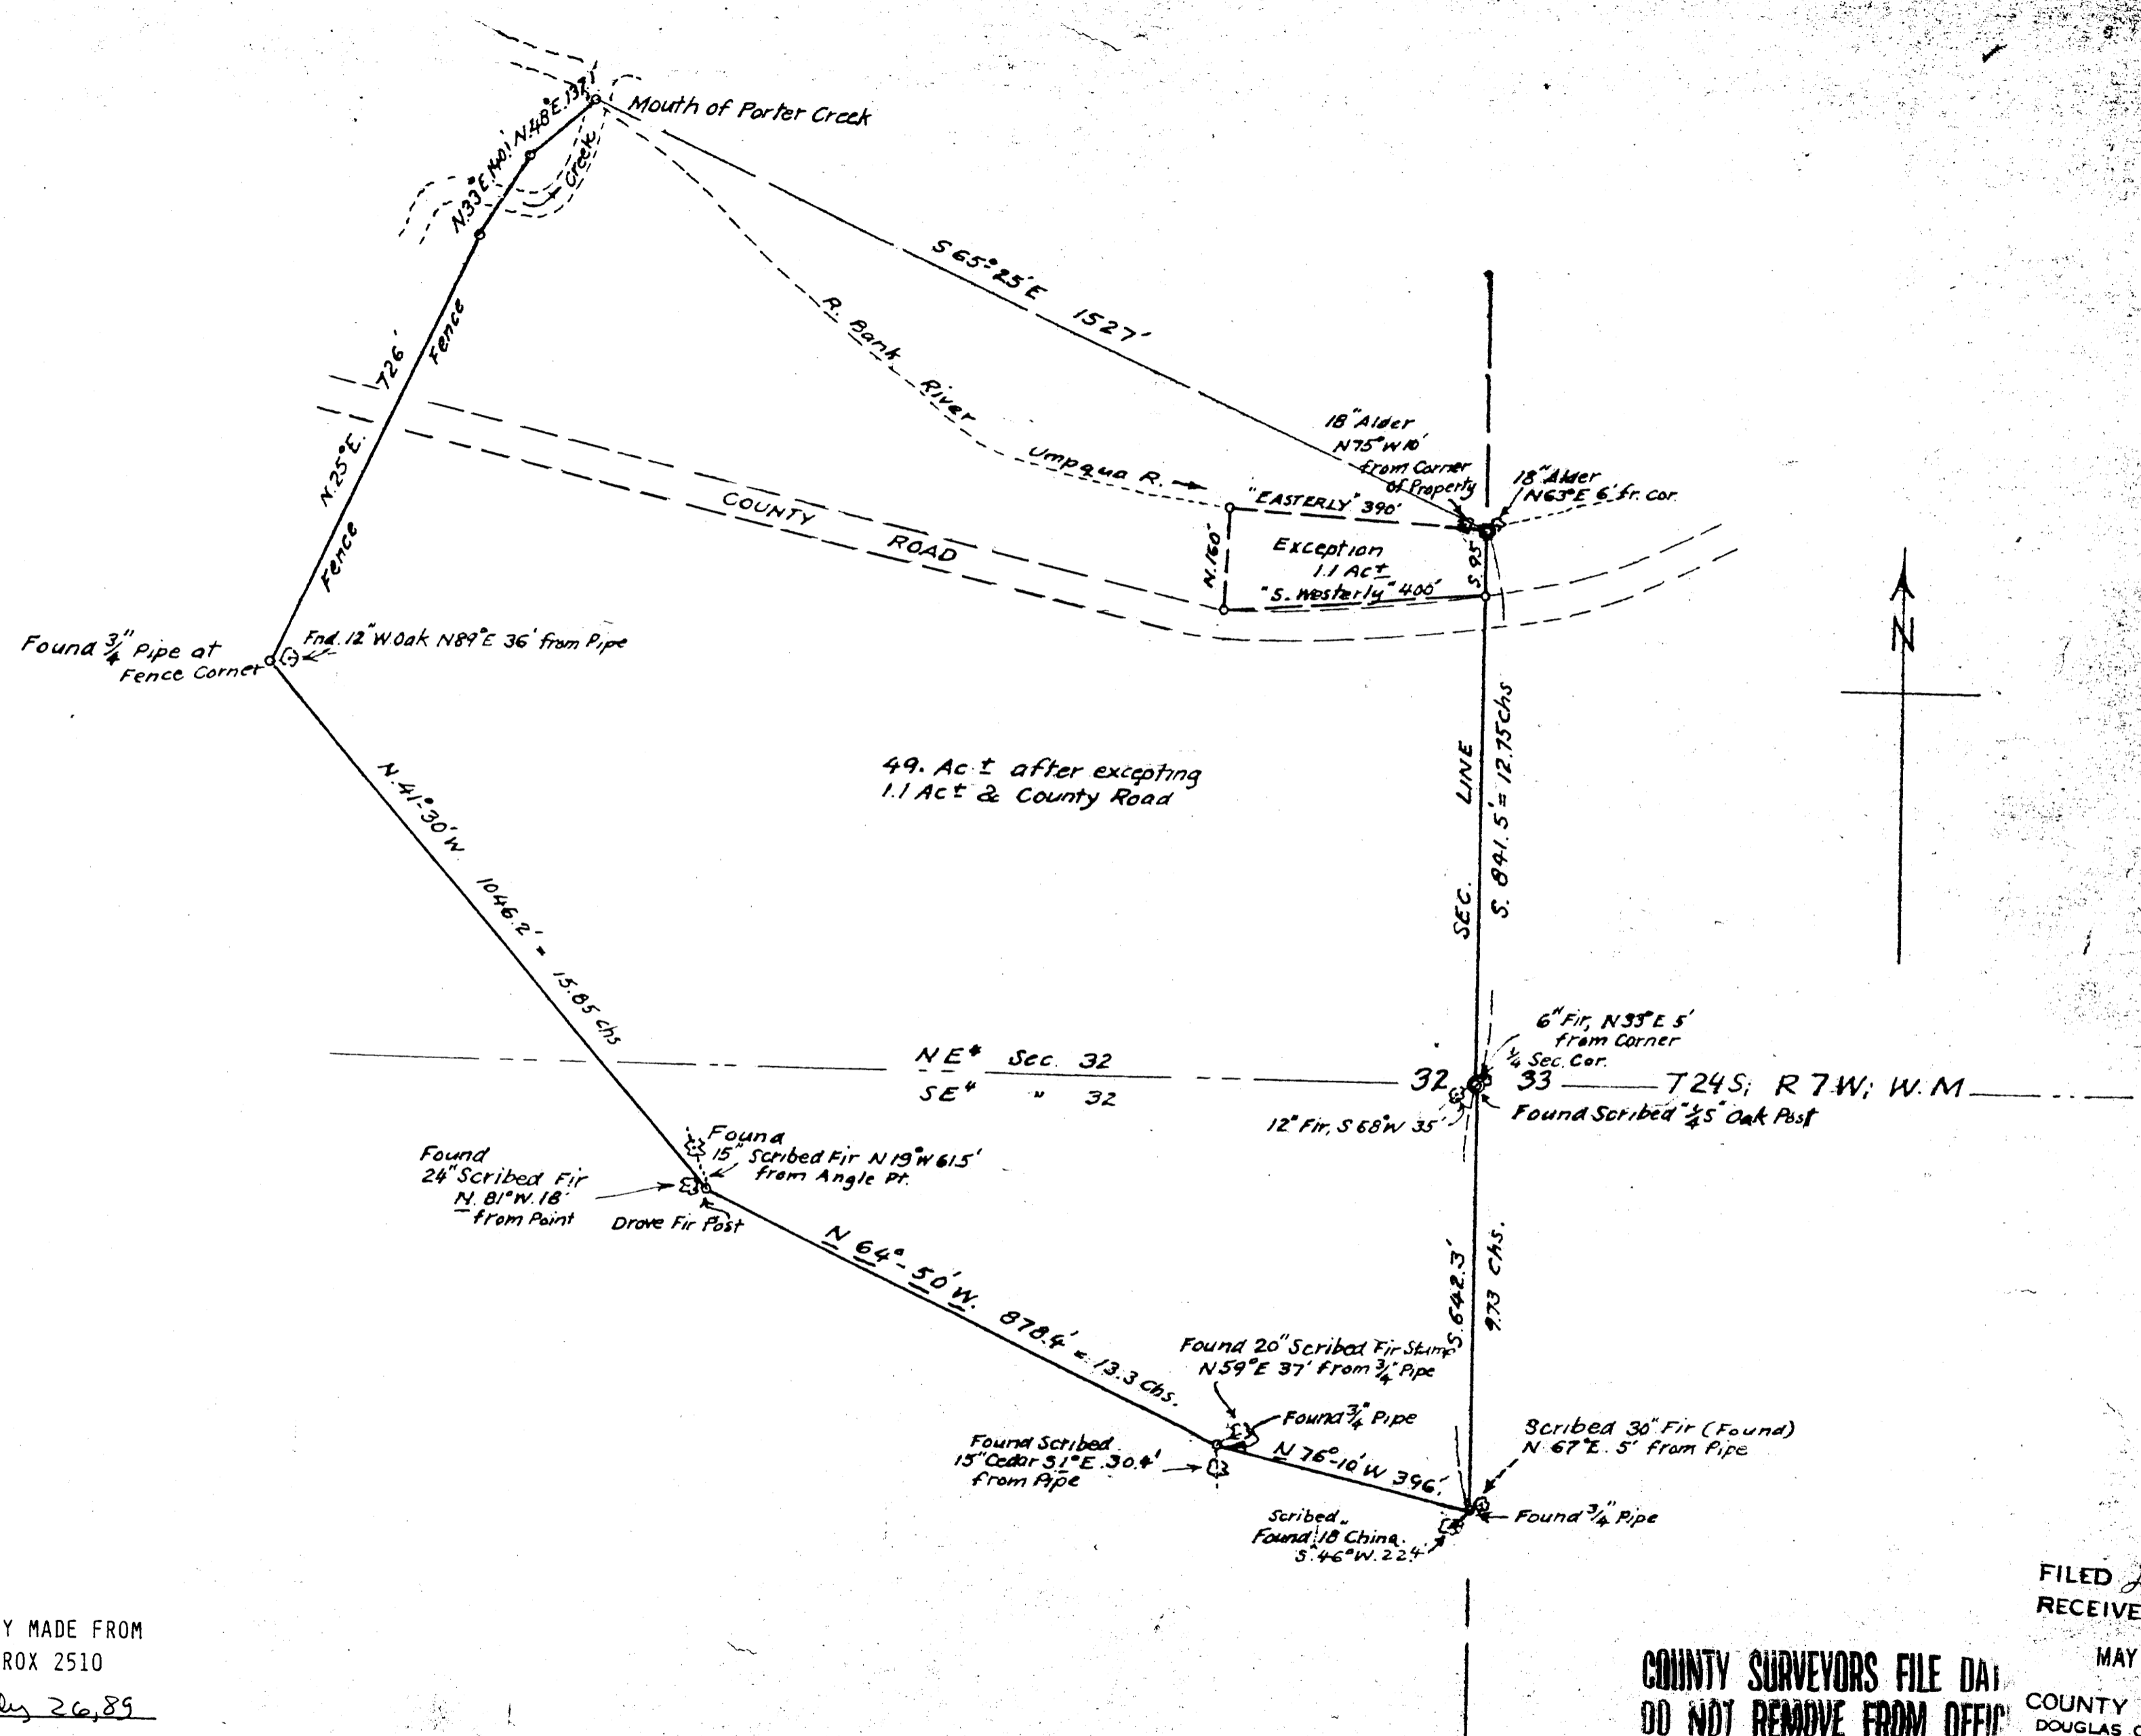

M 23-53

THIS COPY MADE FROM
A XEROX 2510
DATE July 26, 89

FILED *LL*
RECEIVED
MAY 7 1962
COUNTY SURVEYOR
DOUGLAS COUNTY, ORE.

A.B. LEONARD SURVEY
IN SEC. 32, T24S; R 7W; W.M.
FROM DESCRIPTION IN DEED
VOL. 233, Pg 164 & 165
MAY 1961 *Arthur Leonard* 20011