


COUNTY SURVEYORS FILE DATA  
DO NOT REMOVE FROM OFFICE


# SURVEY FOR MT. BALDY LUMBER CO. OF THE W 1/2 NE 1/4, SEC. 24, T23S, R7W, W.M.

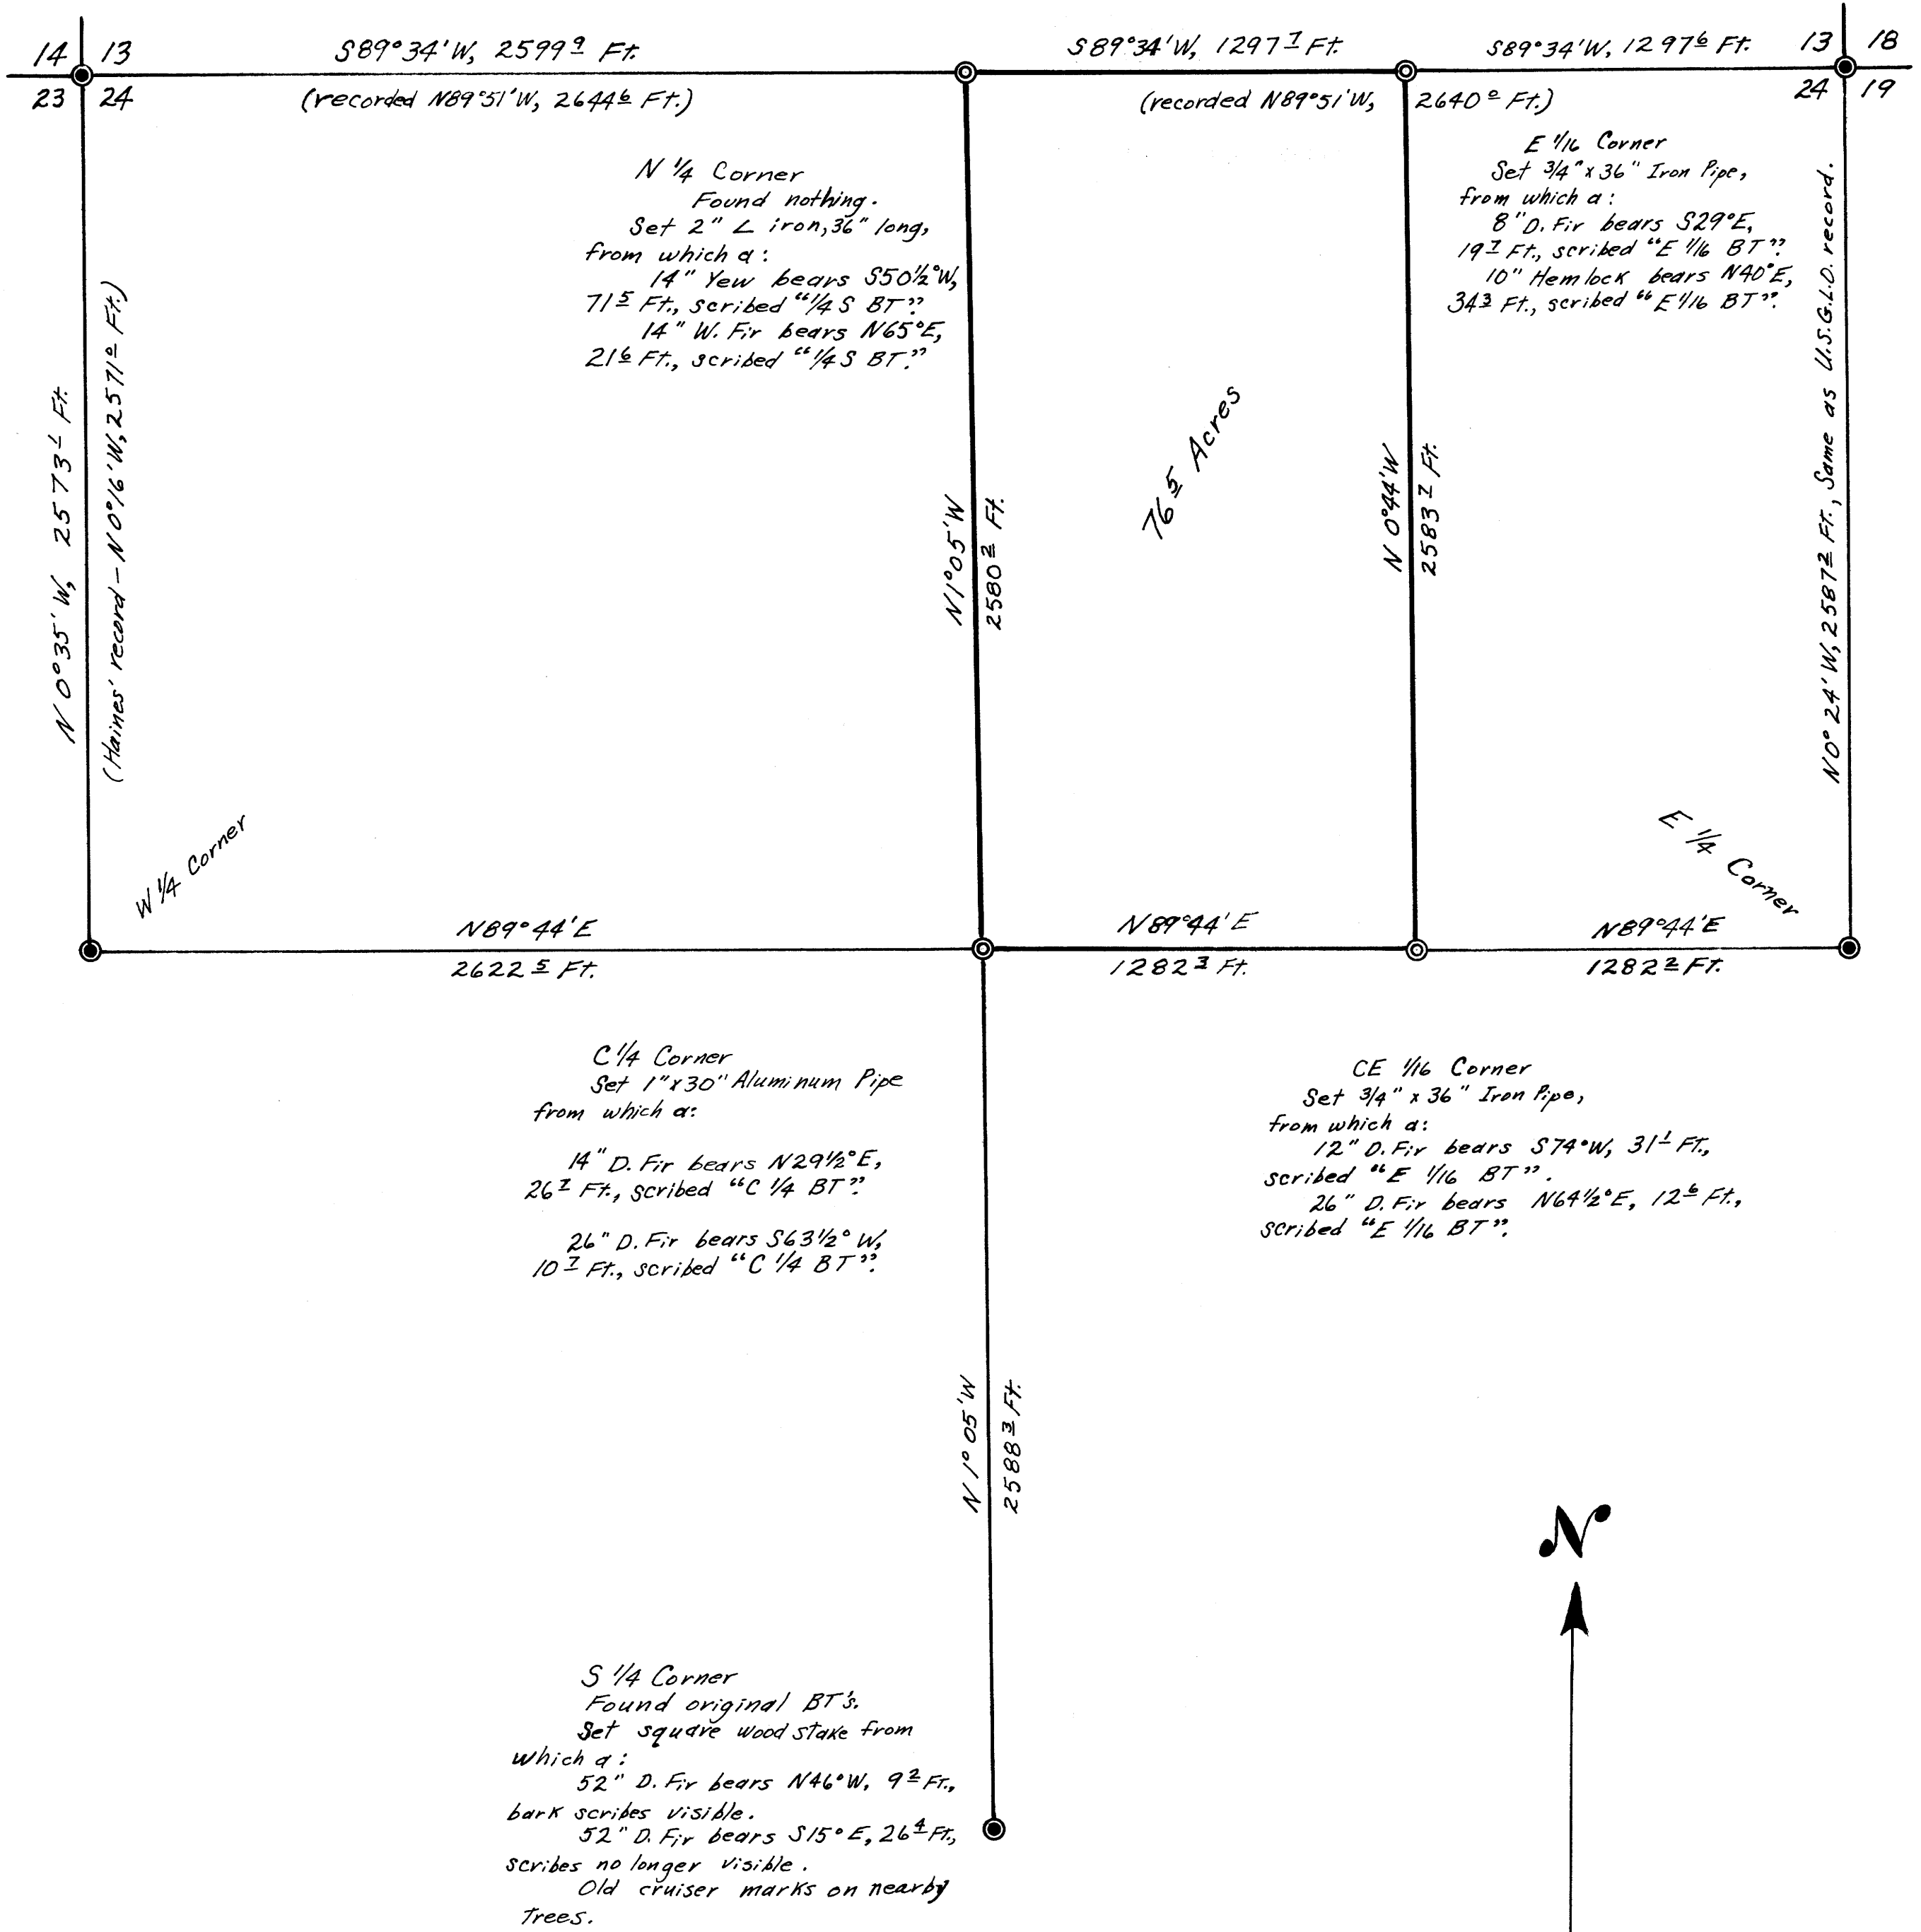

### LEGEND

- Corner Found
- Corner Set

### SCALE

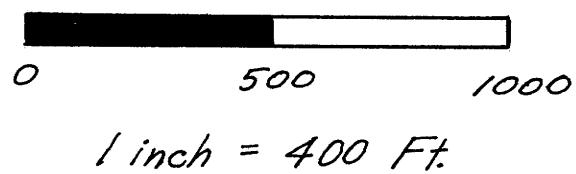

REGISTERED  
 OREGON  
 LAND SURVEYOR  
 Bruce A. Shaner  
 OCT. 4, 1937  
 Bruce A. Shaner  
 490

Surveyed April & May, 1962

Bearings based on U.S.G.L.O. Survey from E 1/4 to NEC.

FILED *LL*  
RECEIVED

JUN 1 1962

COUNTY SURVEYOR  
DOUGLAS COUNTY, ORE.