
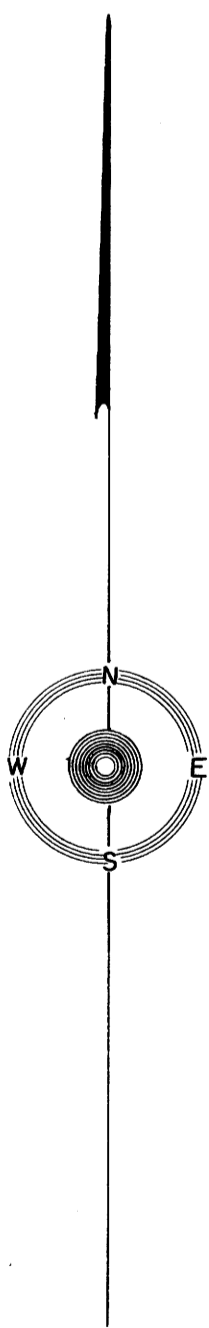


COUNTY SURVEYORS FILE DATA  
DO NOT REMOVE FROM OFFICE

# SURVEY IN SECTION 32, T 24 S, R 7 W, W.M.

SURVEYED FOR: A. B. LEONARD & JOE PRUITT  
SURVEYED BY: G. R. LECKLIDER-ENGINEER

JUNE, 1962  
SCALE: 1" = 200'

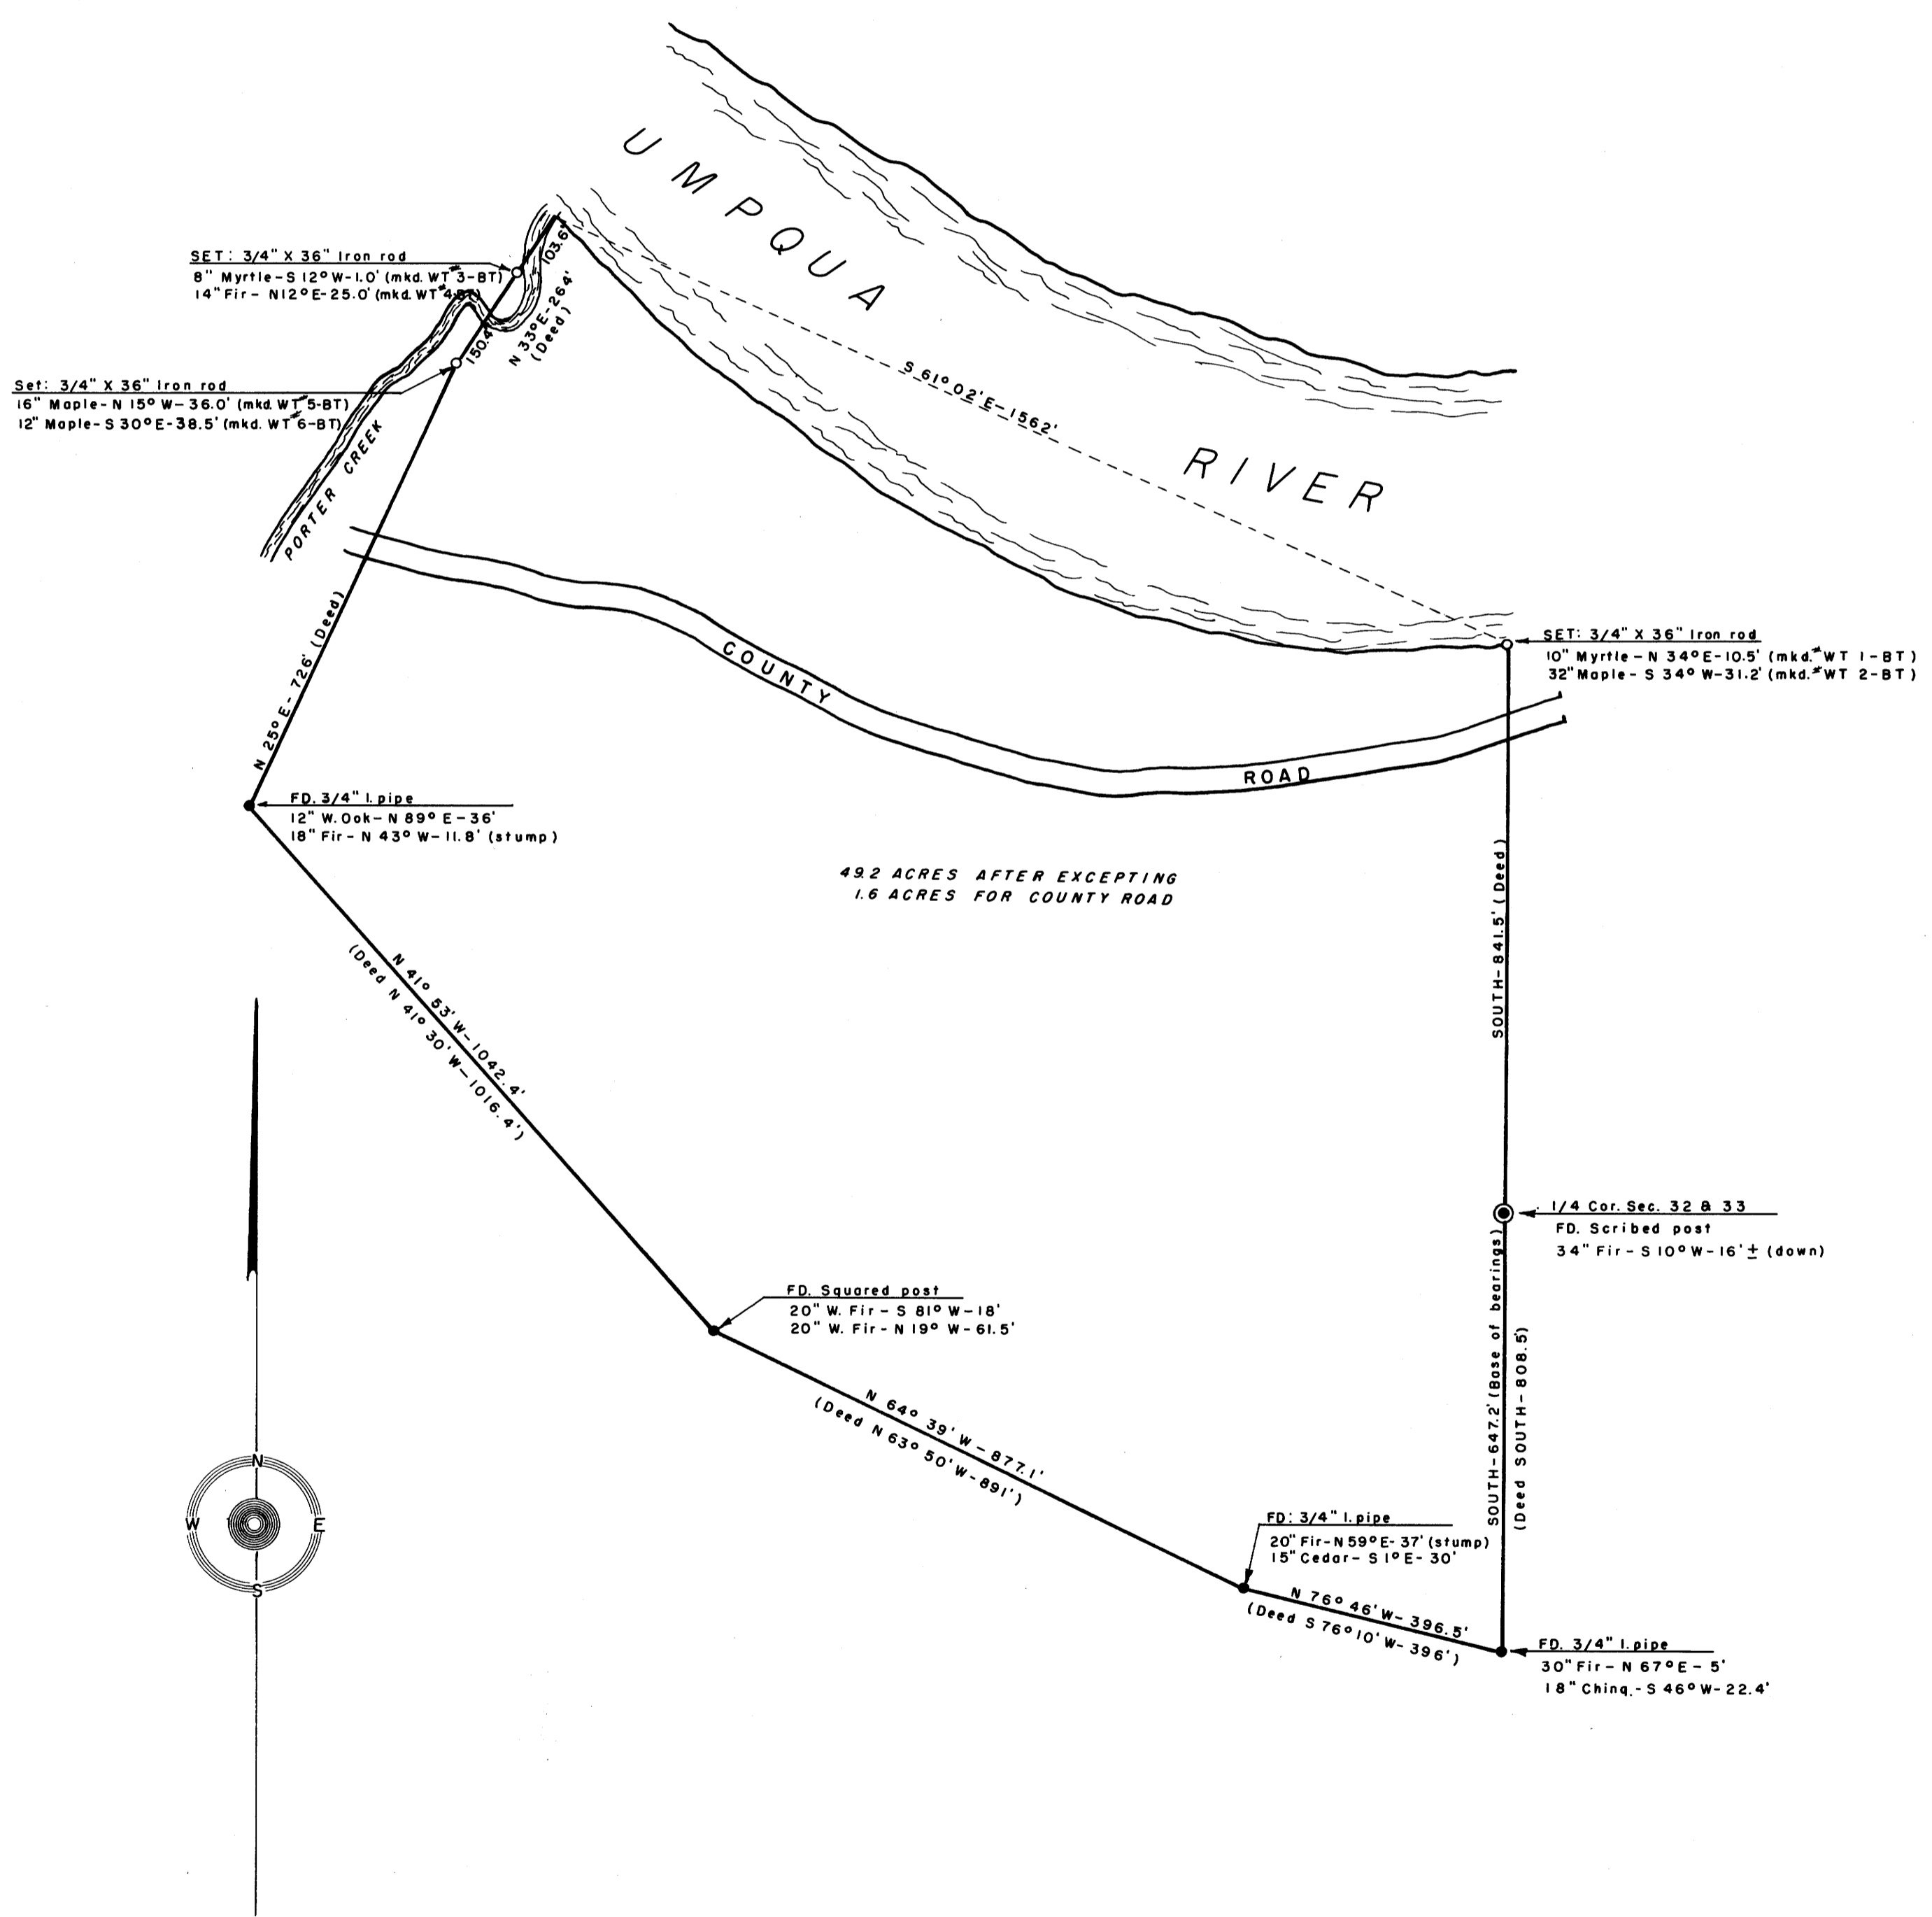

FILED *L.L.*  
RECEIVED  
JUN 6 1962  
COUNTY SURVEYOR  
DOUGLAS COUNTY, ORE.

