


SURVEY FOR SAM ROBINSON
IN D.L.C. 53 IN SEC. 19, T25S, R5W, W.M.

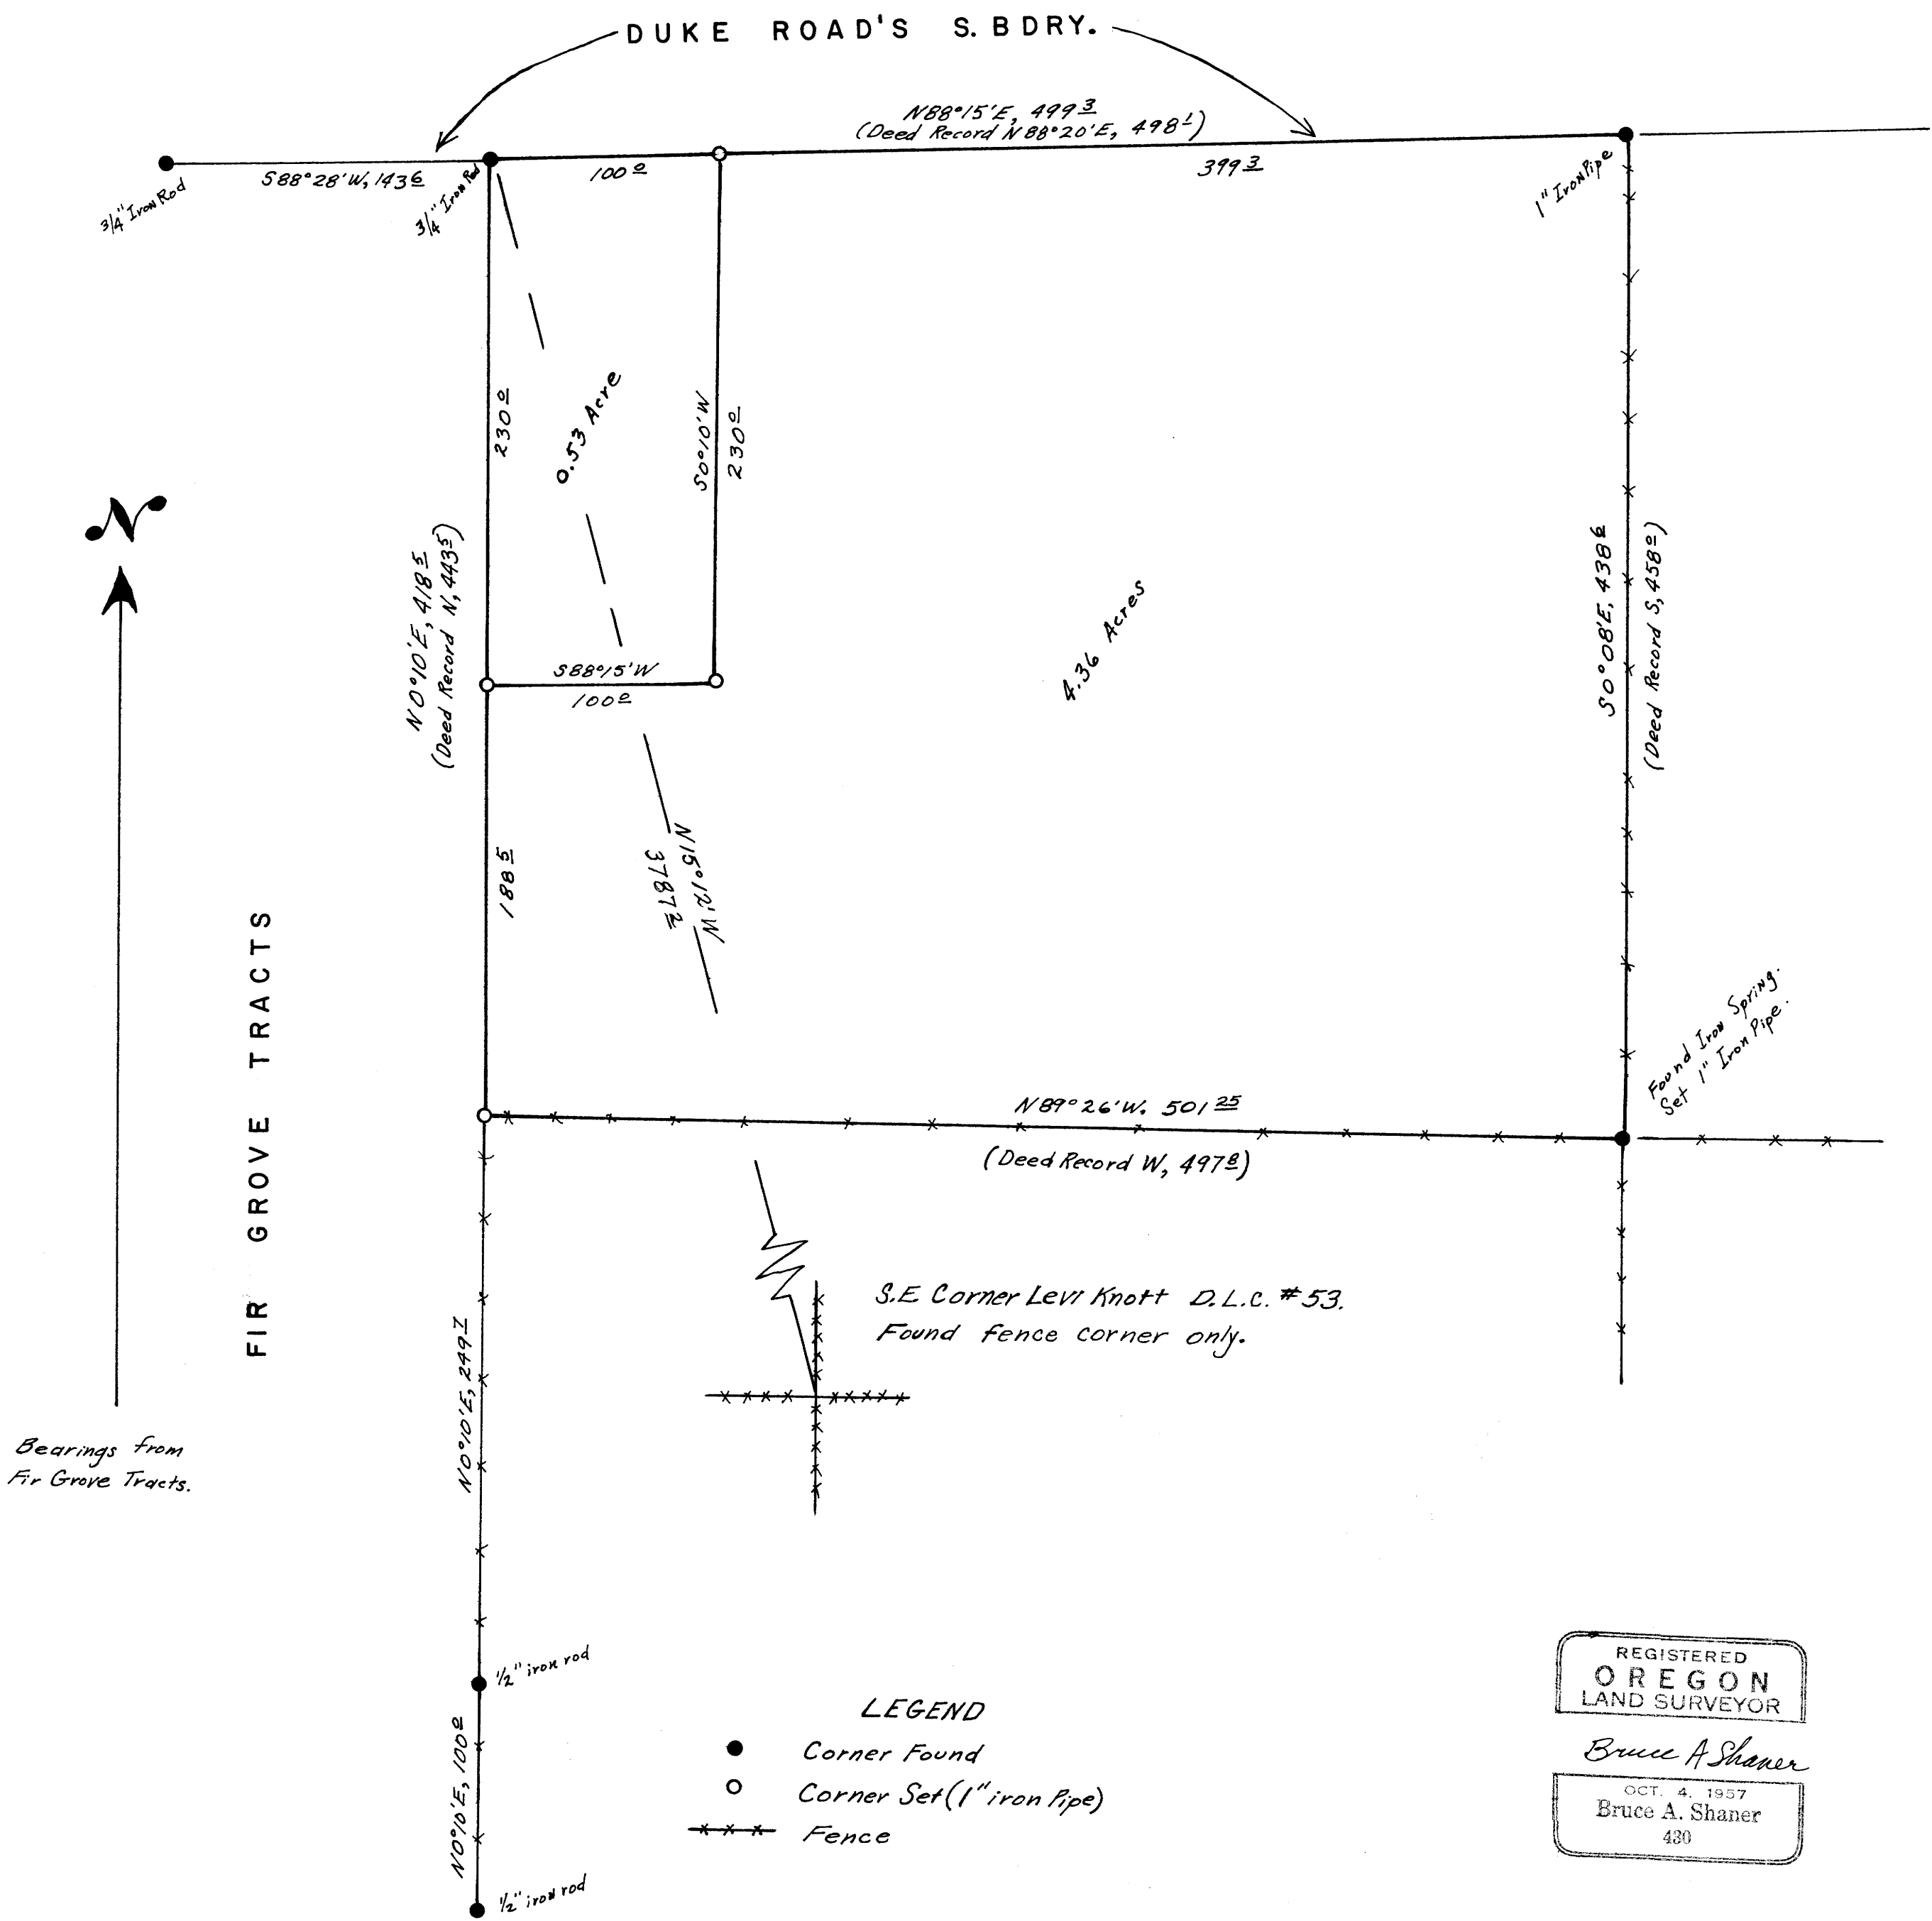

LEGEND

- Corner Found
- Corner Set (1" iron pipe)
- *** Fence

0 60 120 180
Scale: 1 inch = 60 Feet

REGISTERED
OREGON
LAND SURVEYOR
Bruce A. Shaner
OCT. 4, 1957
Bruce A. Shaner
430

FILED
RECEIVED
SEP 4 1962
COUNTY SURVEYOR
DOUGLAS COUNTY, ORE.