


X on Br. Curb N. 13° W. 74.8  
 X on Br. Pier N. 7° E. 100.5  
 (Found) Brass Cap  
 40.0 I.I.P.  
 Witness Cor. ¼ Sec. 4 on Twn. Line  
 26" Maple S. 35° 04' W. 33.1  
 12" Maple S. 32° 45' E. 31.6  
 Witness Cor. on ¼ Sec. 4, I.I.P.  
 36" Maple S. 24° 06' E. 76.5  
 36" Cedar S. 58° 05' W. 84.8

Found Remains of Old B.Ts.  
 Scrib 18" Fir S. 41° 04' E. 29.8  
 12" Alder S. 32° 20' W. 35.5  
 E.I.P. ¼ Cor. bet. Sec. 4 & 5

7" Chingopin N. 2° 05' E. 33.7  
 5" Madrona N. 61° 43' E. 32.0  
 1" I.P. ¼ Cor. bet. Sec. 4 & 5

T. 32 S.  
 T. 33 S.

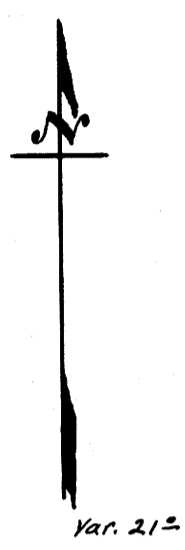

**COUNTY SURVEYORS FILE DATA  
 DO NOT REMOVE FROM OFFICE**

COUNTY SURVEYOR'S OFFICE  
 DOUGLAS COUNTY, OREGON.  
 SURVEY FOR  
 O. MILLER & L. COATE  
 SECTION 4, T. 33 S., R. 6 W. W.M.  
 GEO. J. WENDEROTH, DEPUTY, DEC. 31, 1962.  
 SCALE 1" = 200 FT.

FILED  
 RECEIVED

JAN 3 1963

COUNTY SURVEYOR  
 DOUGLAS COUNTY, OREGON

REGISTERED  
 OREGON  
 LAND SURVEYOR  
 Geo. J. Wenderoth  
 MARCH 10, 1944  
 George J. Wenderoth  
 5

¼ Cor. bet. Sec. 3 & 4  
 Point in Co. Road where fences  
 come together if extended. Not Set

C.S. File 52 / 137

SEE M 49-21  
 CORNER 2  
 M 24-44

Corners Renewed.  
T. 33 S., R. 6 W.

1/4 Cor. North Side Sec. 4 Corner washed away.

Set 1" I. Pipe 38.8 ft. West on Twn. line.

Scribed 26" Maple S. 35° 04' W. 33.1 ft.

12" Maple S. 32° 45' E. 31.6 ft.

Set 1" I. Pipe 76.8 ft. South on ~~R~~ Sec. 4.

Scribed 36" Maple S. 24° 06' E. 76.5 ft.

36" Cedar S. 58° 05' W. 84.8 ft.

Found the 12" Maple S. 21° E. 27.1 ft. for the 1/4 Cor.  
the only tree left. ✓✓+

1/4 Cor. bet. Sec. 4 + 9

Found 56" Pine N. 54° E. 21.8 ft. only stump remains.  
also found an Iron rod with pulley on top 5 ft. North  
of bearing + distance.

Set 1" I. Pipe at Corner

Scribe 7" Chinquipin N. 2° 05' E. 33.7

5" Madrona N. 64° 43' E. 32.0 ✓✓+

1/4 Cor bet. 4 + 5

Found 2" I. P. + Remains of old Bls. *Geo J. Wenderoth*

Scribe 18" Fir S. 41° 04' E. 29.8

12" Alder S. 32° 20' W. 35.5 + ✓✓

REGISTERED  
OREGON  
LAND SURVEYOR

MARCH 10, 1944  
George J. Wenderoth  
5

Dec. 31, 1962

Center Sec. 4 { 2698.1 S. of N 1/4 Cor.  
2643.3 E. of W 1/4 Cor.

1" I. P. 14" Madrona N. 9° 18' E. 42.7

13" Madrona S. 43° 50' E. 28.0 ✓✓+

C.S. File 52 / 137

Map File M 24 - 44