


COUNTY SURVEYORS FILE DATA  
DO NOT REMOVE FROM OFFICE

COUNTY SURVEYOR'S OFFICE  
DOUGLAS COUNTY, OREGON.  
Surveys in  
SECTION 24 T. 30 S., R. 4 W. W.M.  
April 1951

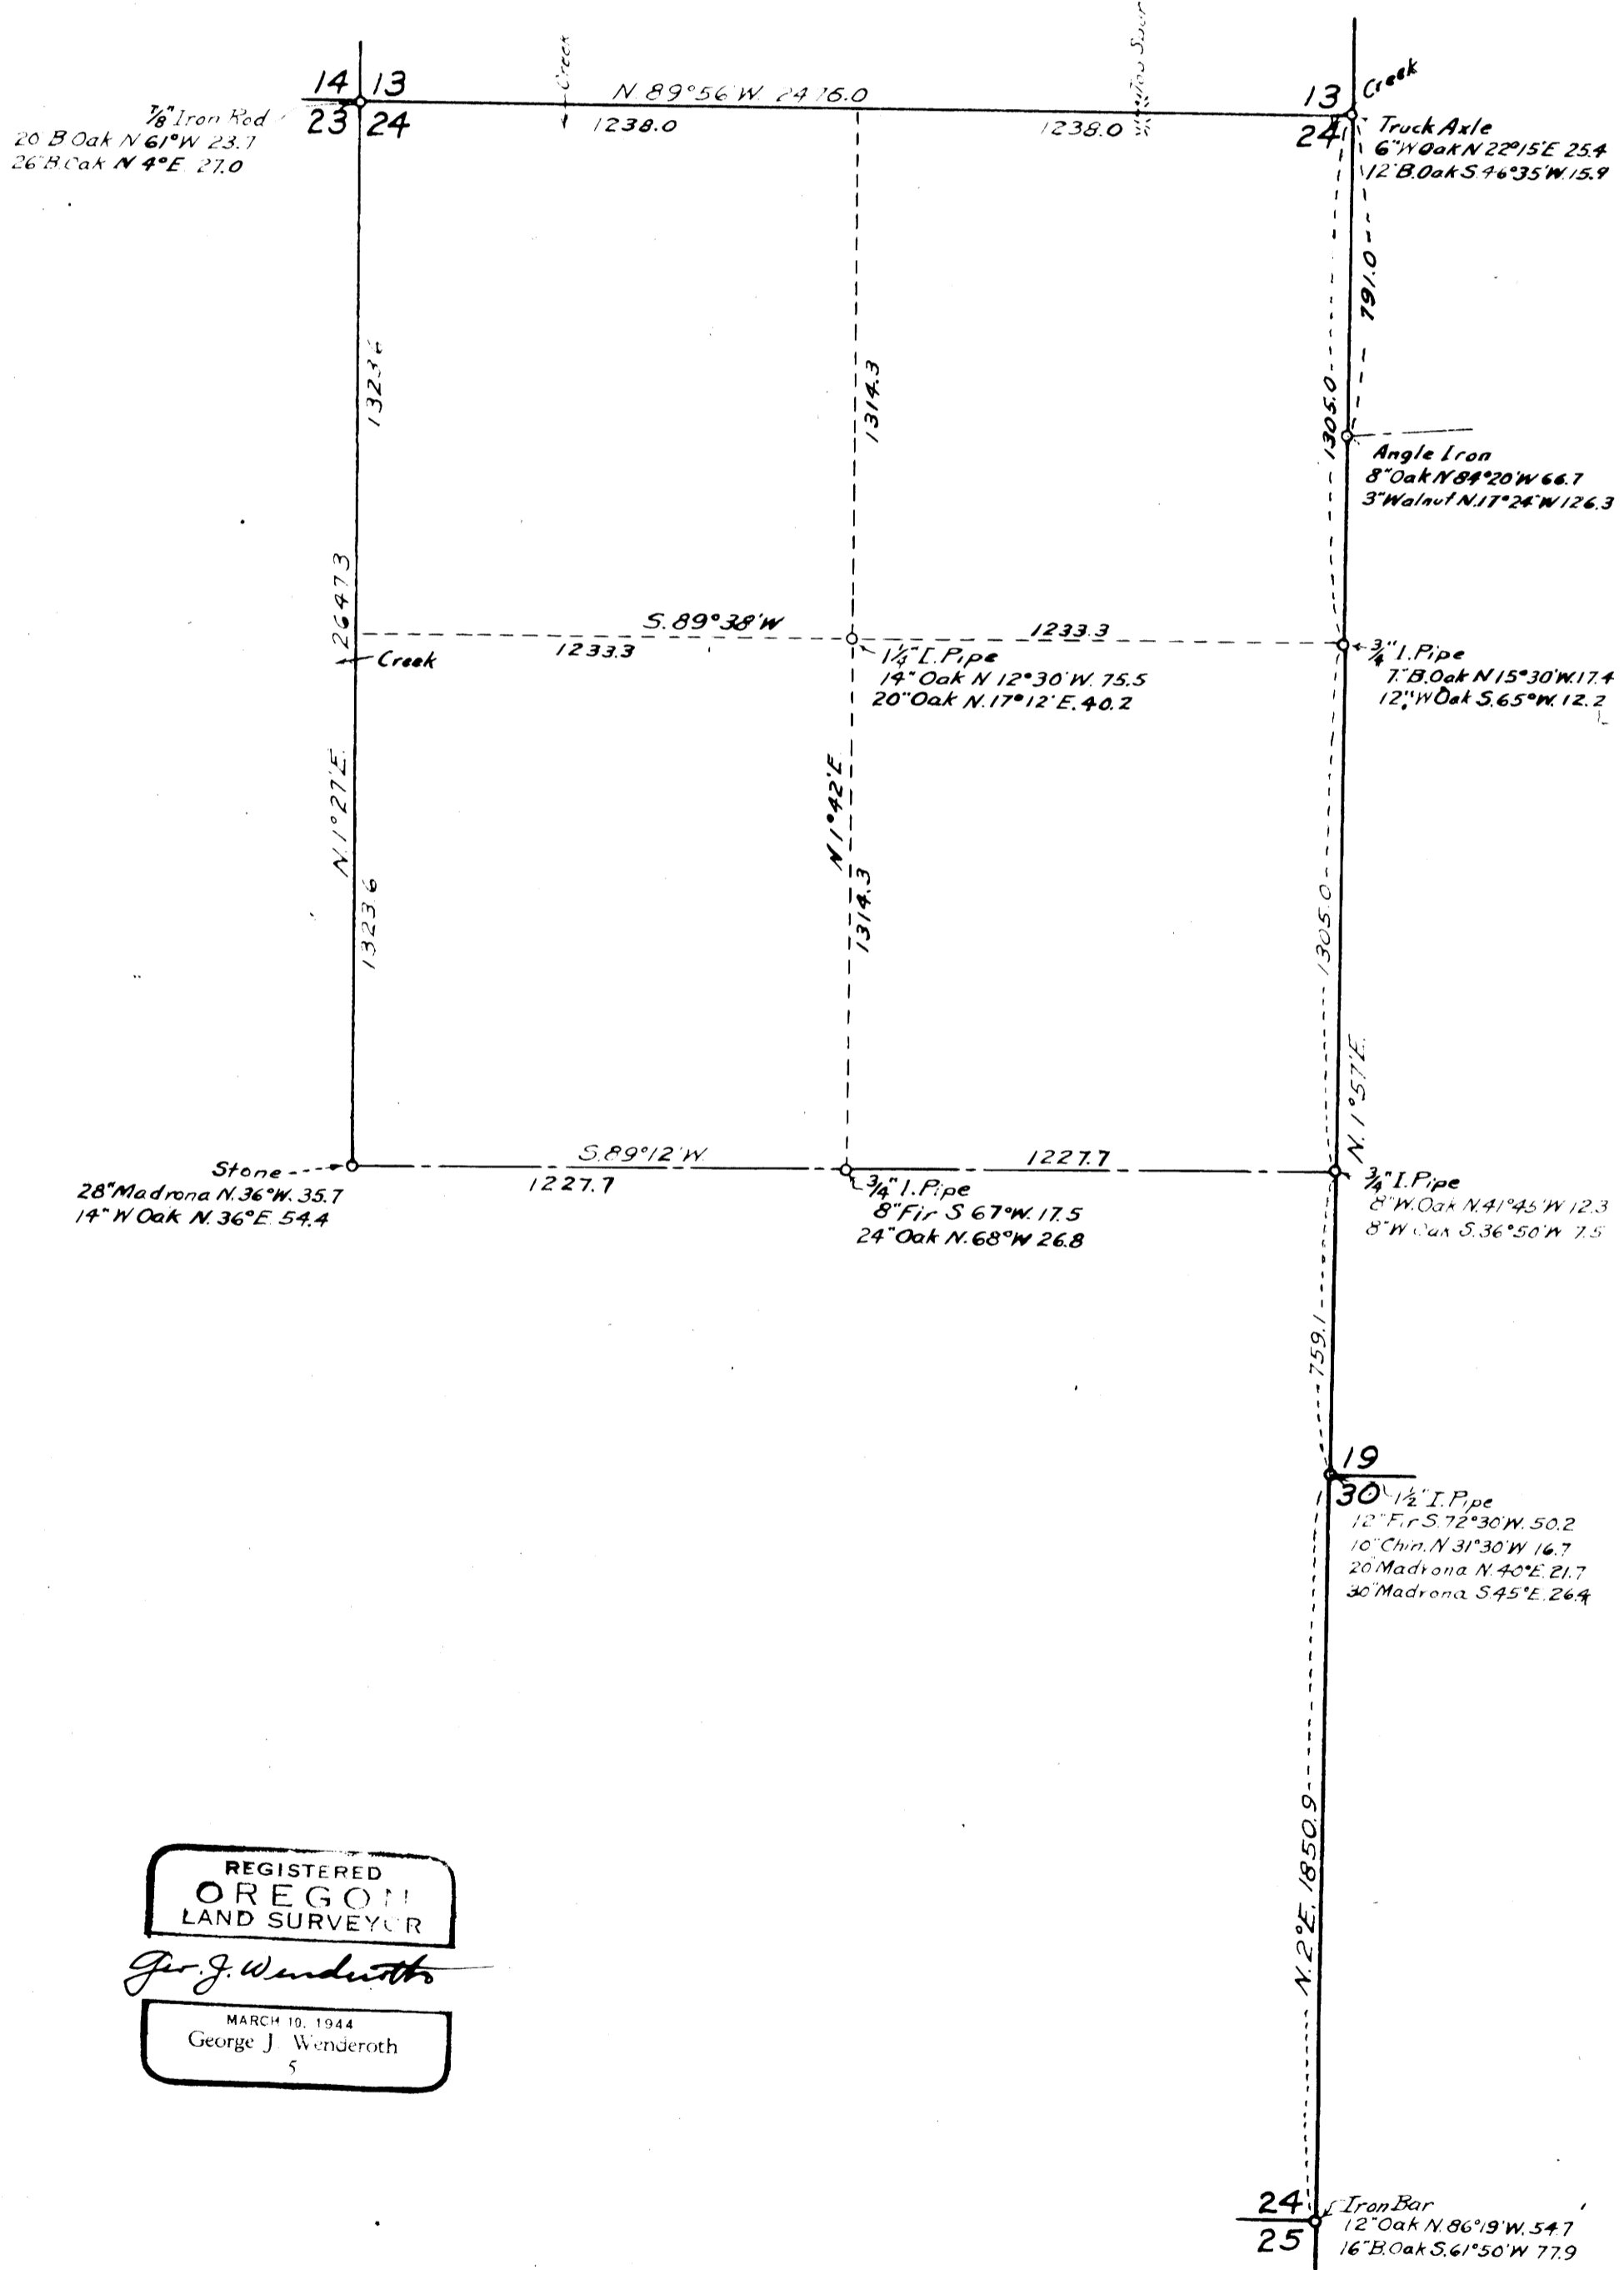

REGISTERED  
OREGON  
LAND SURVEYOR

*Geo. J. Wenderoth*

MARCH 10, 1944  
George J. Wenderoth  
5

NOTE :-  
THIS TRACING PREPARED BY "PHOTO-LINE"  
PROCESS FROM A PRINT, ON FILE IN THIS OFFICE,  
AND IS AN EXACT COPY THEREOF.  
MARCH 14, 1963

*Fred W. Darby*  
COUNTY SURVEYOR.