


26 25
35 36 FOUND BRASS CAP &
ALL B.T.S.

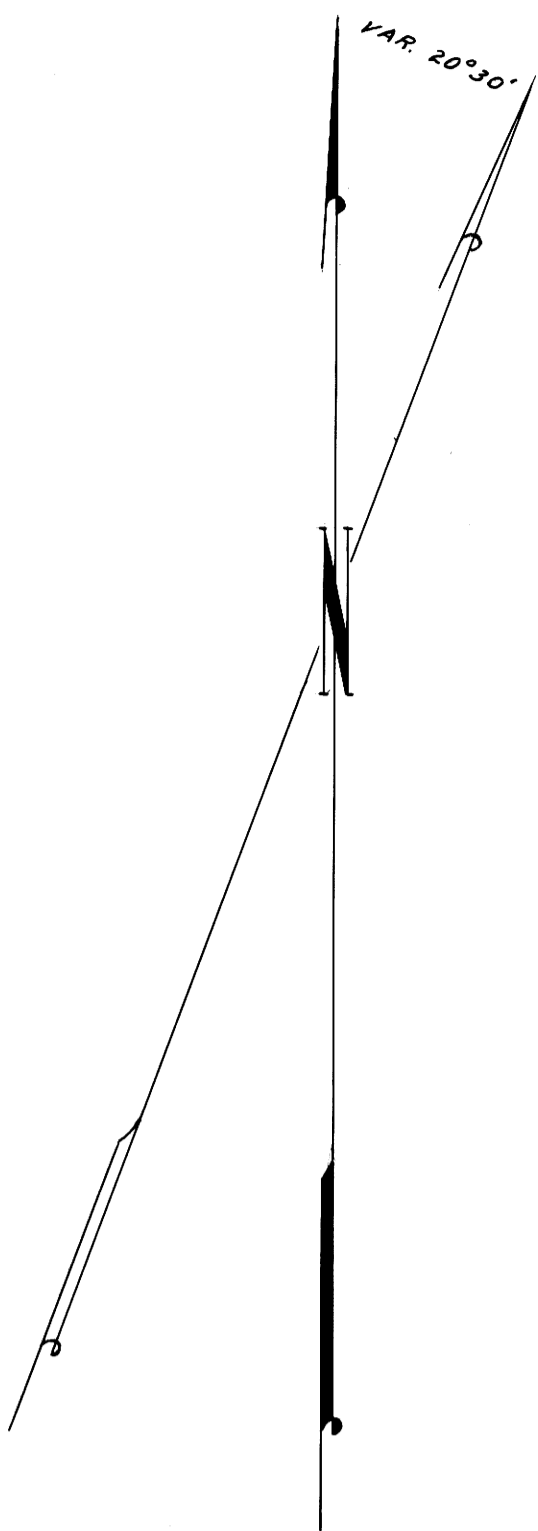

5294.35' ---
2647.175' ---

35 SET BRASS CAP MKD. COUNTY SURVEYORS
OFFICE 1963. 1/4 S 35/36 T.31S, R.6 W.
36 NEW B.T.S.:- 15" R. FIR, N 23° E 28.5'
SCRIBED 1/4 S 36. C.S. B.T.; 5" CEDAR
S 83° E 40.3' SCRIBED 1/4 S 36 C.S. B.T.;
E 16" FIR N 24.9' SCRIBED S 35
C.S. B.T.

--- N 0° 23' 30" E MAGNETIC
--- 2647.175' ---

COUNTY SURVEYORS FILE IN
DO NOT REMOVE FROM OFFICE

COUNTY SURVEYOR'S OFFICE
DOUGLAS COUNTY, OREGON

SURVEY TO SET 1/4 CORNER
SECTION 35-36 T.31S., R.6W. W.M.

FRED M. DARBY COUNTY SURVEYOR
SURVEYED APRIL 2, 1963 BY
JAMES W. BYRON - DEPUTY SCALE 1" = 200'
SURVEYED FOR C. & D. LBR. CO.

REGISTERED
OREGON
LAND SURVEYOR

James W. Byron
NOV. 6, 1953
JAMES W. BYRON
303

RENEW SECTION CORNER FROM 2 ORIGINAL
B.T.S. SET 3/4" IRON ROD AT SECTION CORNER.
NEW B.T.S.:- 12" HEMLOCK N 80° W 50.0'
SCRIBED S 35 T.31S, R.6 W C.S. B.T.; 12"
HEMLOCK S 12° E 3.5' SCRIBED S 1 T.35S,
R.6 W. C.S. B.T.; 9" CEDAR, EAST 43.1'
SCRIBED S. 36, T.31S, R.6 W. C.S. B.T.

35 36
2 1