

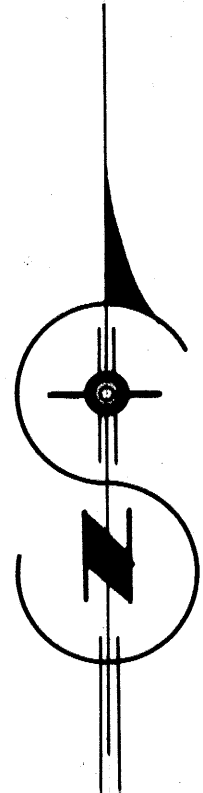


C.S. FILE 40/33
M 25-22

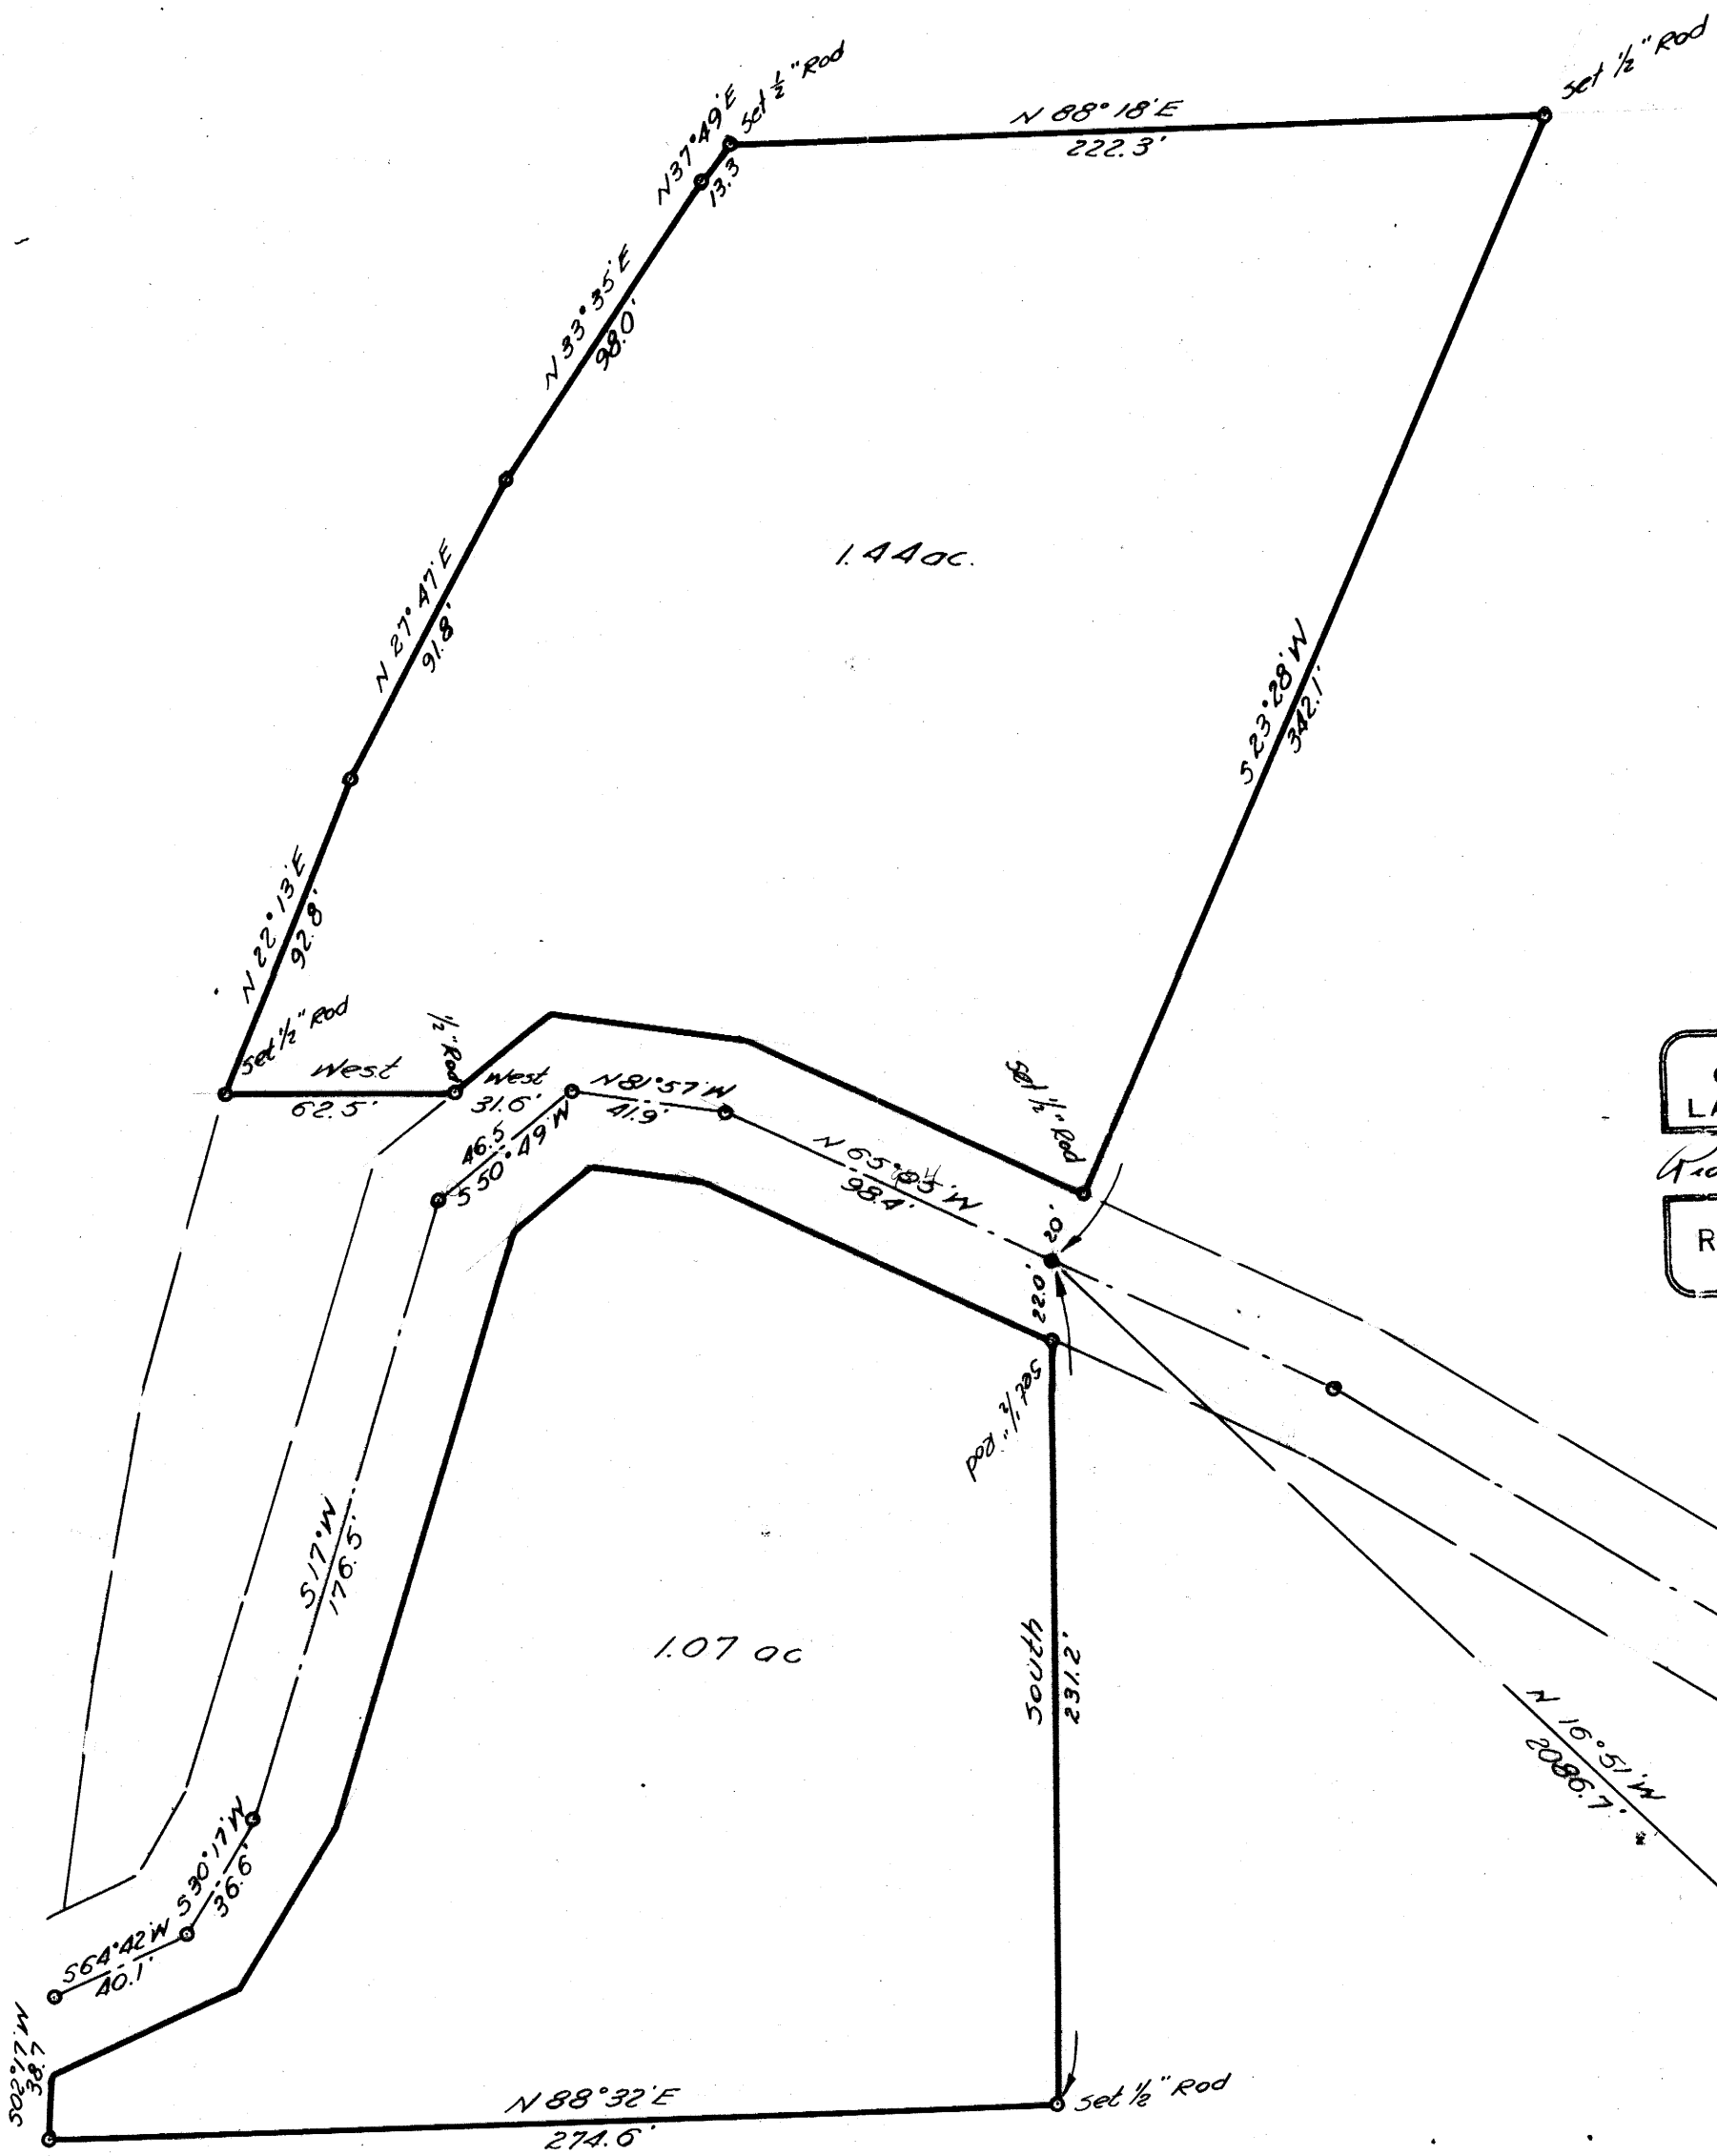

REGISTERED
OREGON
 LAND SURVEYOR
Richard R. Ecker
 NOVEMBER 9, 1945
RICHARD R. ECKER
 158

**COUNTY SURVEYORS FILE DATA
 DO NOT REMOVE FROM OFFICE**

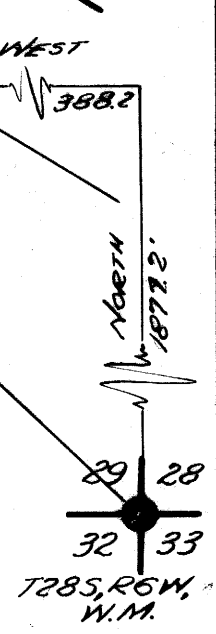

CS FILE FOLDER

CONTAINS

MORE

INFORMATION