


FILE 35 DEARIE 80

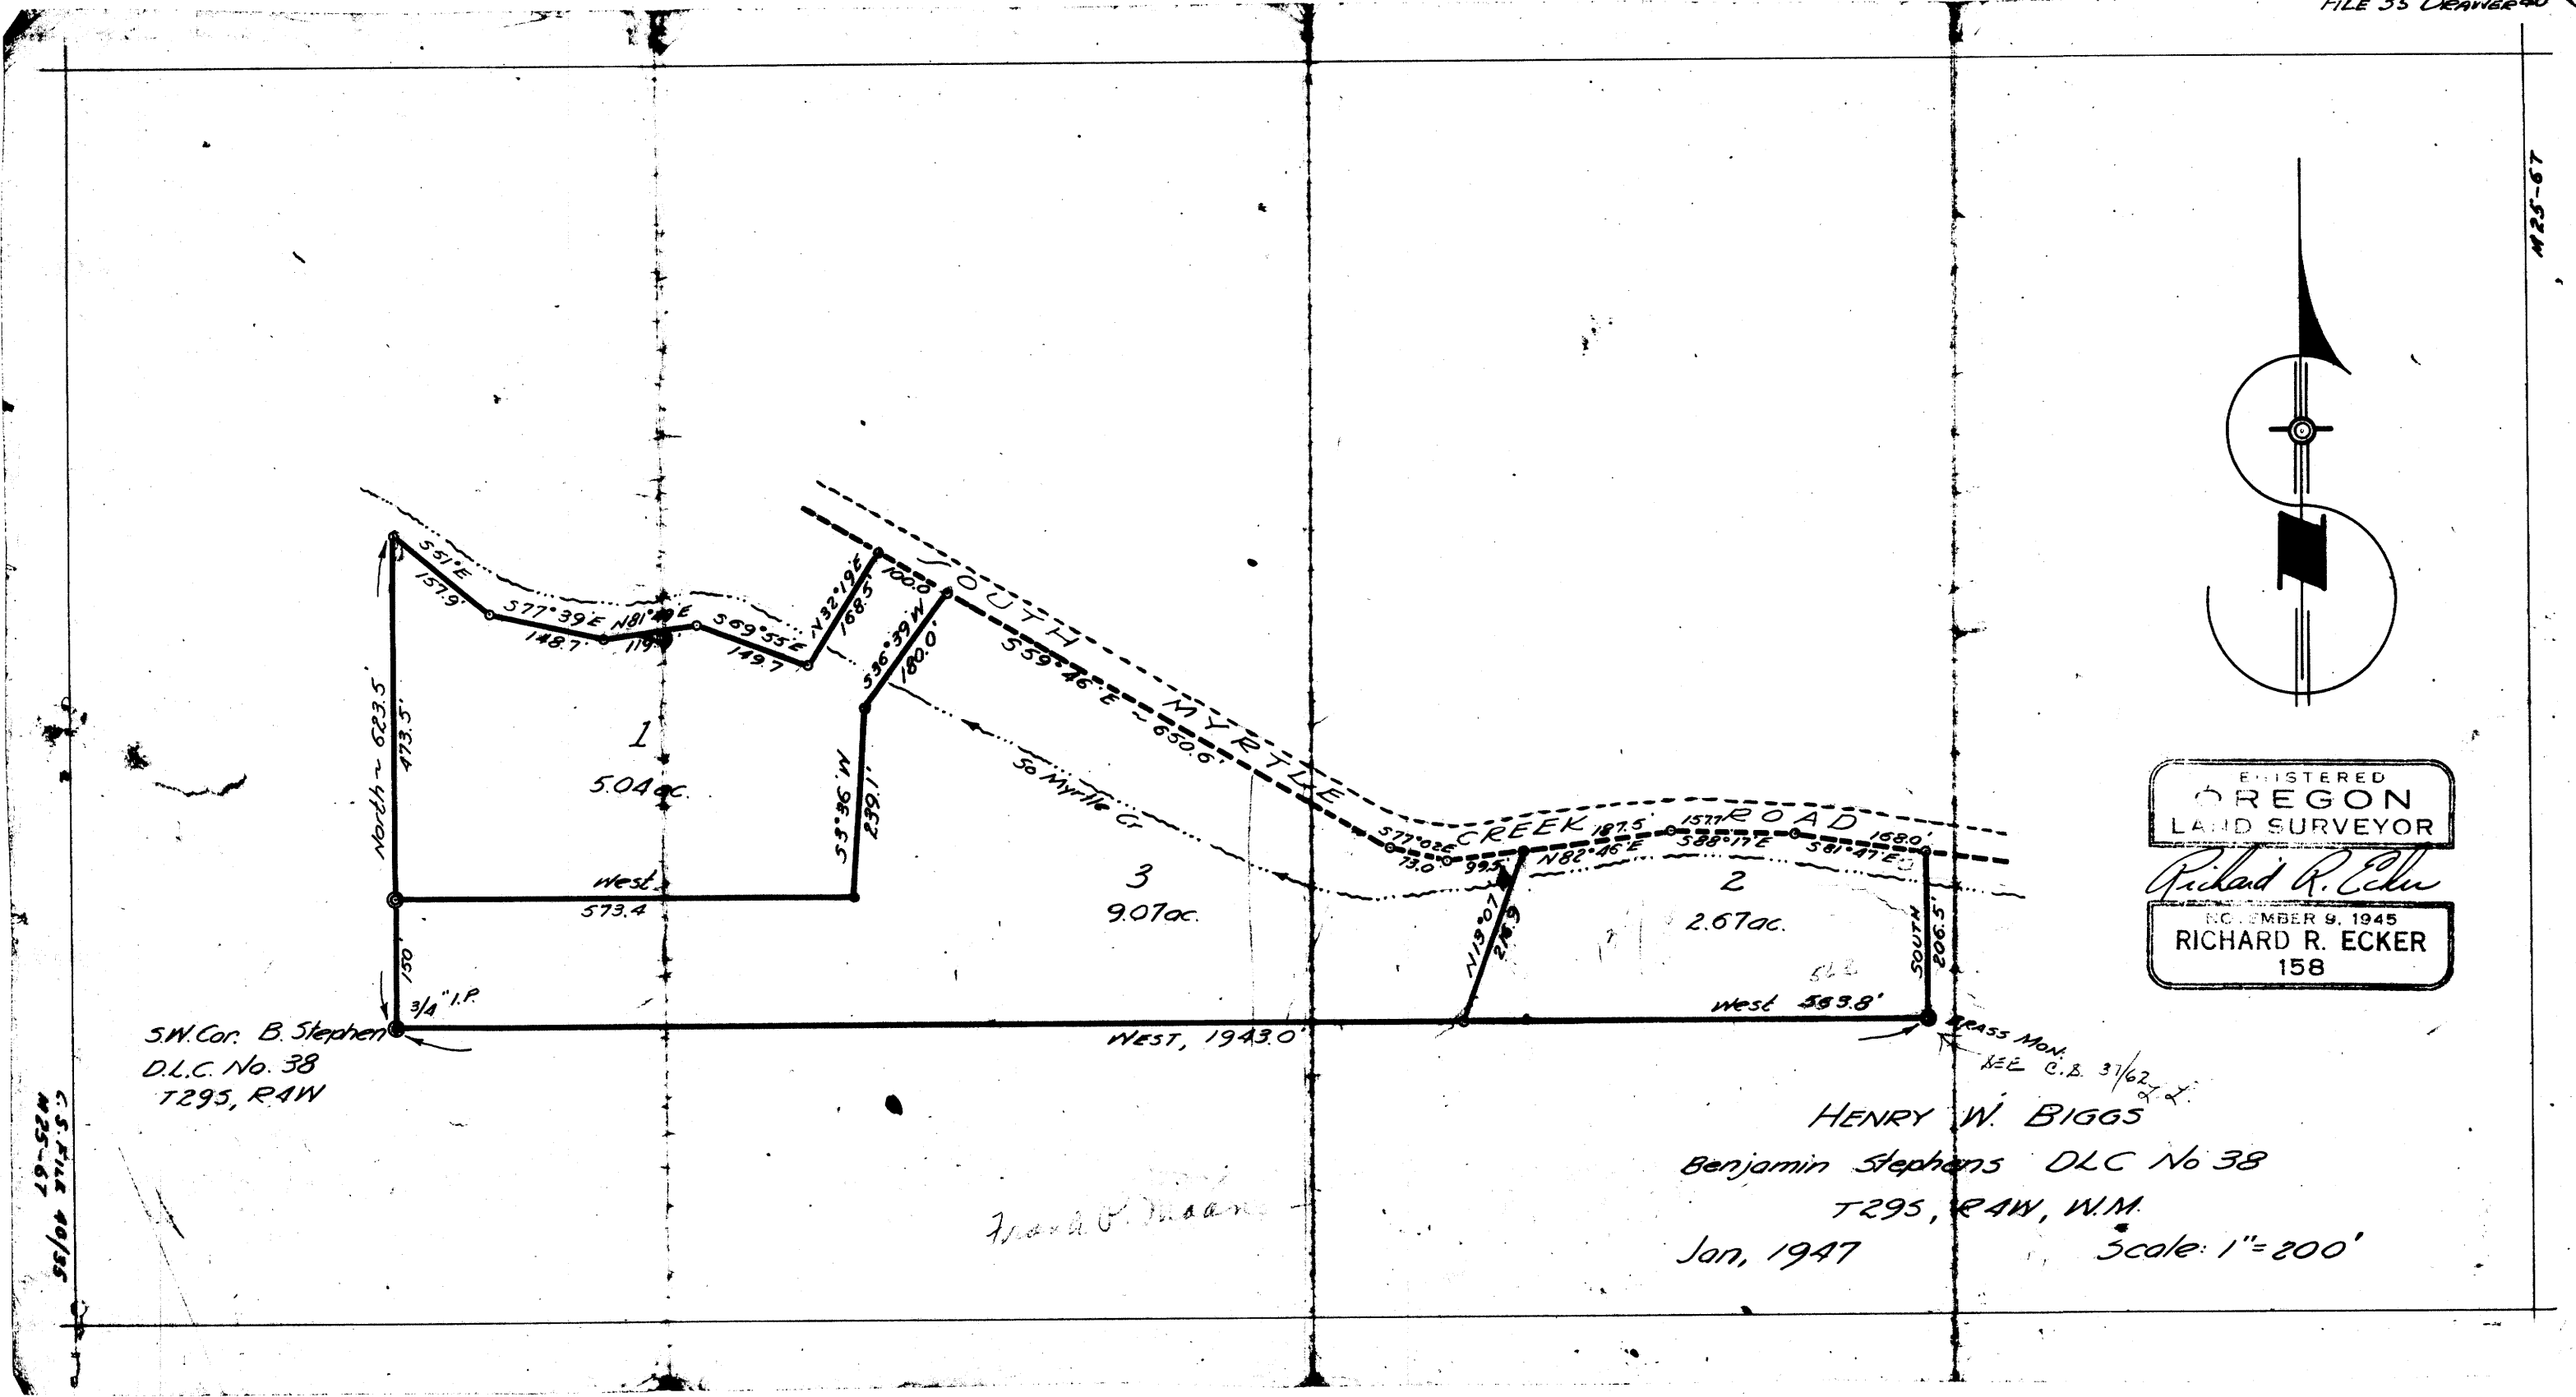

CS FILE FOLDER

CONTAINS

MORE

INFORMATION