

**COUNTY SURVEYORS FILE DATA
DO NOT REMOVE FROM OFFICE**

MAP FILE M-25-78


**SURVEY OF THE SOUTHERLY 66 FEET OF LOTS 8, 9 AND 10 OF
VACATED BLOCK 21, AND THE NORTHERLY 30 FEET OF THE
VACATED PORTION OF DOGWOOD AVENUE LYING ADJACENT TO
AND ABUTTING SAID LOTS, REEDSPORT ADDITION TO THE
CITY OF REEDSPORT, DOUGLAS COUNTY, OREGON**

For
RONALD HANSON

Scale: 1" = 100'
Corners found: ○
Corners set: ○
Basis of bearing: E Dogwood Avenue

May 21, 1963

REGISTERED
OREGON
LAND SURVEYOR
Warren D. Hootman
MAY 10, 1957
WARREN D. HOOTMAN
399

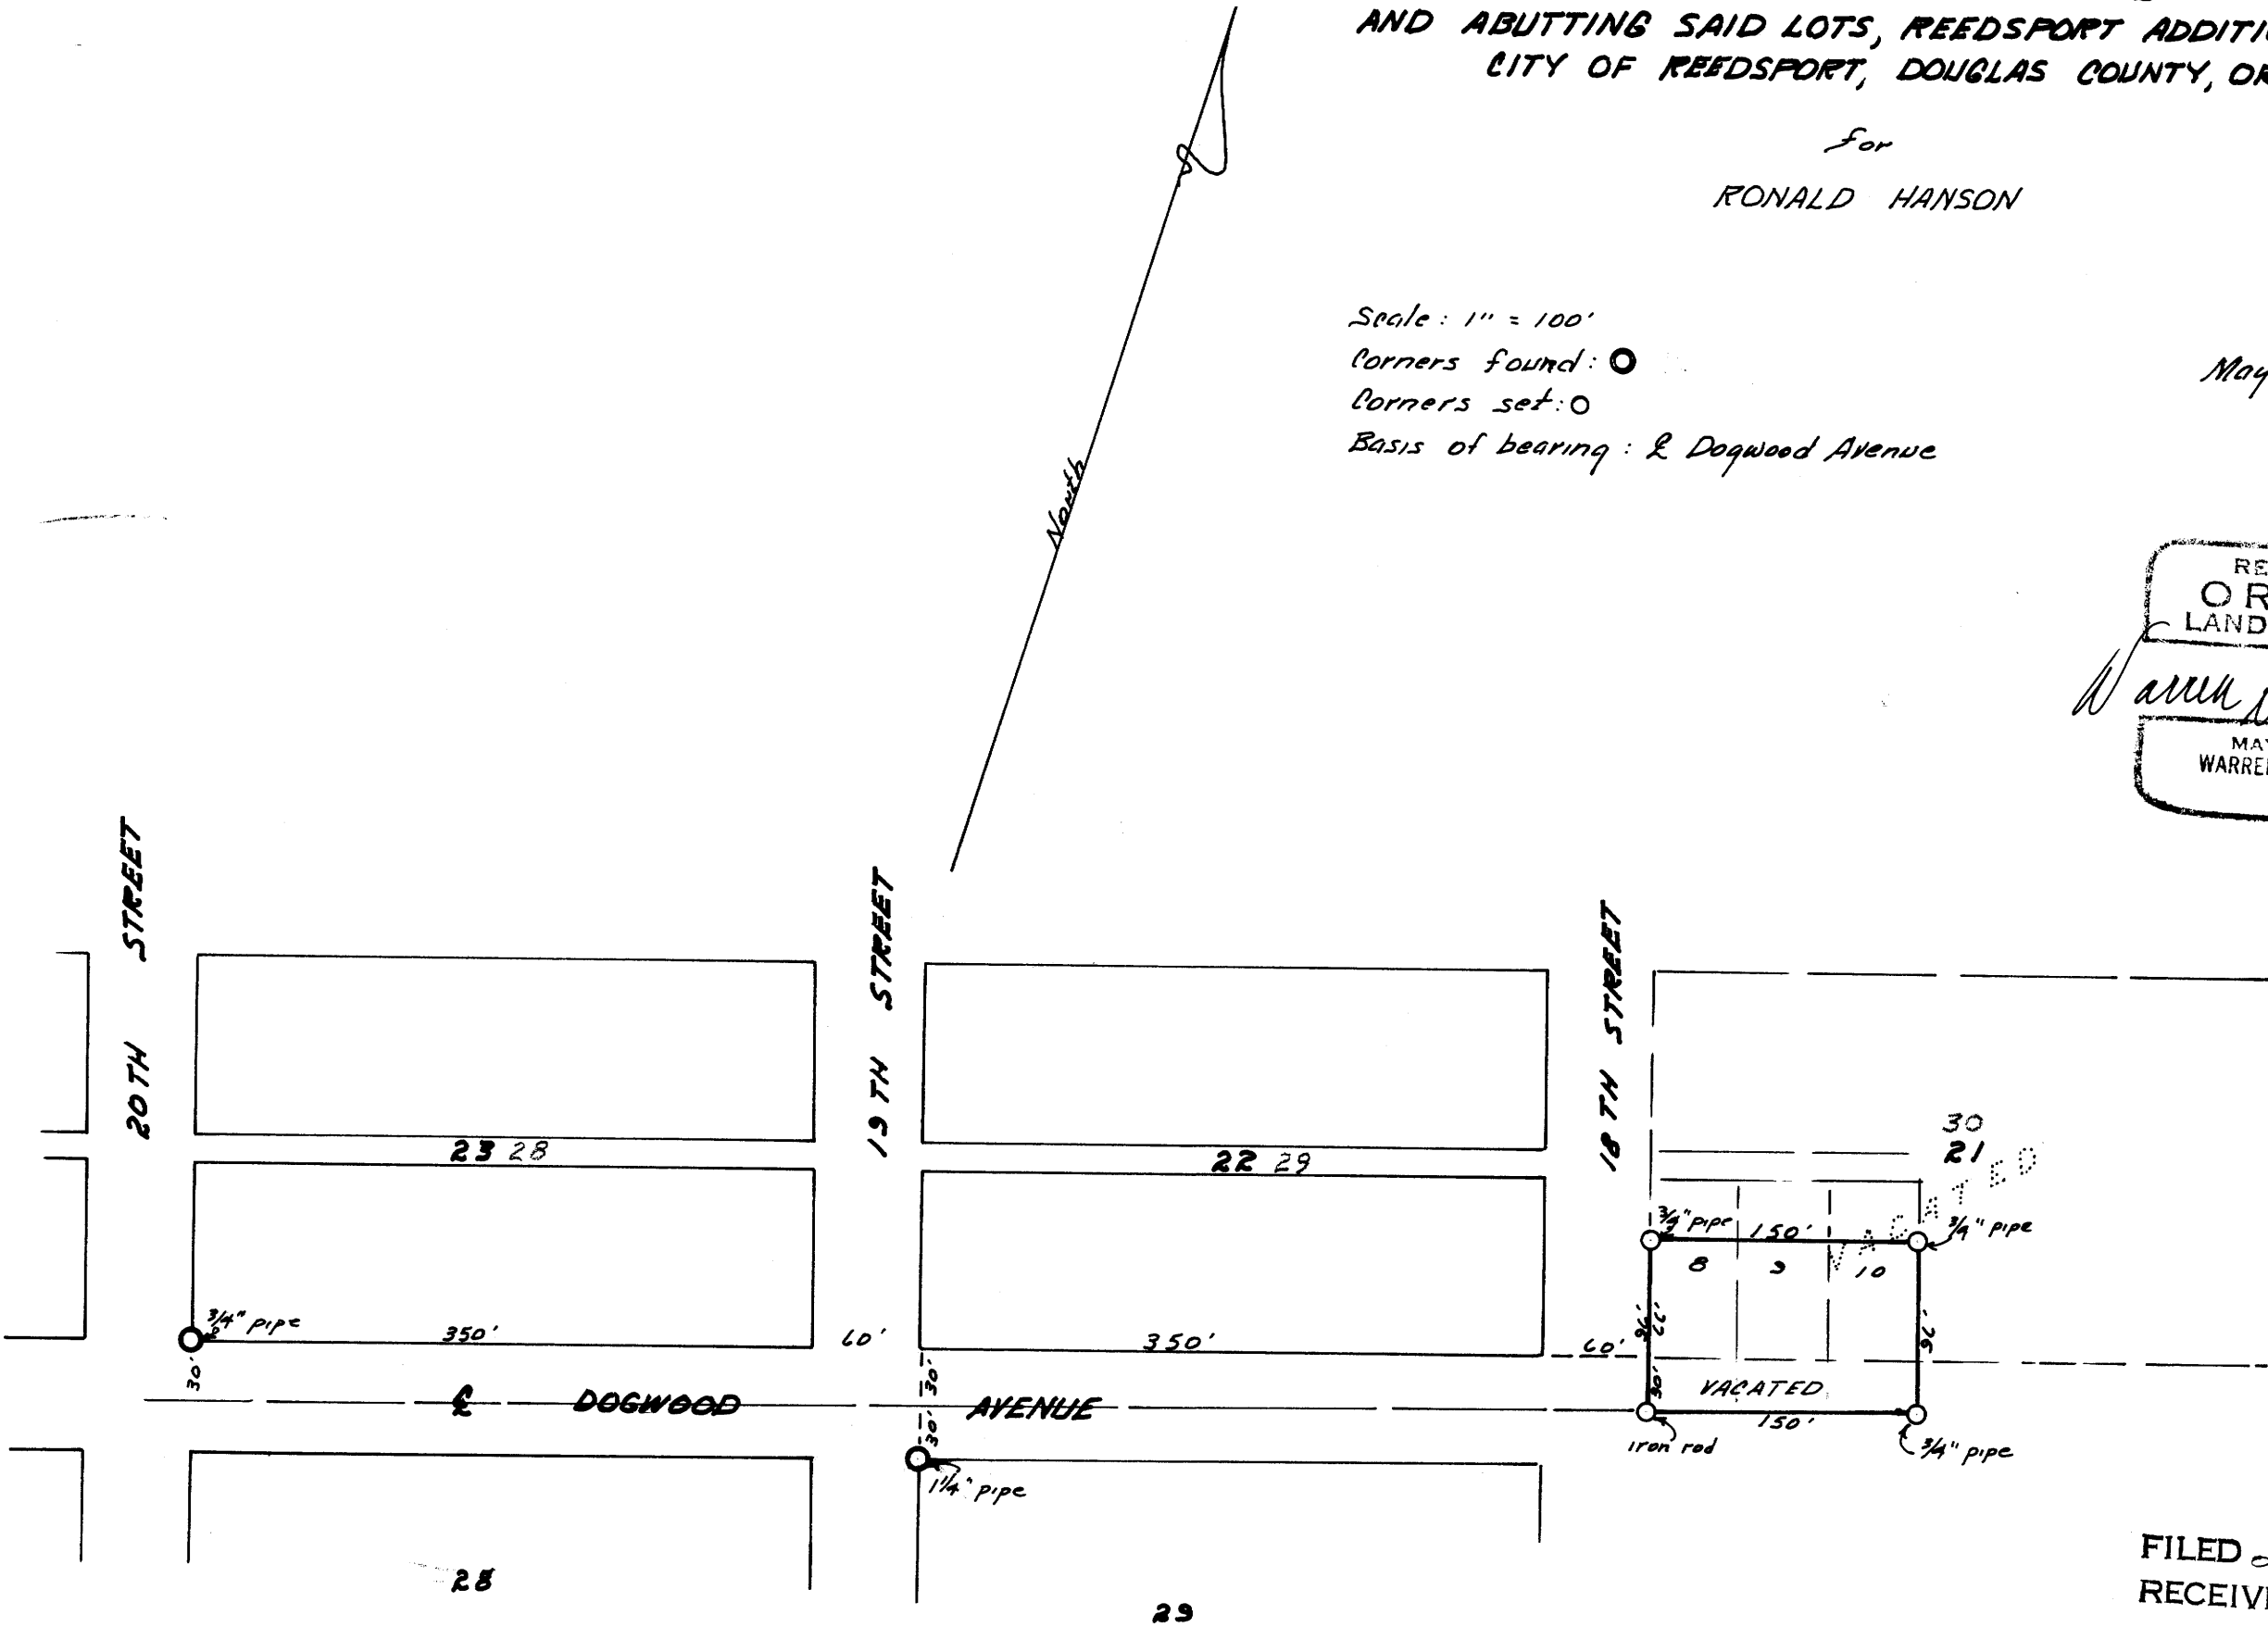

FILED *L.L.*
RECEIVED
JUN 5 1963
COUNTY SURVEYOR
DOUGLAS COUNTY, ORE.

M 25-78