


C.S. FILE 40/74
M26-1 P

S.W. CORNER
LAZURAS WRIGHT
D.L.C. # 45
T 29 S R 5 W. W.M.

NORTH
2103.0'

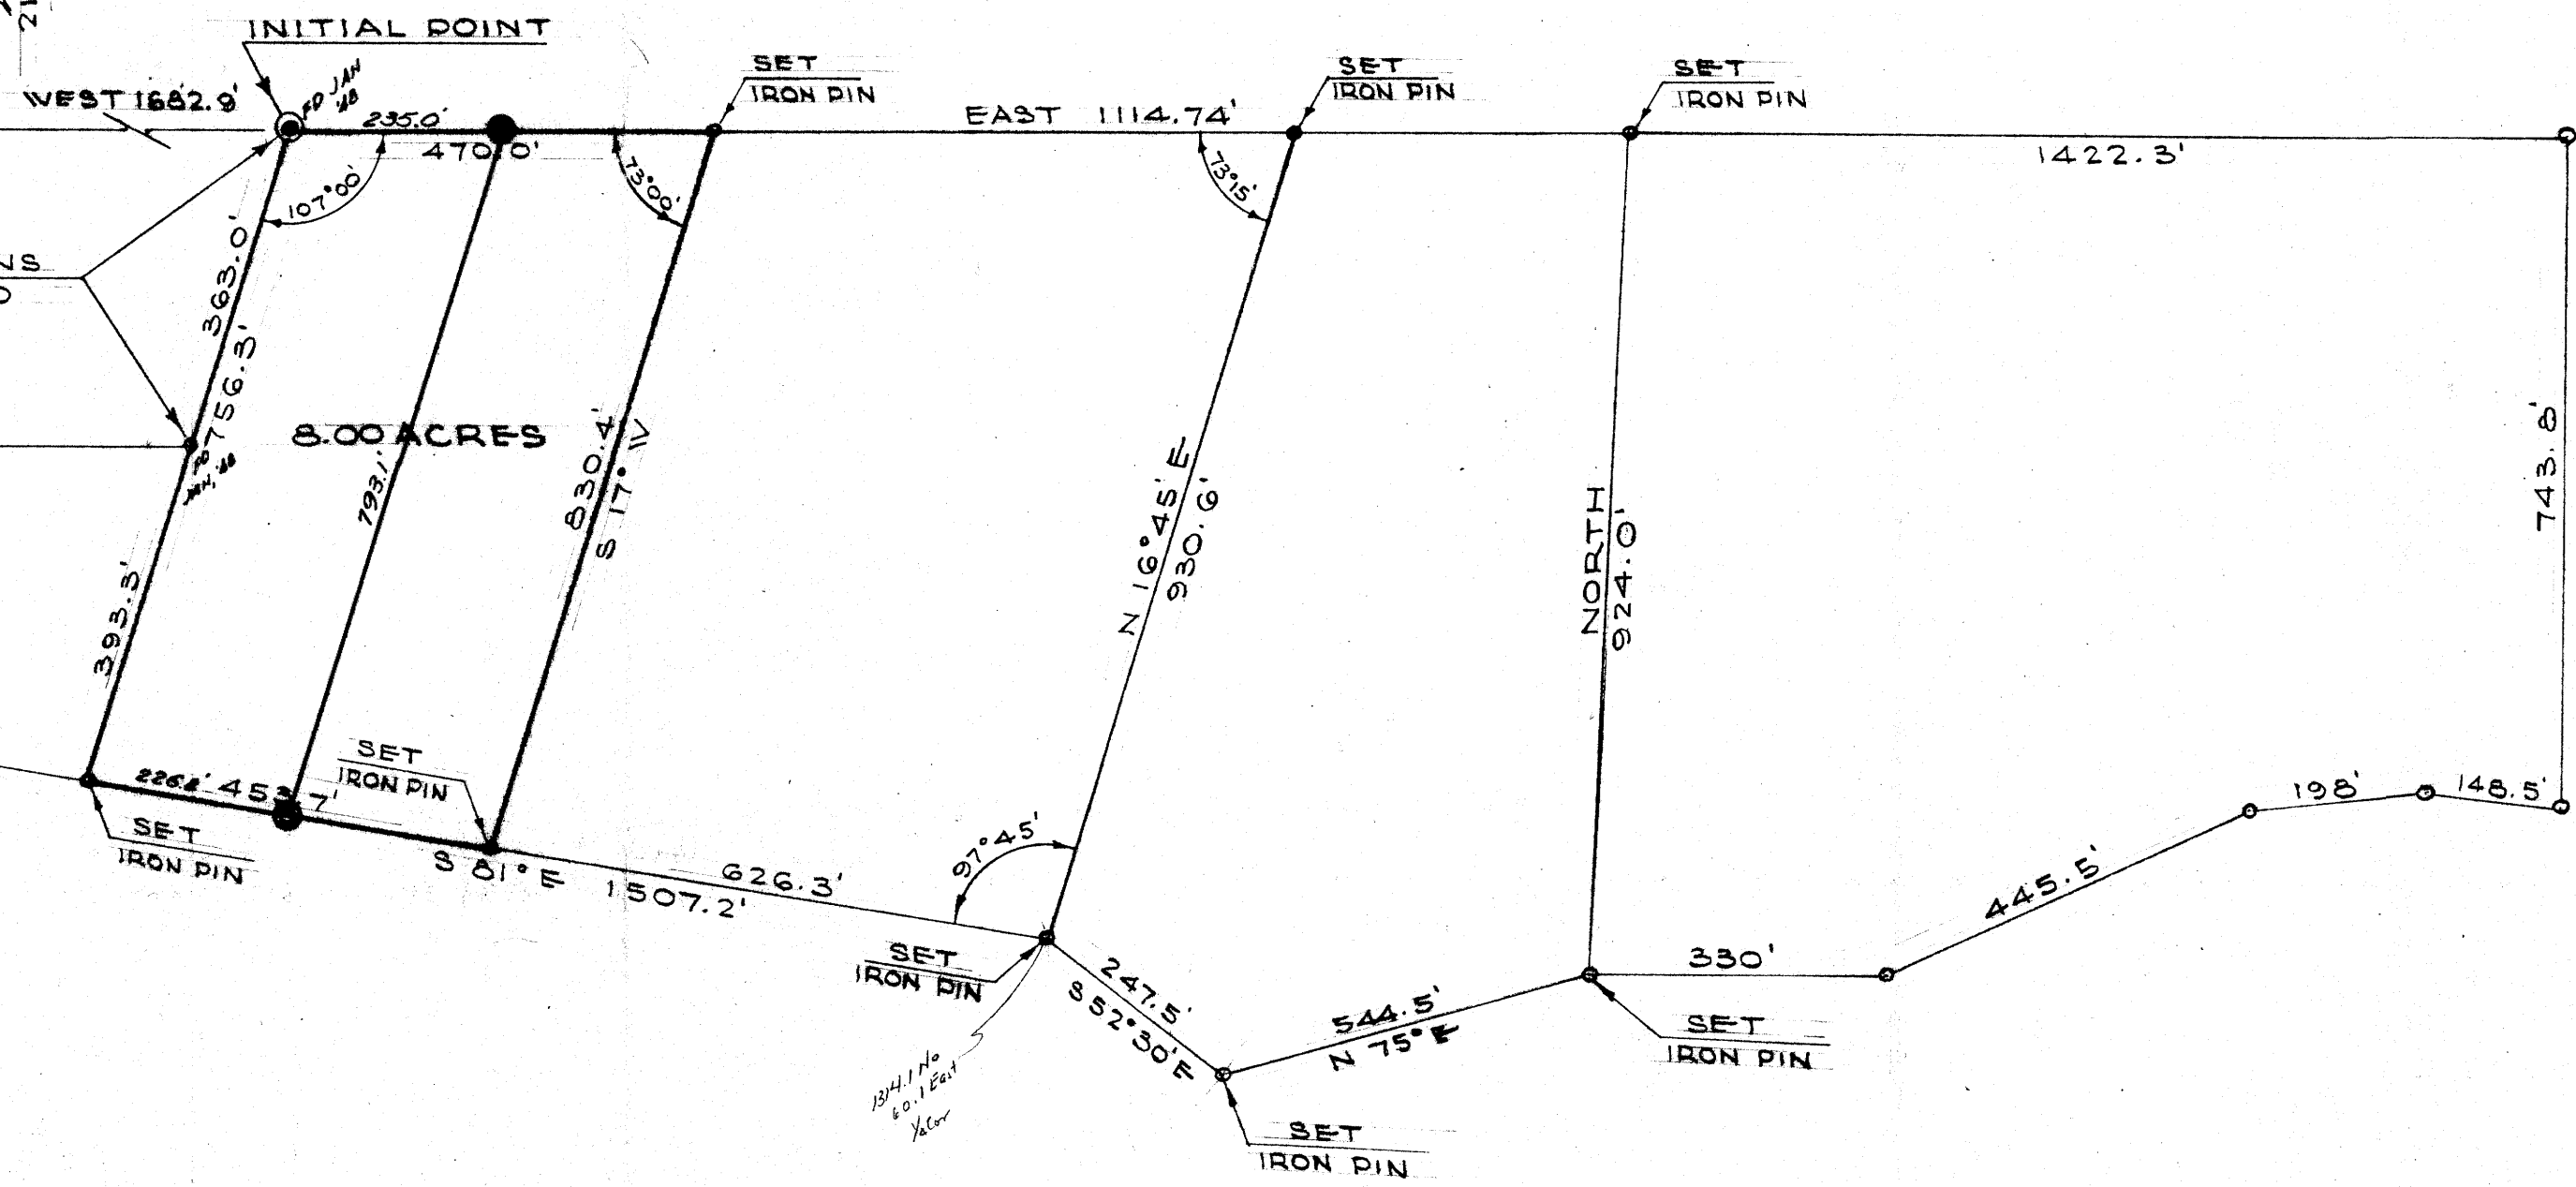

1/2" IRON PINS
FOUND

8.00 ACRES

COUNTY SURVEYORS FILE DATA
DO NOT REMOVE FROM OFFICE

REGISTERED
OREGON
LAND SURVEYOR

Richard R. Ecker

NOVEMBER 9, 1945
RICHARD R. ECKER
158


PLAT OF
MCCOY & ALDERMAN
PROPERTY

VICINITY OF MYRTLE CREEK,
DOUGLAS COUNTY, ORE.

JUNE 1947

SCALE 1" = 200'

C.S. FILE 40/74
M26-1

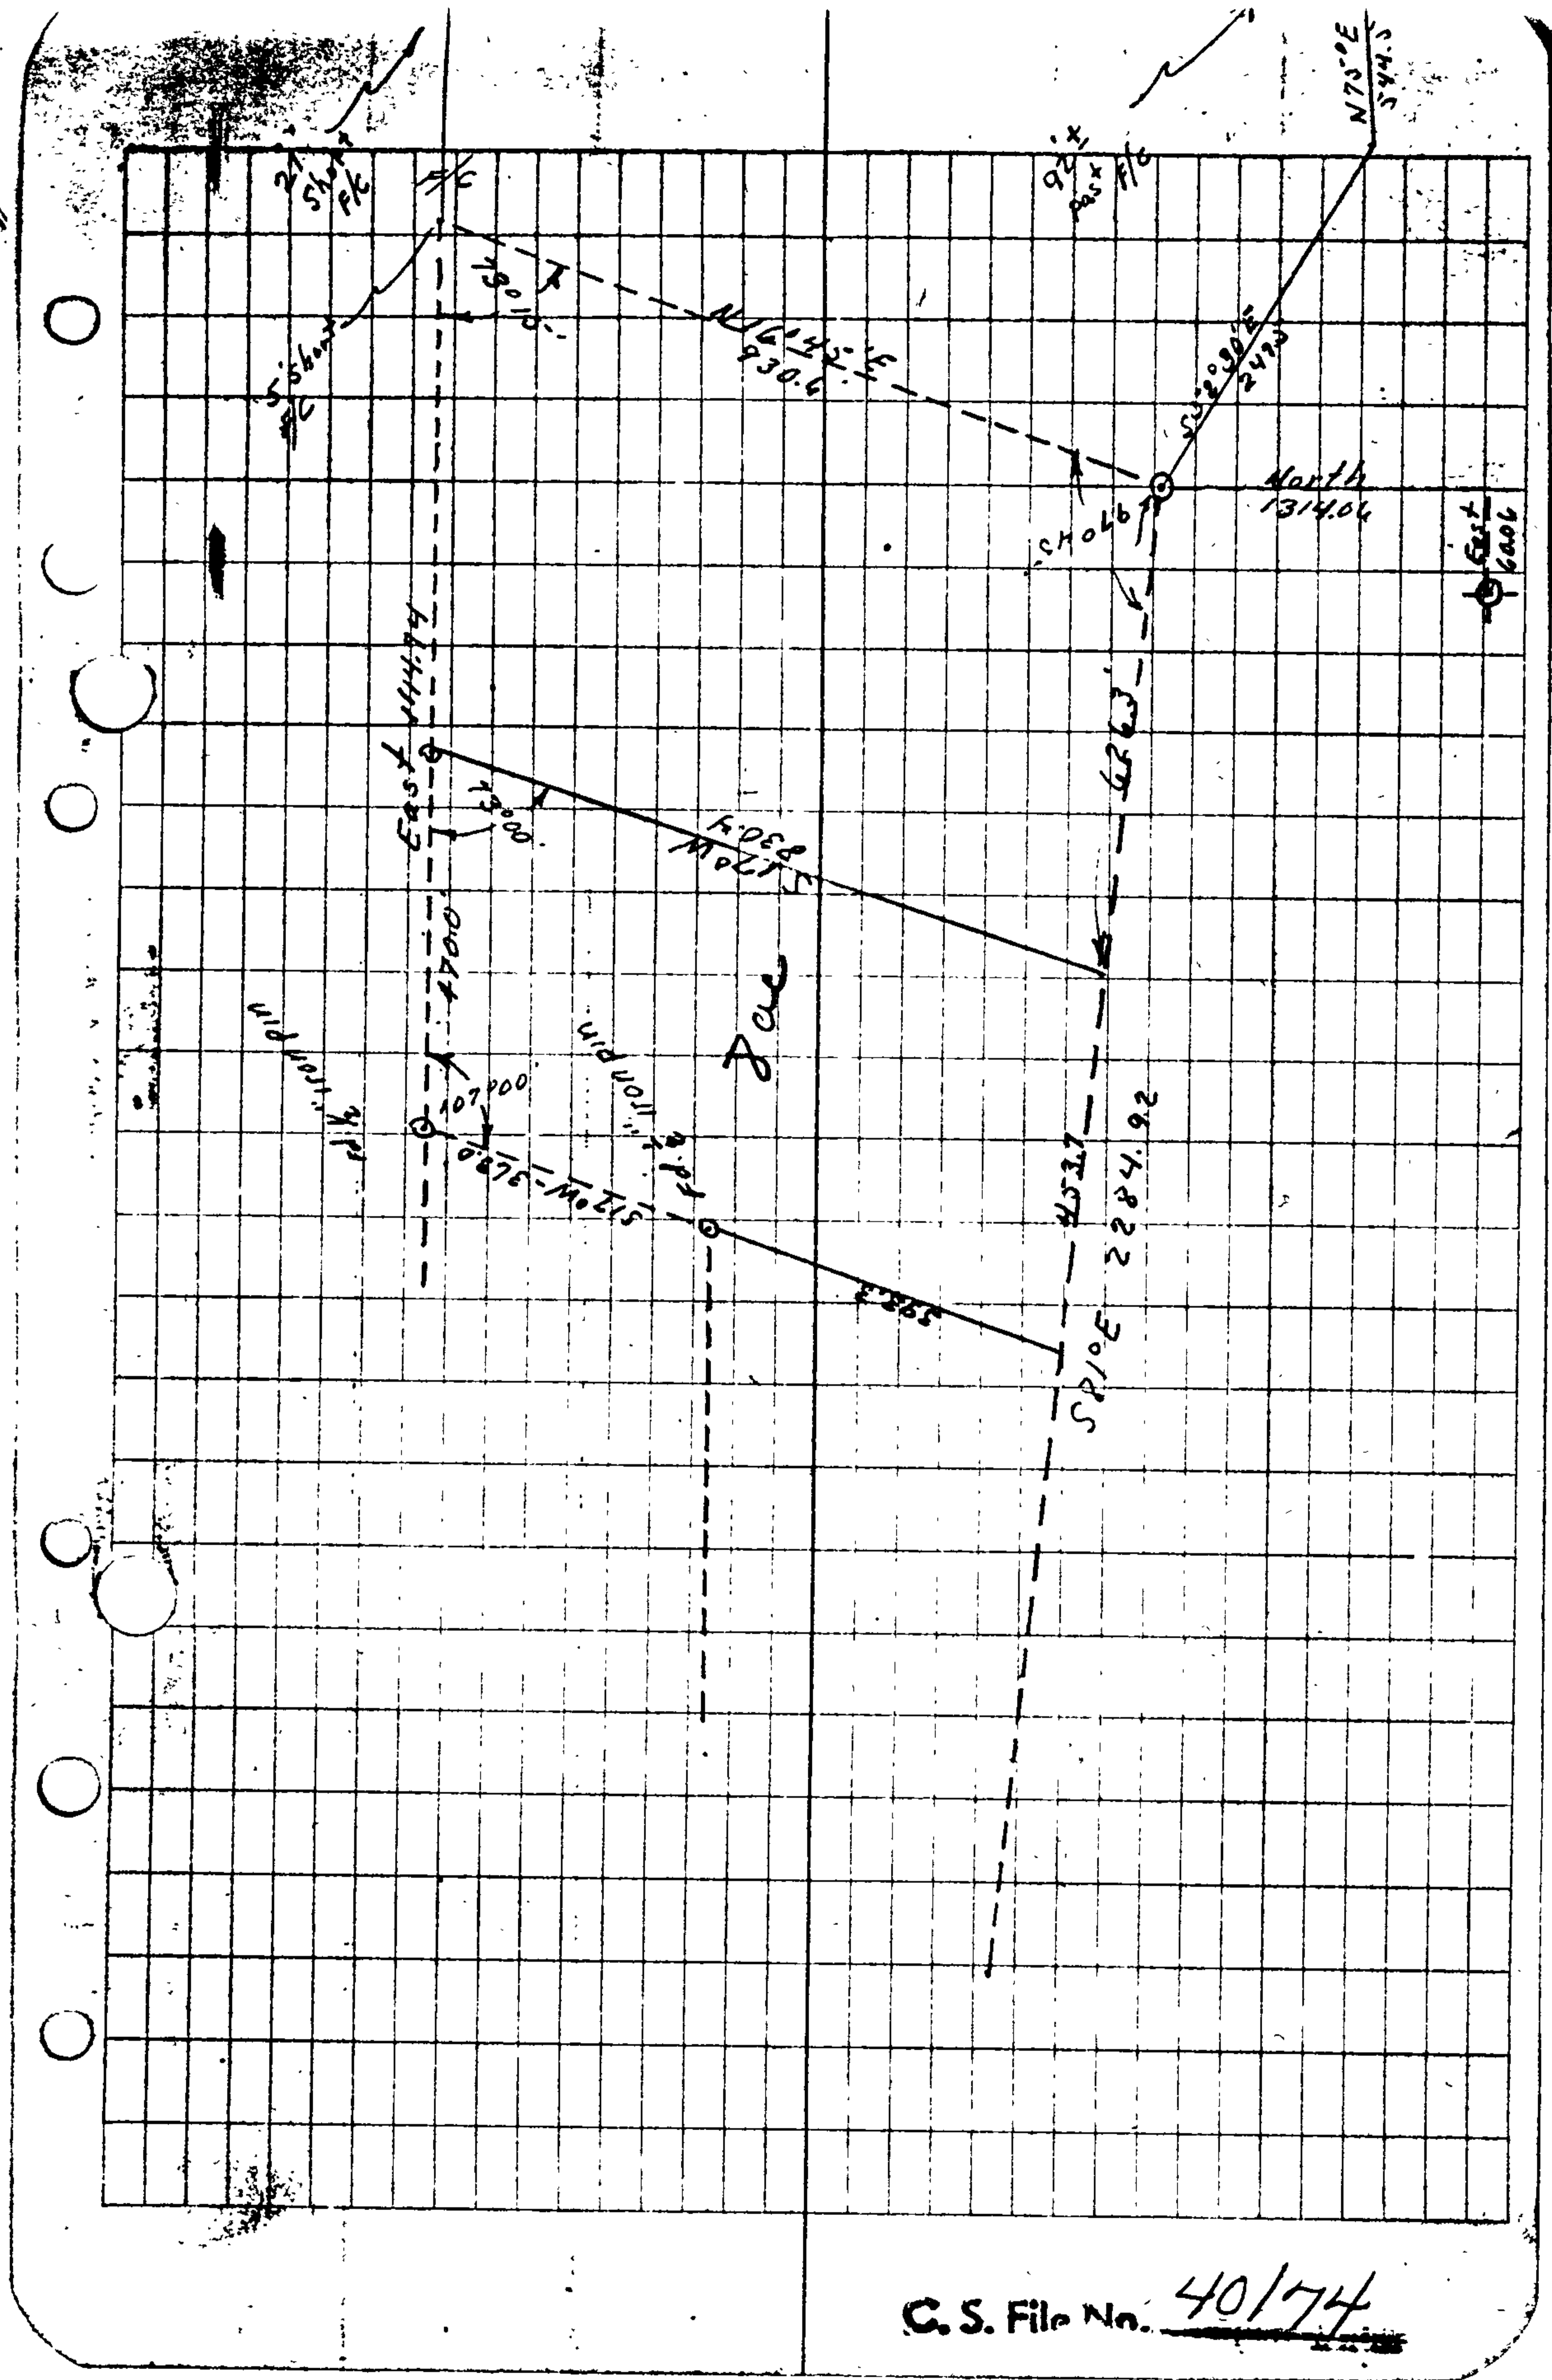

| M ^c Co ₄ | | | | | |
|--------------------------------|-----------|----------|-----------|---------|-------|
| North from I.P. (1/2 Cor.) | | | | | |
| STA. | HE. DIST. | DEF. | SL. DIST. | VA. | COS. |
| | 82.1 | North | | | |
| 0+22.1 | | | | | |
| | 70.4 | SS 90° L | SS 777 | 25° | 90631 |
| | 83.3 | 90° R | 846 | 10° | 98481 |
| | 92.3 | | 100.0 | 13° 17' | 97325 |
| | 100.0 | | | | |
| | 98.7 | | 100 | 9° 15' | 98700 |
| | 100.0 | | | | |
| | 100.0 | | | | |
| | 100.0 | | | | |
| 7+61.4 | | | | | |
| | 625.0 | | | | |
| | | | | | |
| | 72.3 | 180° L | | | |

①

Survey for

Clifton C. Bulley
Box 14, Myrtle Creek
Oregon

A Part of McCoy - Alderman
survey dated June, 1947

situated

^{1/4}
NE ^{1/4} Section 33, T29S, R5W, W14

Douglas Co.

Oregon

R.R. Ecker
L.S. 158

U.S. File No. 40/74

| 23 Jan, 1948 | Ecker M | φ Johnson | | |
|--------------|---------|-----------|------|--------|
| BRG | SLOIST | VA | COJ | H.DIST |
| | | | | |
| | | | | |
| | | | | |
| | | | | |
| East | | | | 35.0 |
| | 200.0 | 5° | 9962 | 199.24 |
| | | | | 0.76 |
| | | | | 235.00 |
| <hr/> | | | | |
| | | | | 163.0 |
| | | | | 200.0 |
| | | | | 193.3 |
| | | | | 200.0 |
| | | | | 756.3 |
| | Trance | | | |
| | | | | |
| 581° E | | | | 26.8 |
| | | | | 200.0 |
| | | | | 226.8 |
| | | | | |
| | | | | |

③

At NW Cor of Bulley property found 1/2" iron rod by T. in hole in fence corner -
 Ed 1/2" iron Rod S15°W, 363.0 - Used for base brg and turn left 107°

Set 4x4 Cedar Stake up thru top

From same Initial Point sight S15°W

Ad pin bent down in drawing - Straightened and set marker stake

82° RT inside C

Set 4x4 Cedar Stake up tack

C. S. File No. 40/74

CS FILE FOLDER

CONTAINS

MORE

INFORMATION