


COUNTY SURVEYORS FILE DATA
DO NOT REMOVE FROM OFFICE

SURVEY FOR DEED DESCRIPTION
SECT. 30, TRRS R4W. W.M. ORE.
Scale 1" = 200'
July 1963
Hub REALTY for Yoncalla, Ore

REGISTERED
OREGON
LAND SURVEYOR
Wilford N. Haines
MAY 7, 1948
WILFORD N. HAINES
239

FILED *L.L.*
RECEIVED
JUL 19 1963
COUNTY SURVEYOR
DOUGLAS COUNTY, ORE.

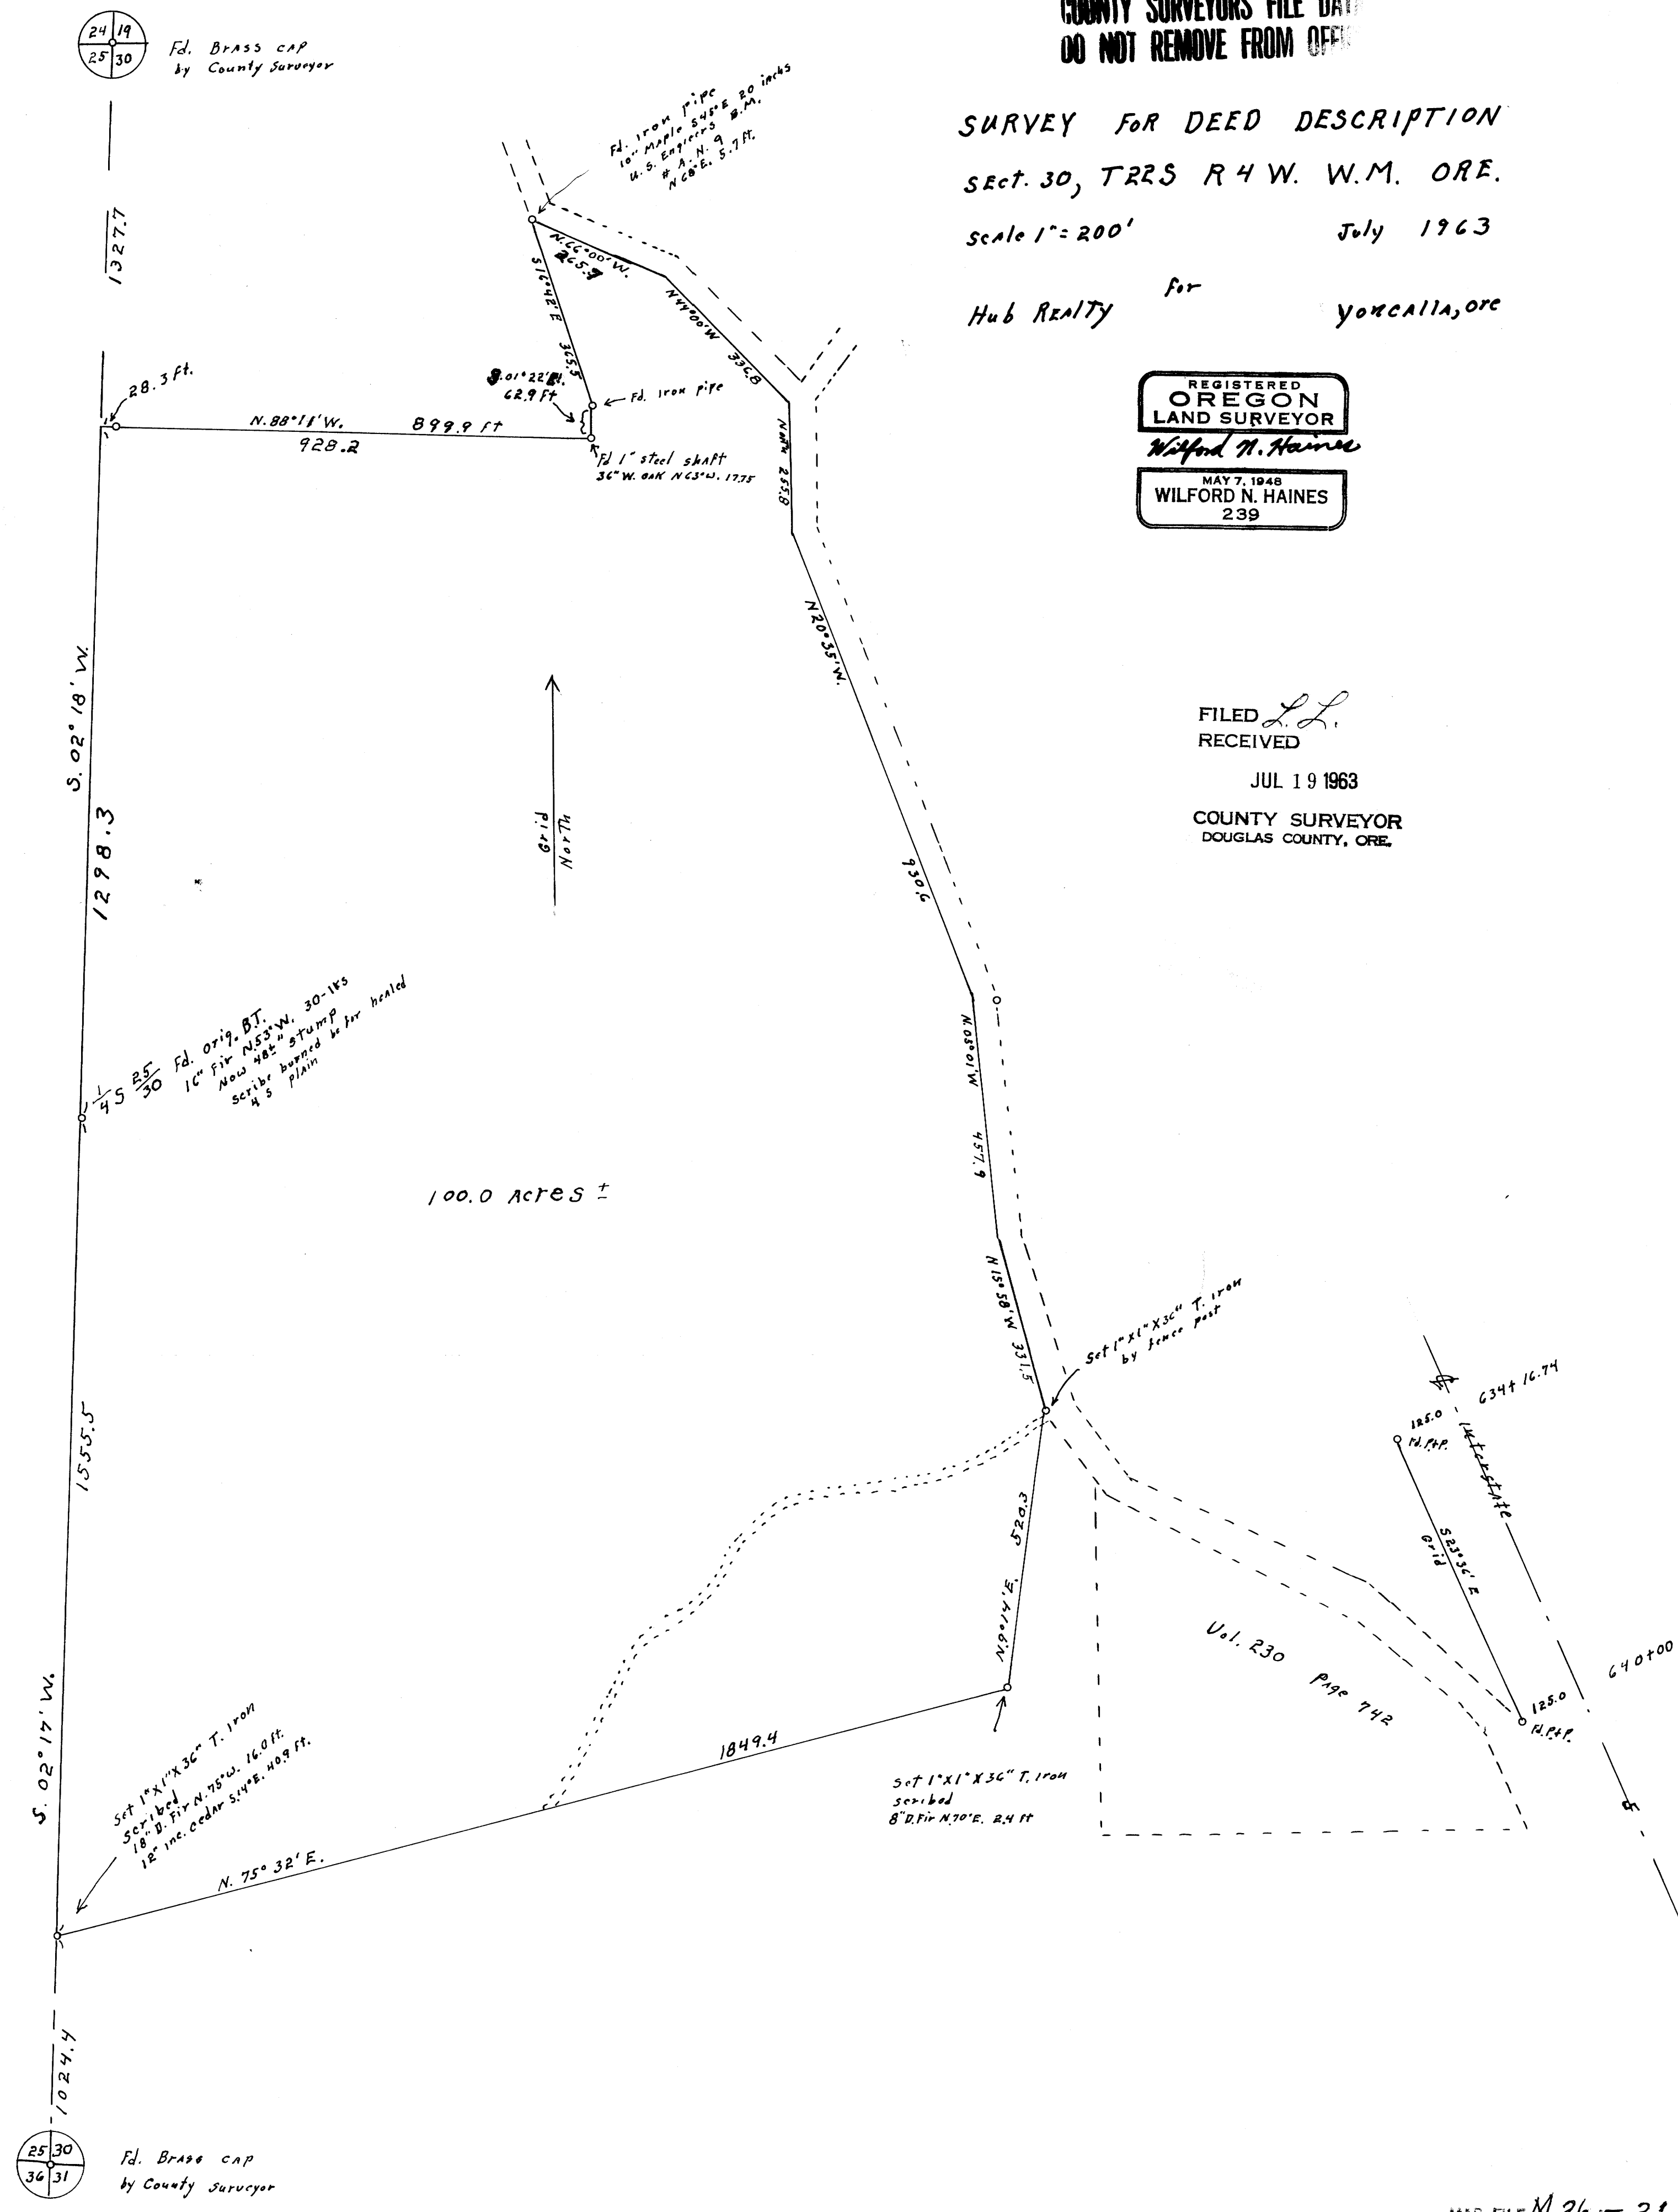

24 19
25 30
Fd. Brass cap
by County Surveyor

25 30
36 31
Fd. Brass cap
by County Surveyor