



COUNTY SURVEYORS FILE  
DO NOT REMOVE FROM

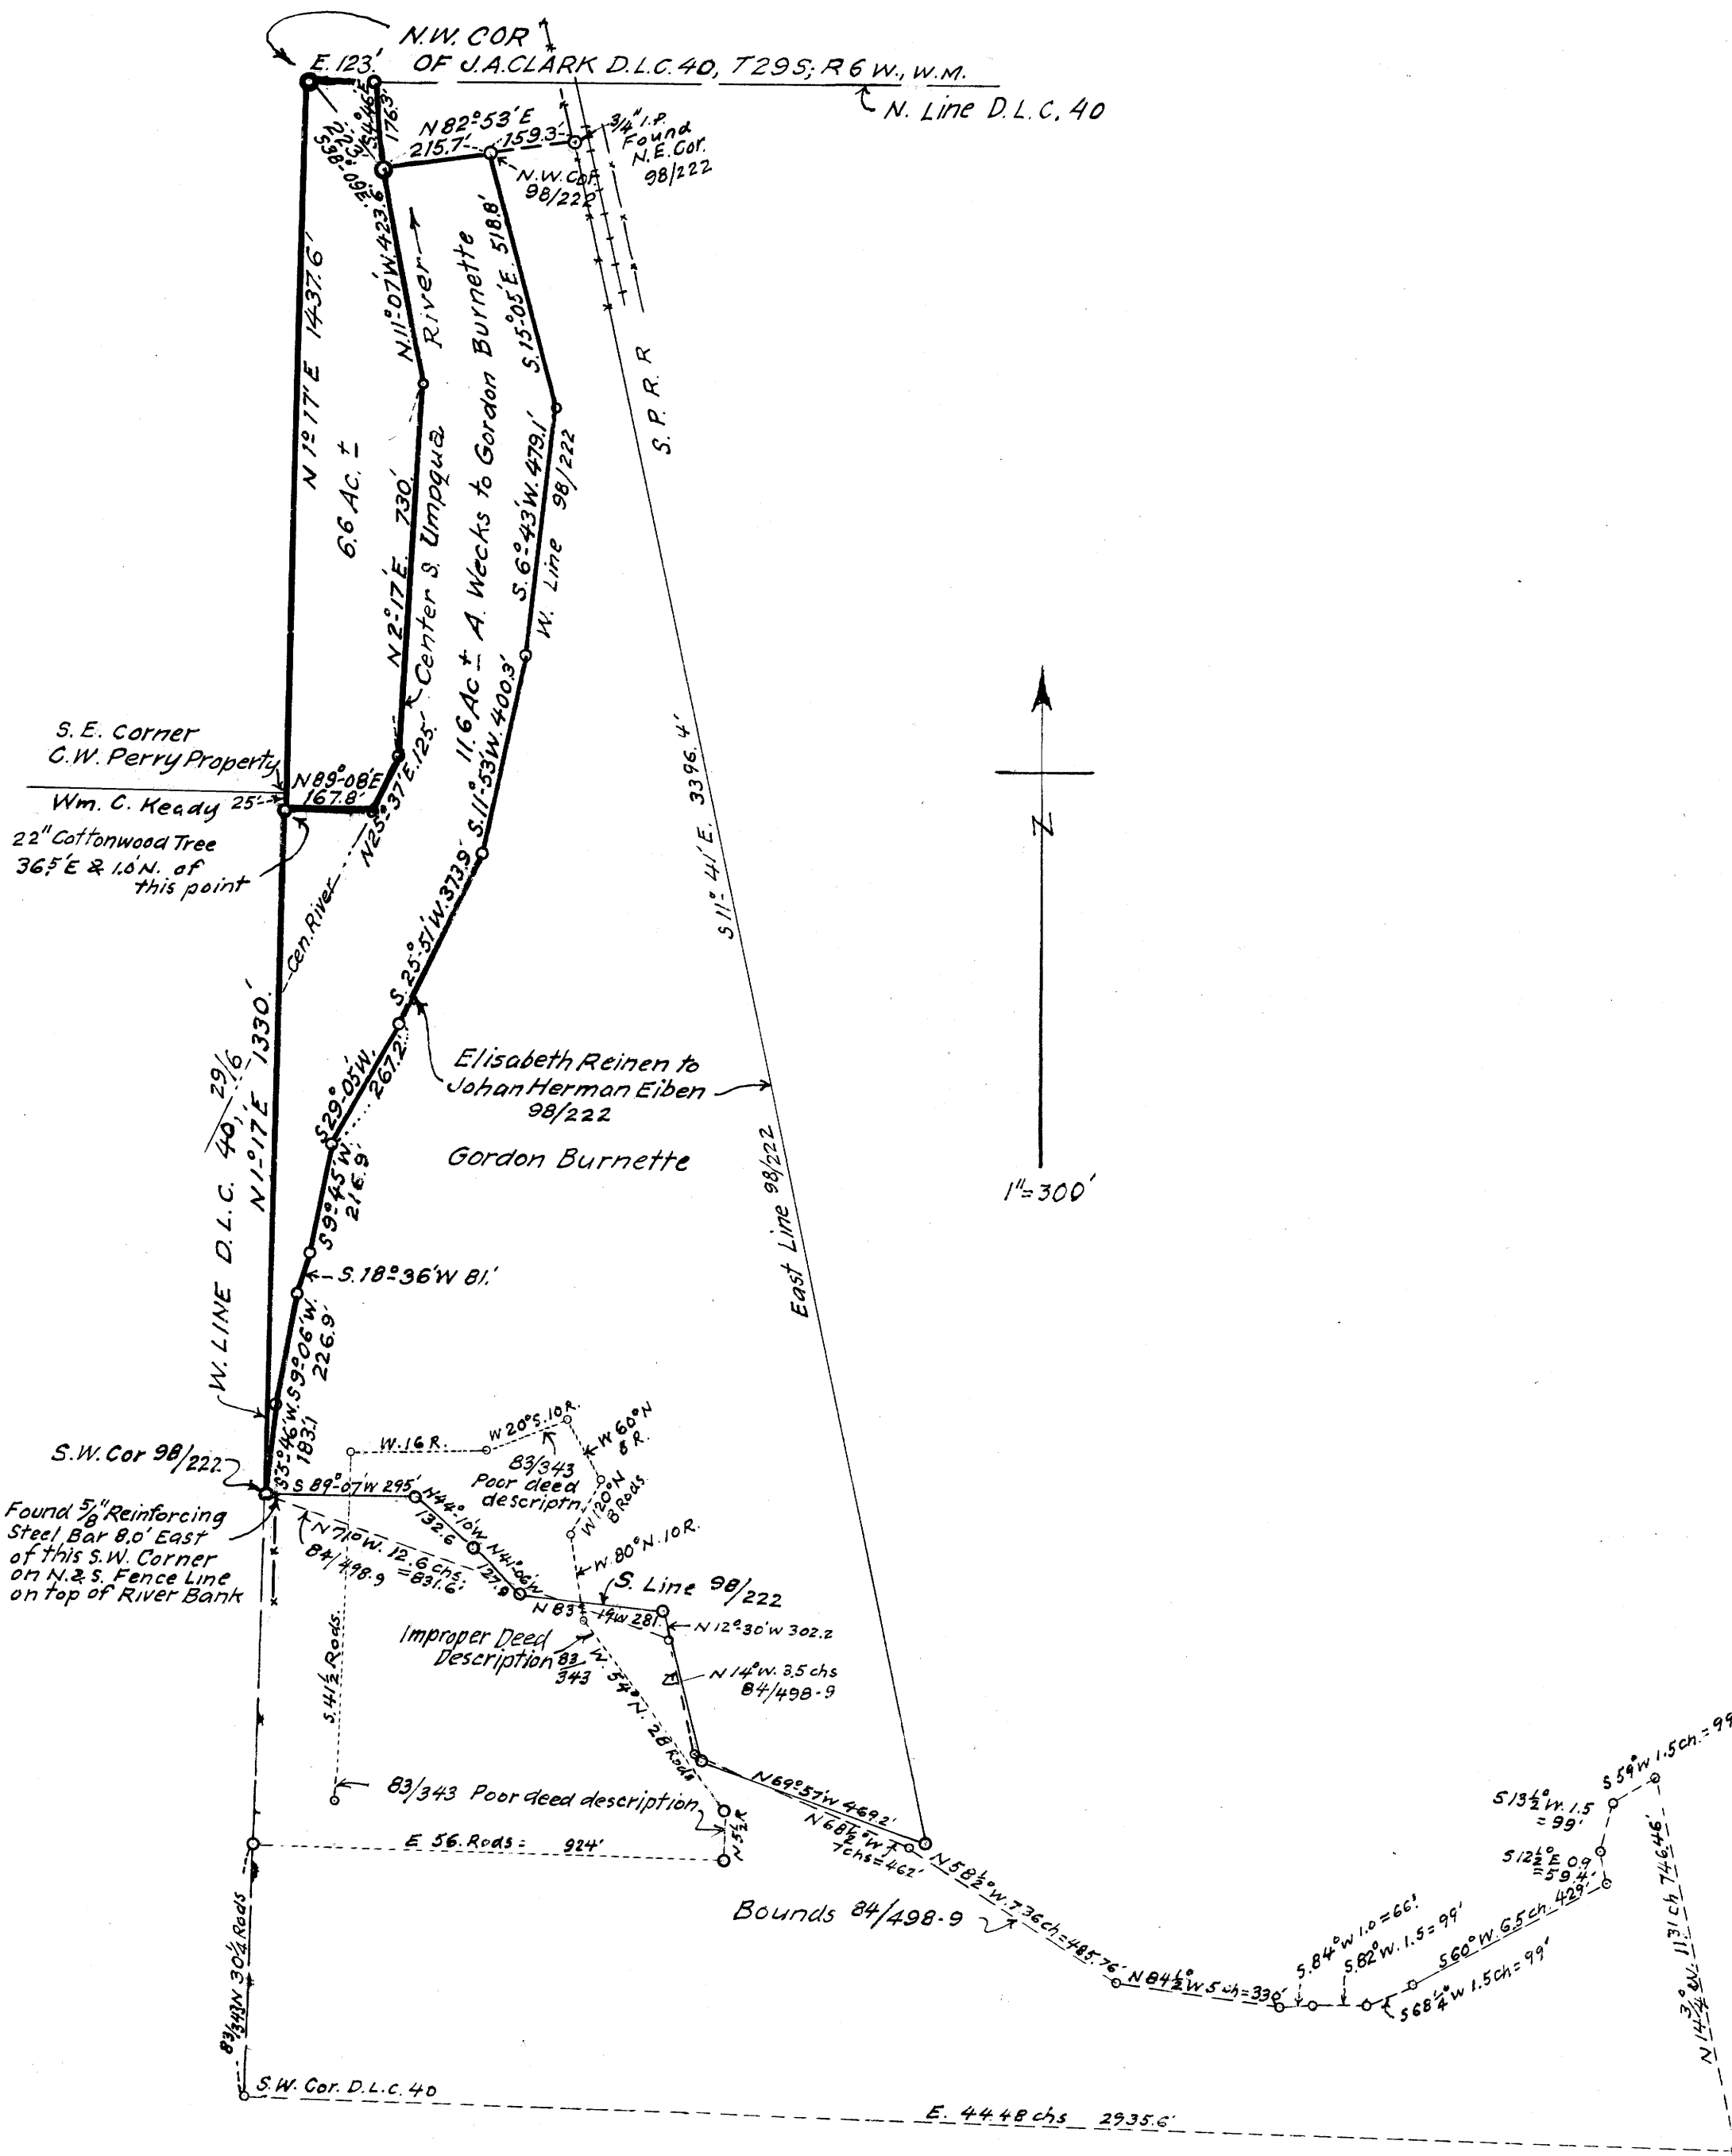

FILED *L.L.*  
RECEIVED  
AUG 9 1963  
COUNTY SURVEYOR  
DOUGLAS COUNTY, ORE.

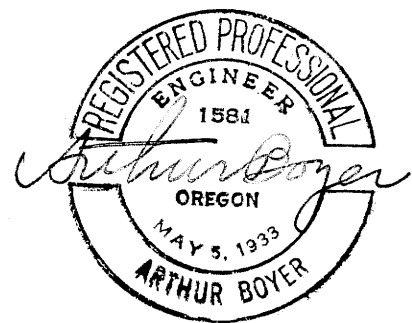

PORTION OF ARTHUR WECK'S PROPERTY  
IN J.A. CLARK D.L.C. 40, IN SEC. 2, T.29S; R.6W; WIL. MER.  
OCT. 1953  
*Ar Boyer*  
1" = 300'