



MAP FILE M 26 T 38


MAP FILE M 26 T 38

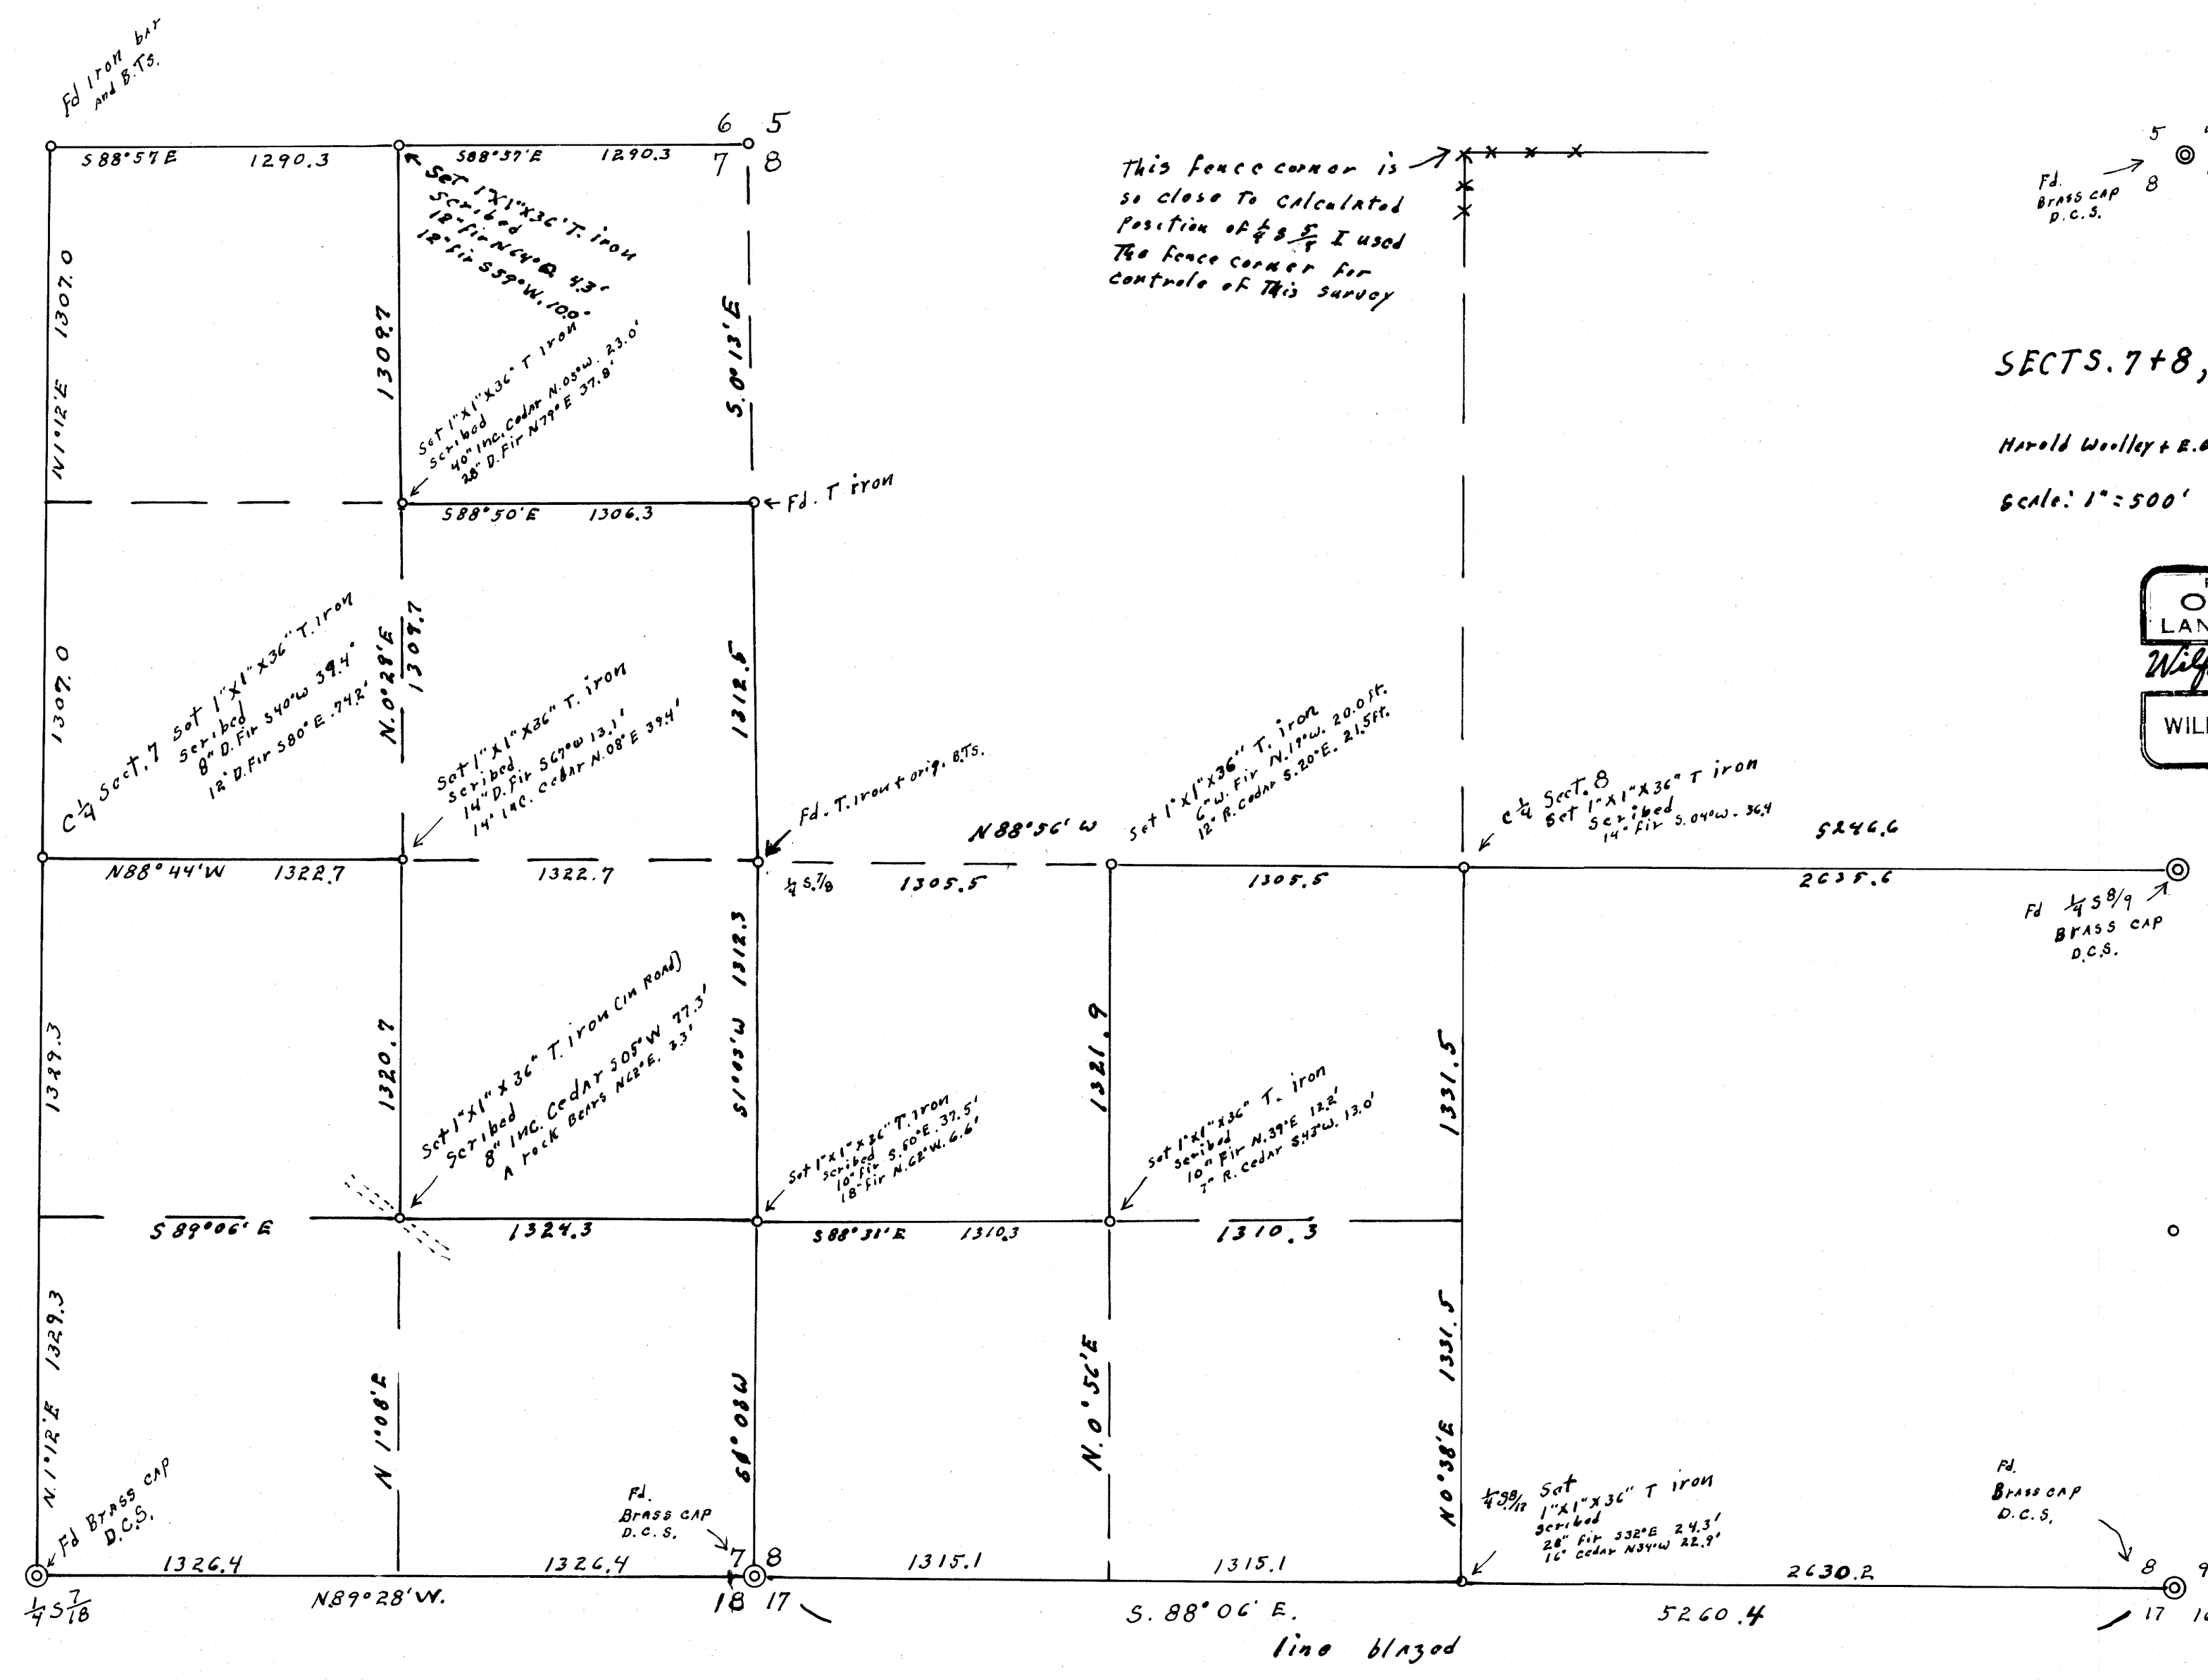

This fence corner is so close to calculated position of $\frac{1}{4}$ S. E. I used the fence corner for control of this survey

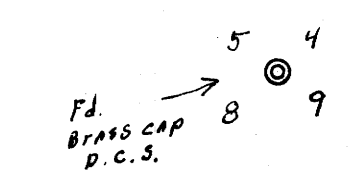

SECTS. 7+8, T. 23 S., R. 4 W. W.M.
 For
 Harold Woolley & E.O. Whipple A-11 Drain
 Scale: 1" = 500' 1963

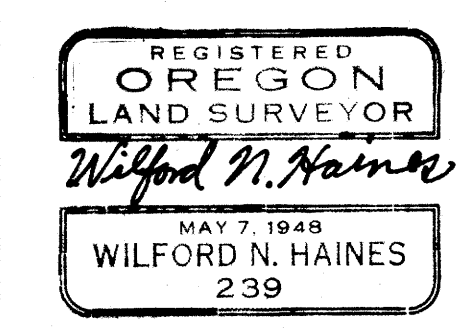

FILED *L.L.*
 RECEIVED
 AUG 26 1963
 COUNTY SURVEYOR
 DOUGLAS COUNTY, ORE.

Fd. N.E. BT. only burned set 1"X1"X36" T. iron
 $\frac{1}{4}$ S. E.

Fd. $\frac{1}{4}$ S. E. BRASS CAP D.C.S.

Fd. BRASS CAP D.C.S.

Fd. BRASS CAP D.C.S.

$\frac{1}{4}$ S. E.

$\frac{1}{4}$ S. E.

M 26 T 38