
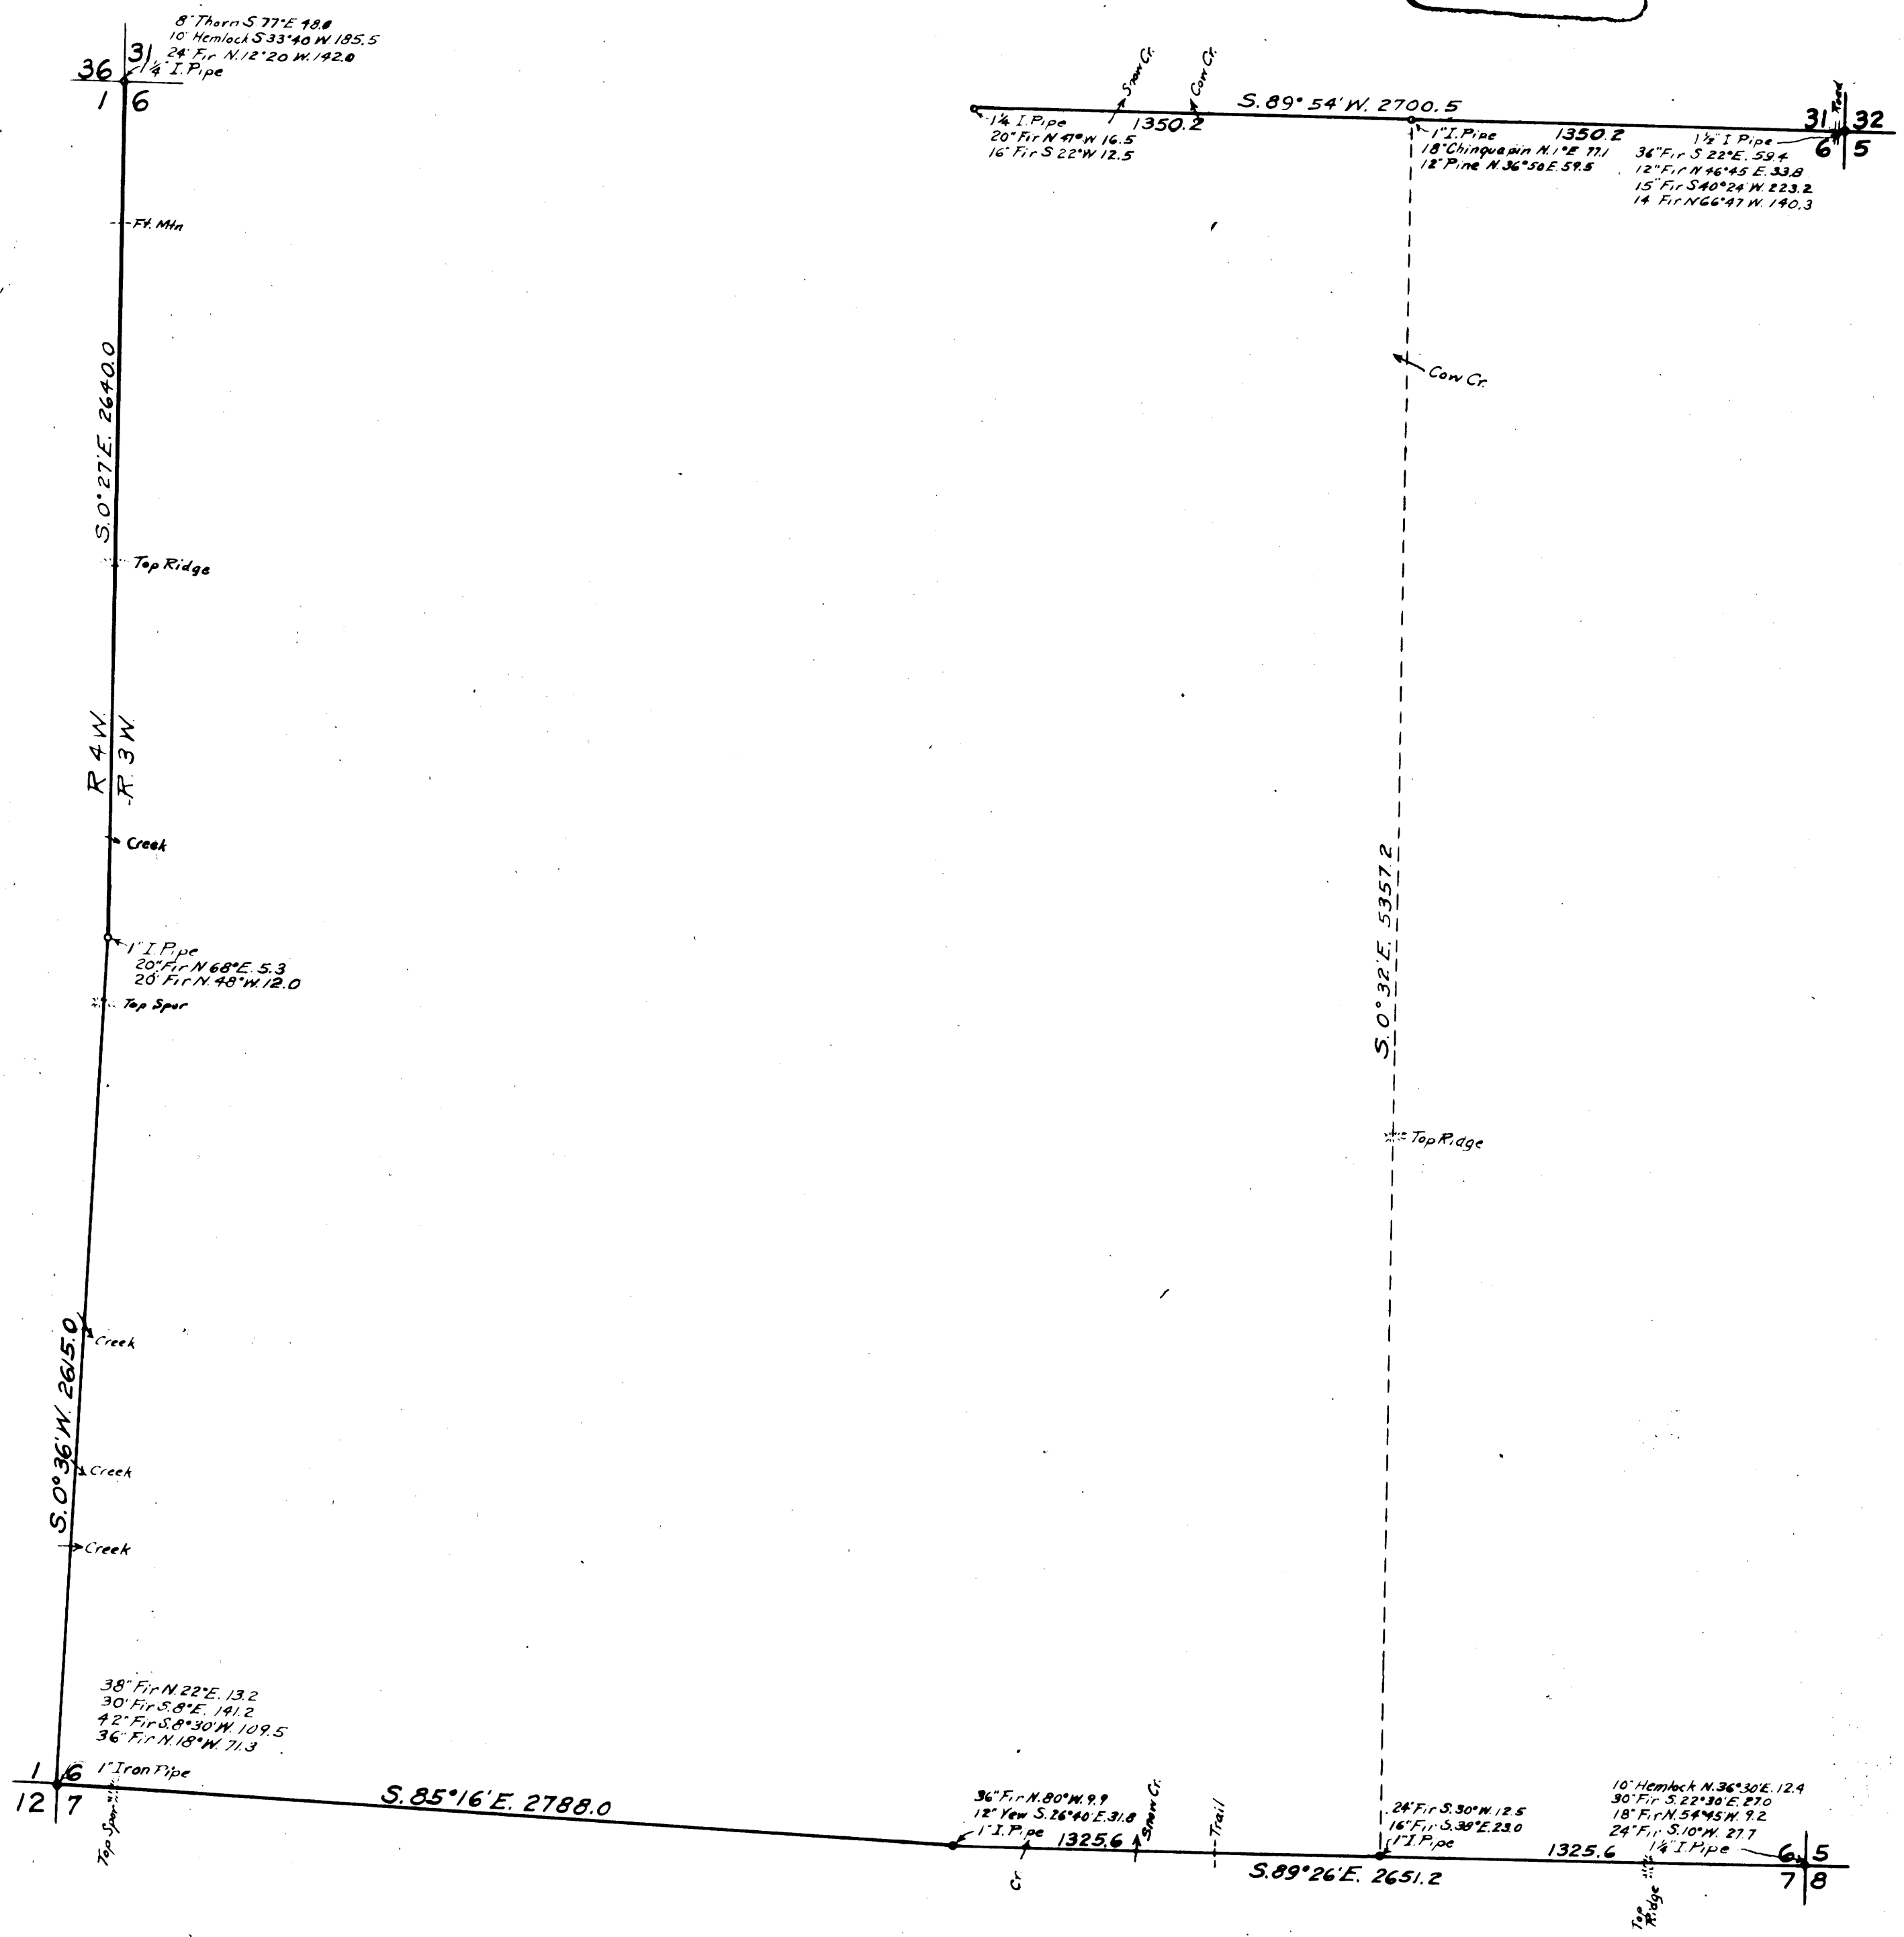


COUNTY SURVEYORS FILE DATA
DO NOT REMOVE FROM OFFICE

COUNTY SURVEYOR'S OFFICE
DOUGLAS COUNTY, OREGON
Surveys in
SECTION 6, T. 32 S., R. 3 W. W.M.

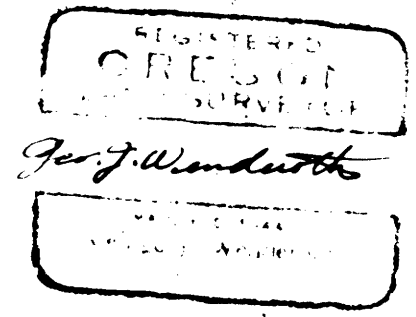

THIS TRACING PREPARED BY "PHOTOLINE"
PROCESS, FROM PRINT ON FILE IN THIS OFFICE.
AND I HEREBY CERTIFY THAT IT IS AN EXACT
COPY OF SAID PRINT.

JAN. 9, 1964
DATE

Fred M. Darby
FRED M. DARBY
COUNTY SURVEYOR.