


C.S. File 51/228  
 Map File M28r56

LOT 51  
 10<sup>25</sup> Acres  
 - 0<sup>25</sup> Acres = Road  
 9<sup>75</sup> Acres

LOT 57  
 11<sup>35</sup> Acres  
 - 0<sup>25</sup> Acres = Road  
 10<sup>25</sup> Acres

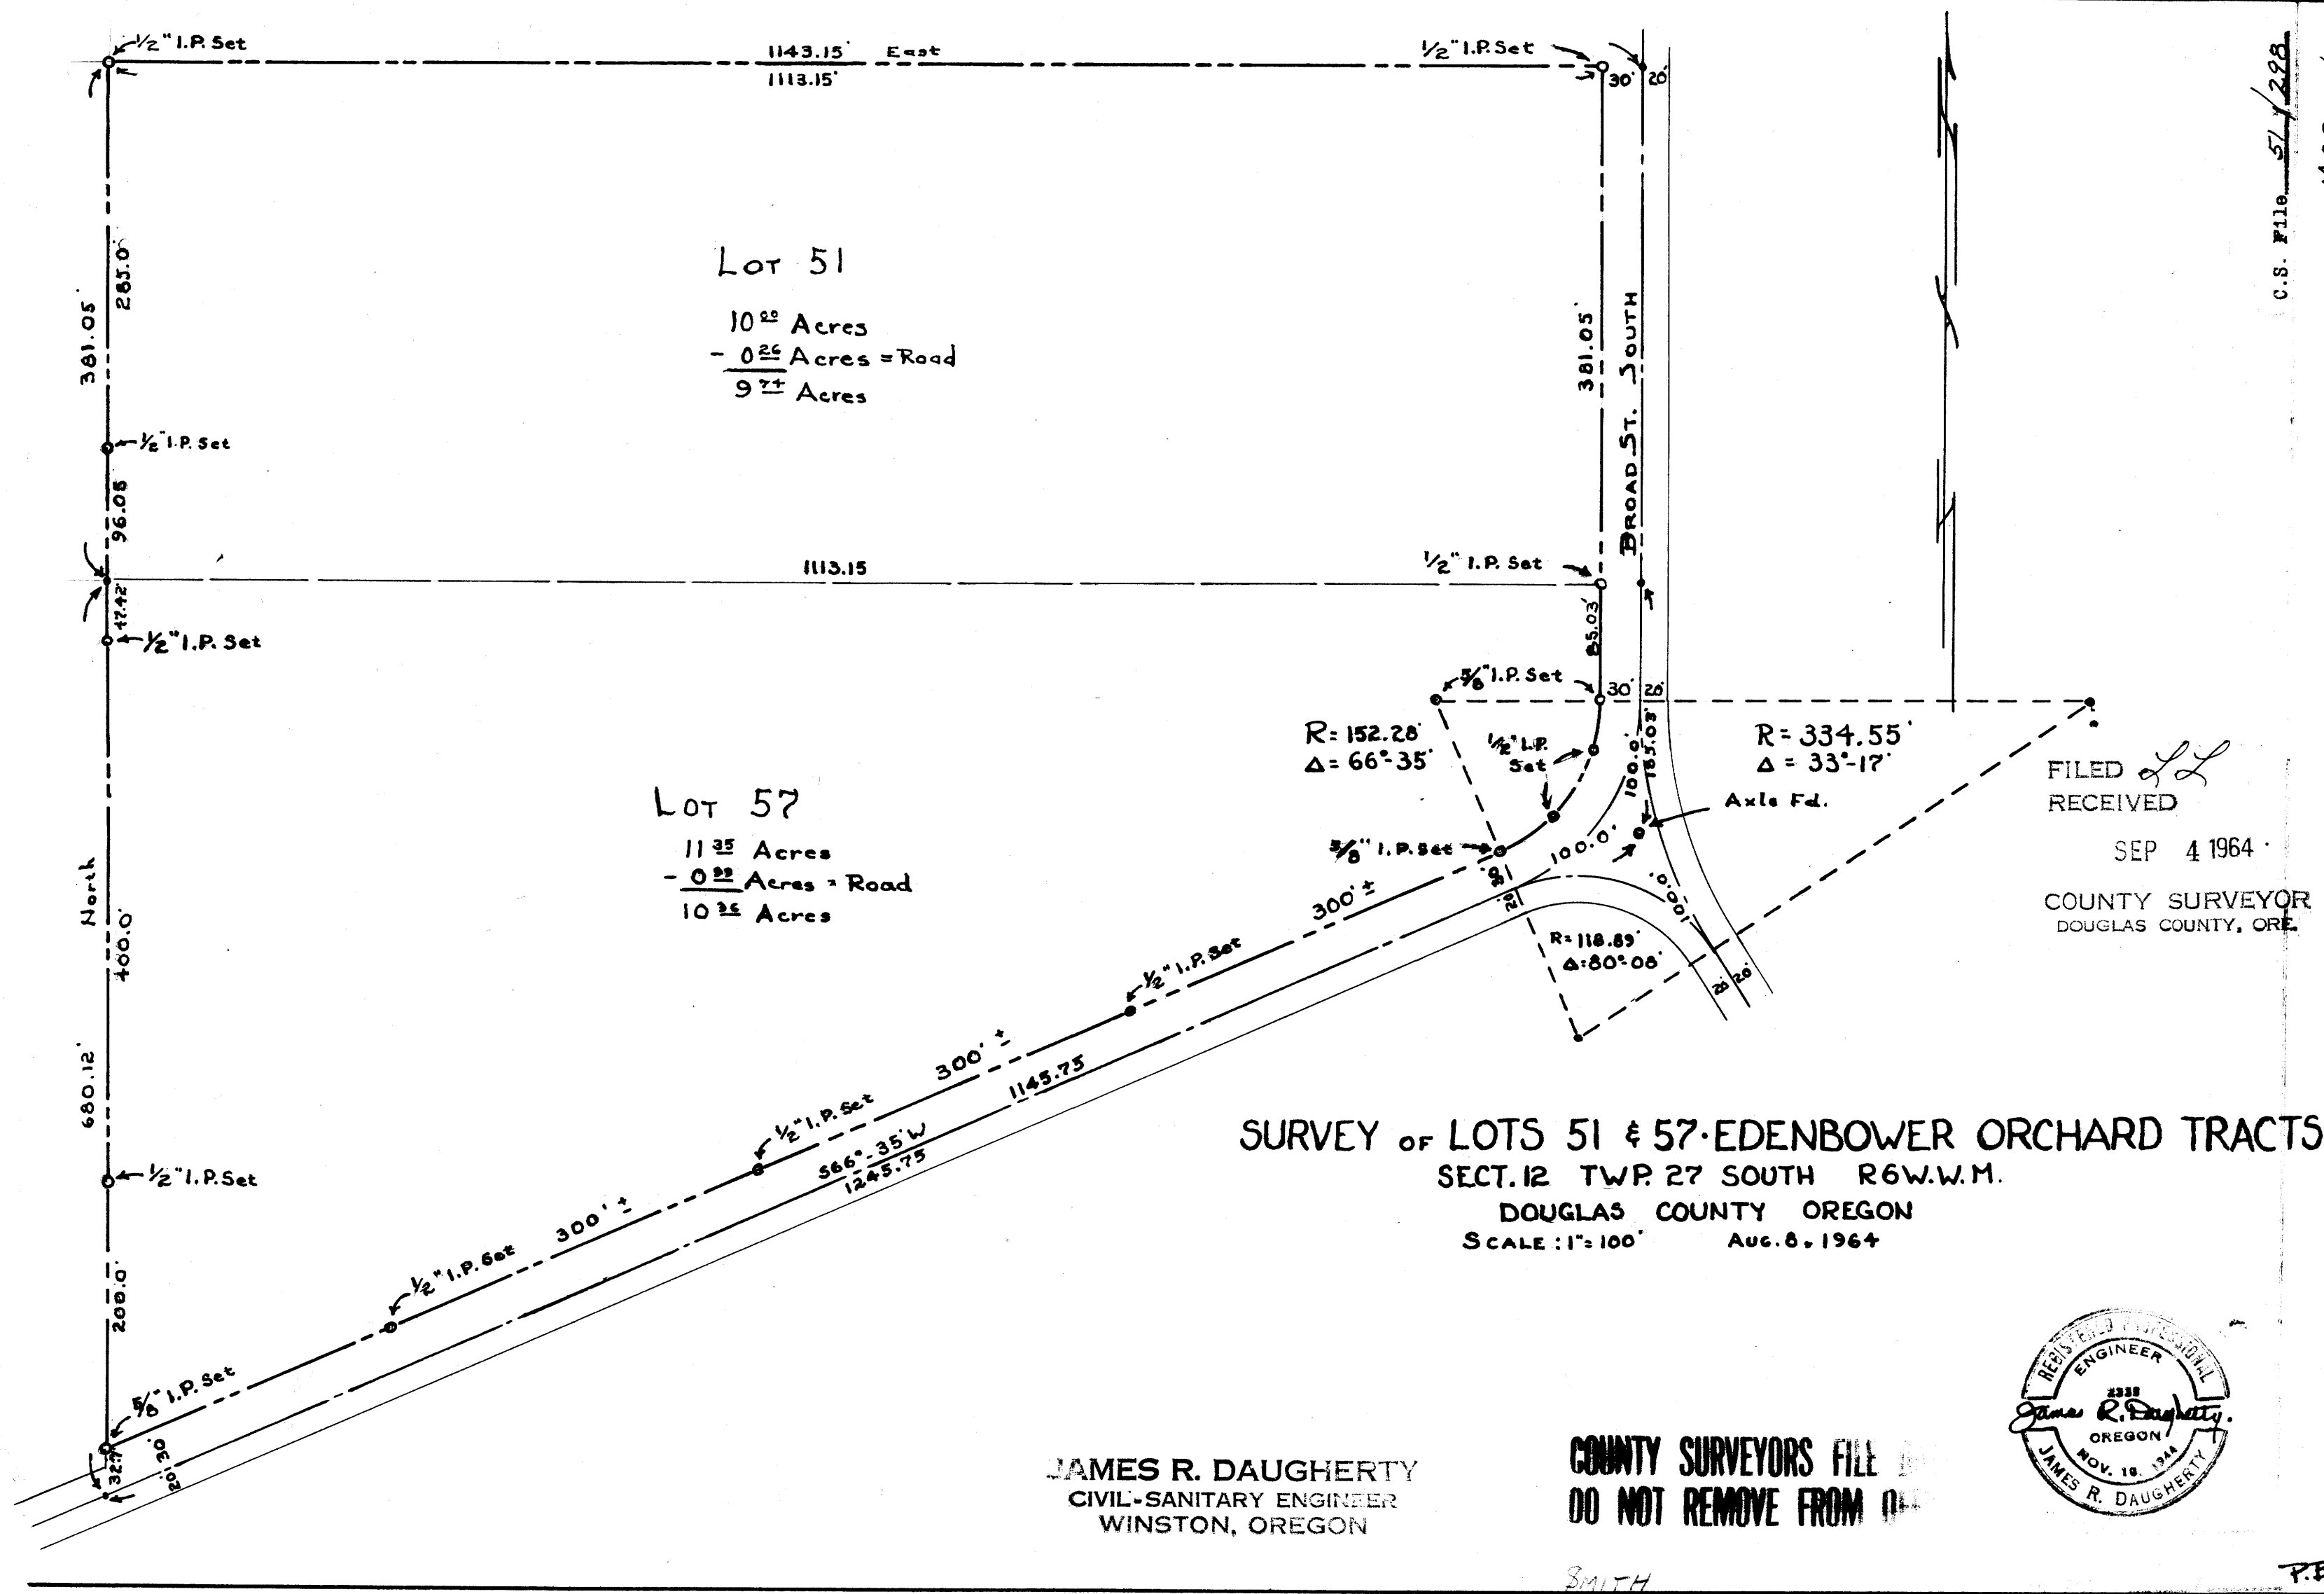


FILED *LL*  
 RECEIVED  
 SEP 4 1964  
 COUNTY SURVEYOR  
 DOUGLAS COUNTY, ORE.

SURVEY OF LOTS 51 & 57 - EDENBOWER ORCHARD TRACTS  
 SECT. 12 TWP. 27 SOUTH R6W.W.M.  
 DOUGLAS COUNTY OREGON  
 SCALE: 1" = 100'      Aug. 8, 1964

JAMES R. DAUGHERTY  
 CIVIL-SANITARY ENGINEER  
 WINSTON, OREGON

COUNTY SURVEYORS FILE  
 DO NOT REMOVE FROM FILE

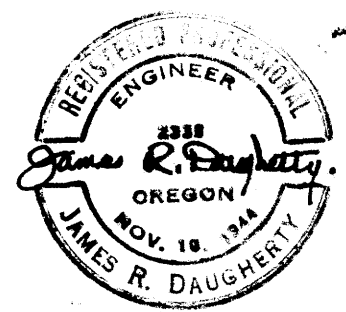

SMITH

PR

