


REMOVE FROM OFFICE

SURVEY FOR DEED DESCRIPTION
SECTION 21, T22S., R.7W W.M.
WILLIAM HANCOCK D.L.C. # 45
Scale: 1" = 400' **MAY 22, 1964**

o SET T. irons

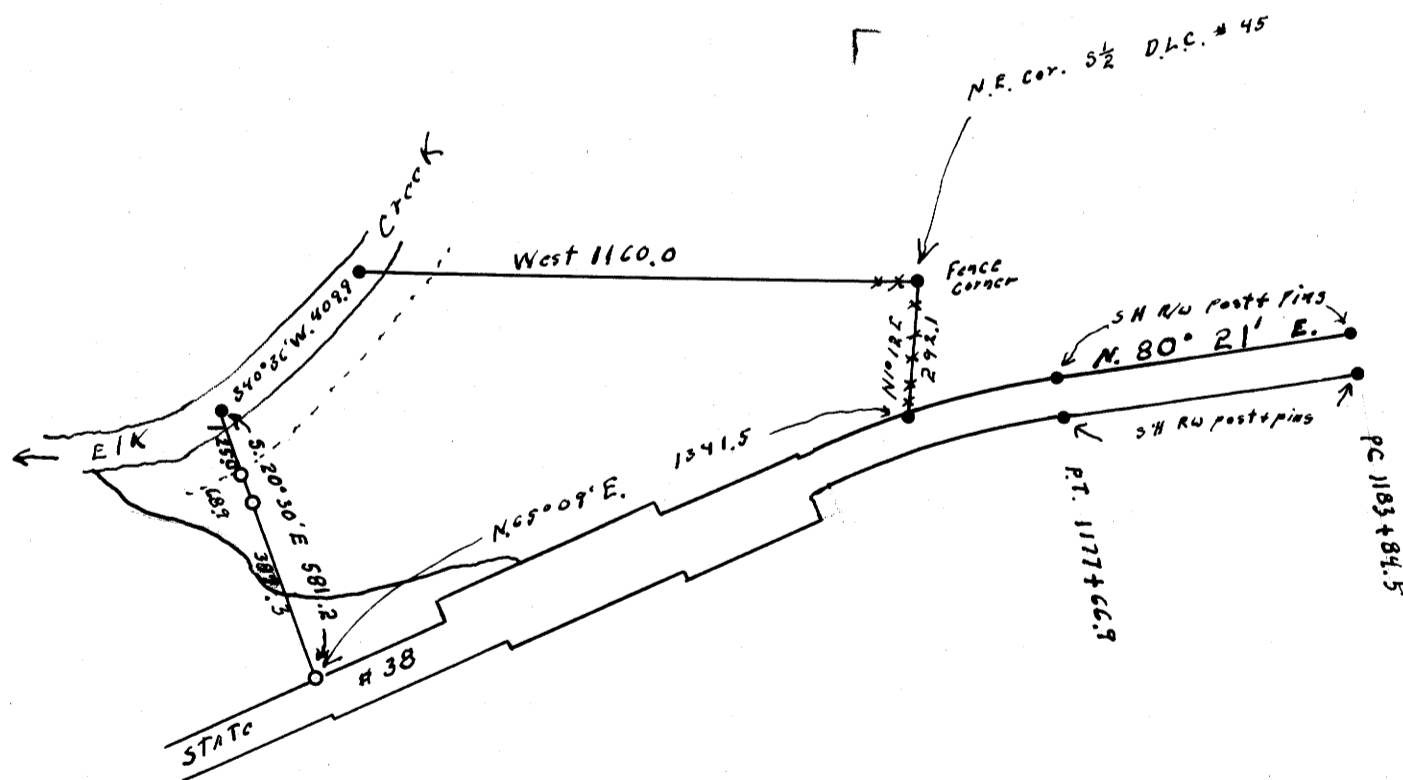

REGISTERED
OREGON
LAND SURVEYOR

MAY 7, 1964
WILFORD N. HAINES
239

FILED
RECEIVED

JUN 1 1964

COUNTY SURVEYOR
DOUGLAS COUNTY, ORE.

For Leslie Hancock - Elkton, Oregon