

~~RECORDS FILE DAT.~~  
~~REMOVE FROM OFF!~~

# SURVEY FOR DEED DESCRIPTION SECTION 17, T.22S., R.5 W. W.M. OREG.


For

Mrs. Sallie J. Farley

Drain Oregon

MAY 29, 1964

Scale 1" = 60'

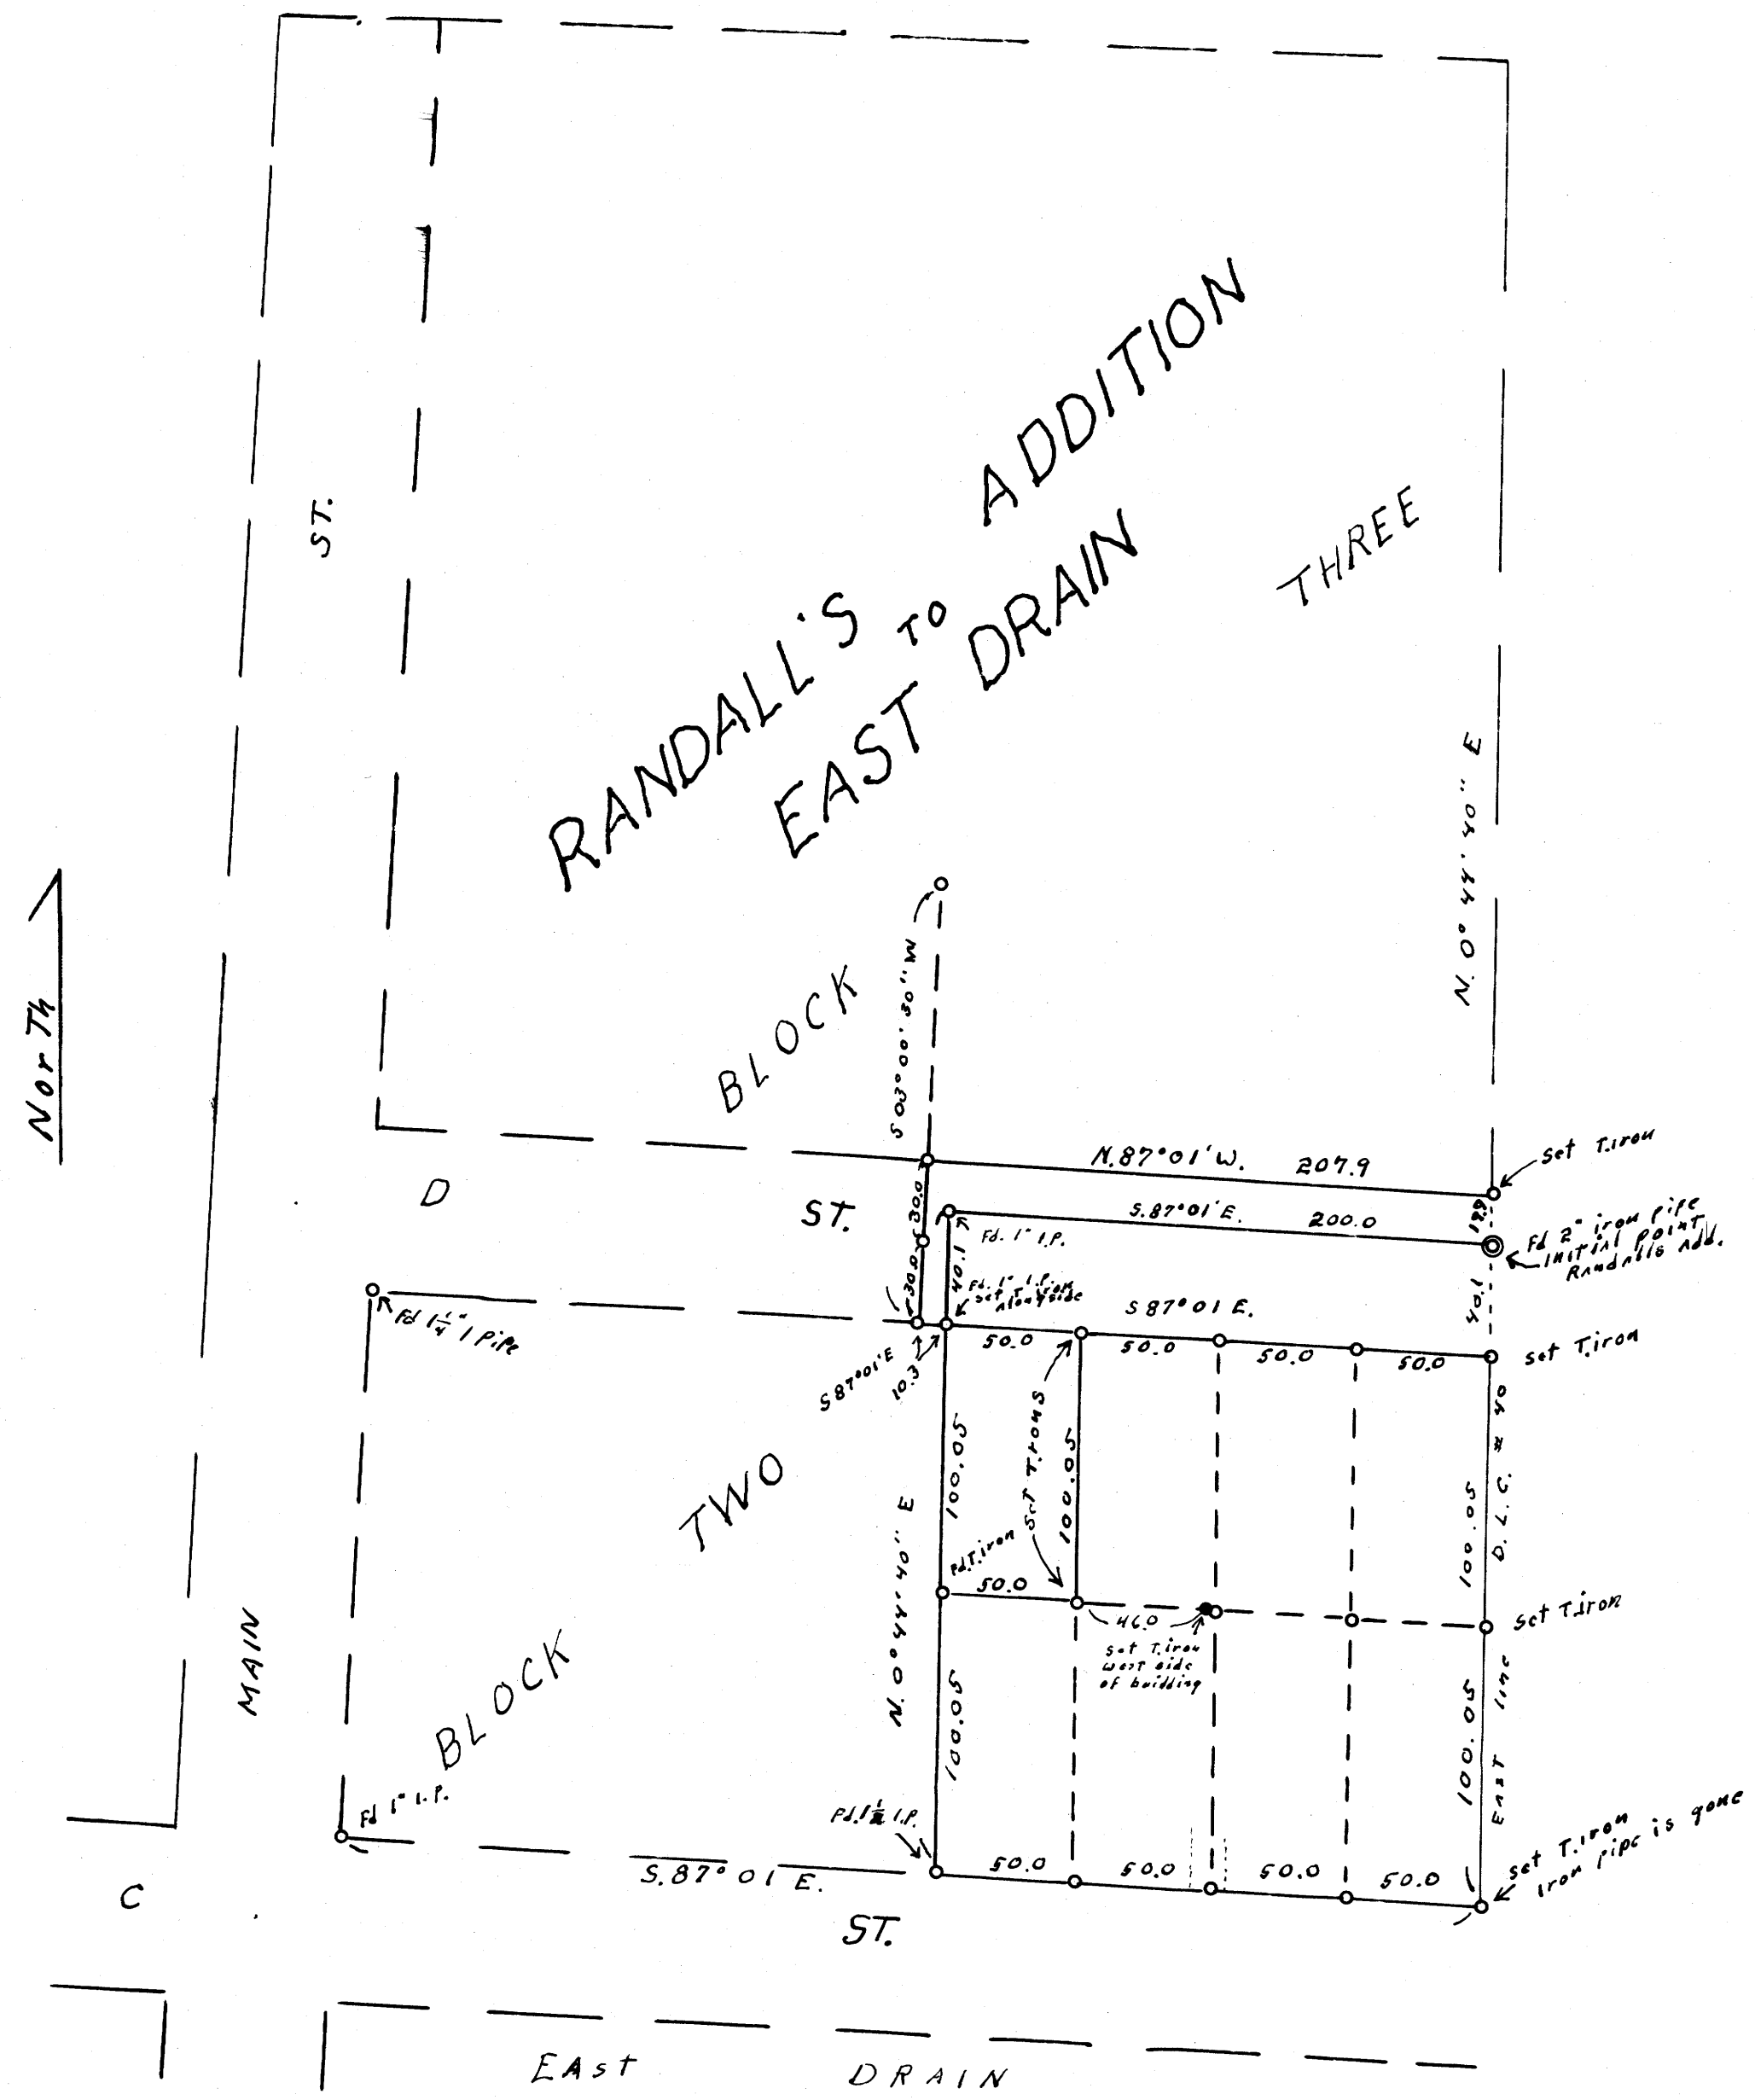

REGISTERED  
**OREGON**  
 LAND SURVEYOR  
*Wilford N. Haines*  
 MAY 7, 1948  
**WILFORD N. HAINES**  
 239

FILED *LL*  
RECEIVED

JUN 1 1964

COUNTY SURVEYOR  
DOUGLAS COUNTY, ORE.